

39°45'00"

Latitude

80°27'30"

Longitude

+
2.21s
1.33w

Topo Location

7.5' Loc. _____ 15' Loc. _____
_____ (calc.) _____

Company Browns Run Gas Co

Farm Nancy Gump #1

15' Quad _____
(sec.)

7.5' Quad Hundred

District Clay


WELL LOCATION PLAT

County 103 **Permit** 30108

30108

Clay dist

John Kedy

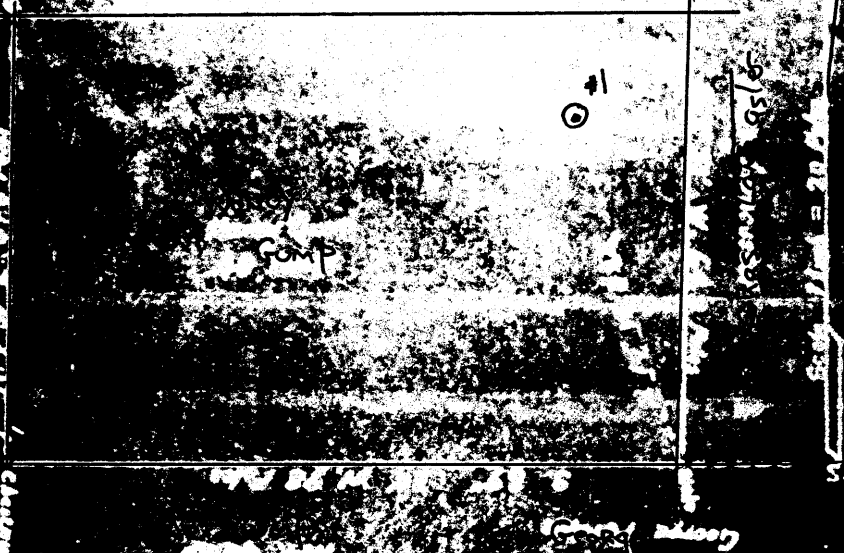

I, the undersigned, hereby certify that the foregoing and show all the information, to the best of my knowledge and belief, required by the Oil and Gas Section of the Department of the Interior.

Witness my hand and seal this 26th day of April 1942.

Acknowledged before me, a Notary Public for the State of Virginia, this 26th day of April 1942.
My Commission expires January 14, 1944.

John Kedy
Notary Public

Clay	Dark			
Shale				
Rock	White			
Slate	Dark			
Lime	White			
Sand				
Slate	Dark			
Lime	White			
Clay				
Slate	Dark			
Clay	Light			
Lime	White			
Slate	Dark			
Lime	White			
Slate	Gray			
Lime	White			
Slate	Dark			
Lime	White			
Slate	Dark			
COAL	Black			
Shale	Dark			
Lime	White			
Shale	Dark			
Lime	White			
Slate	Dark			
Lime	White			
Slate	Dark			
Lime	White			
Shale	Gray			
Lime	White			
Shale	Gray			
Lime	White			
.	.			
.	.			
Slate	Dark			
Lime	White			
.	.			
Slate	Dark			
PIGIRON				
COAL	Black			
Lime	White			

TOTAL DEPTH

1063-23