

39° 42' 30"

Latitude

+  
.43s  
2.20w

80° 28' 30"

Longitude

Topo Location

7.5' Loc. \_\_\_\_\_ 15' Loc. \_\_\_\_\_  
(calc.) \_\_\_\_\_

Company ManuPact Lt + HT

Farm Hannah Butcher Mrs #1463 + #543  
MLH UGO

15' Quad \_\_\_\_\_  
(sec.)


7.5' Quad Hundred

District Church

**WELL LOCATION PLAT**

County 103 Permit 30111

Church dist

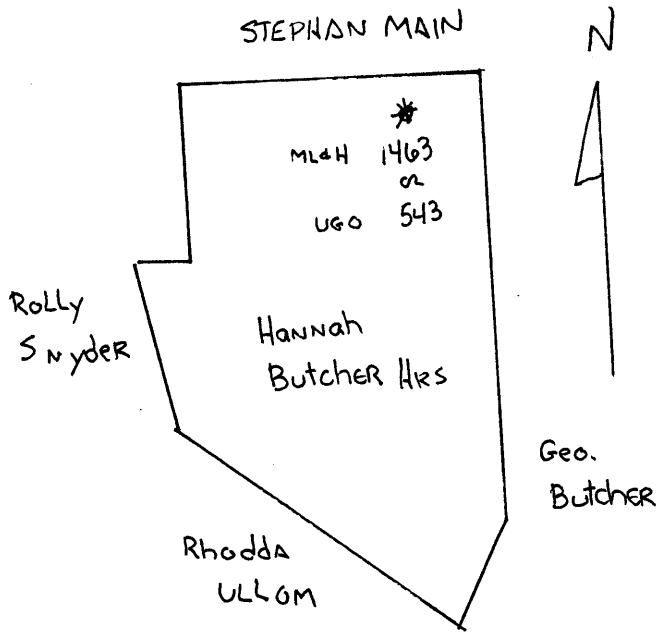

Name	...	...	...
Balltown			
Pgh. Coal			
Murphy Sand			
Little Dunbar			
Big Dunbar			
Gas Sand			
Salt Sand			
Secon: Salt Sand			
Manon Sand			
Oil at			
Big Line			
Pig Injun			
MS Gas at			
50-Ft. Sand			
Stray Gordon			
Gordon			
Fourth			
1st Pay Oil at			
2nd Pay Oil at			
Total depth			

2000  
 Well No. 100-100-1  
 Date  
 From  
 To  
 100  
 100

