

39° 37' 30"

Latitude

80° 32' 30"

Longitude

1.88s
76w

Topo Location

7.5' Loc. _____ 15' Loc. _____
_____ (calc.) _____

Company Carnegie Nat Gas

Farm Sarilda Stoneking # 542

15' Quad _____
(sec.)

7.5' Quad Big Run

District GRANT

WELL LOCATION PLAT

County 103 **Permit** 30119

ANNEXE N° 1000

Baril's Flooding

Annex 1000

Located in Grant

Baril's

West Virginia Littleton A. A.

Quadrangle


W. A. R. No. 502

Date

1911

Project of the U.S. G.S.

Scale 1:50,000

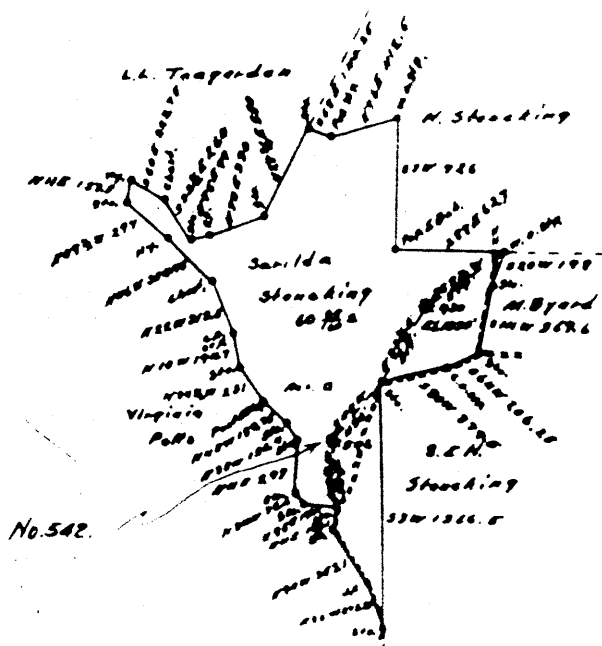

I, the undersigned, hereby certify that this map is correct and shows all the shafts to the best of my knowledge and is as required by the Act of Congress and the Mining Laws of the United States.

[Handwritten signature]

Name	1935	1936	1937	
Conductor				
Mapleton Coal	1085	1084	47	
Pittsburgh Coal	1148	1084	0	
Murphy Sand	1770	1786	56	
Big Dunkard	1610	1644	38	
Gas Sand	1775	1610	38	
1st Salt Sand	1638	1800	67	
2nd " "	1938	1870	77	
Little Line	2340	2348	8	
Penoil Cave	2348	2350	2	
Big Line	2350	2432	82	
Big Injun	Gas at 2440	2432	2622	190
Gordon Stray	3185	3220	35	
Gordon Sand	3257	3300	50	
4th Sand	Gas at 3331	3328	3343	16
Bayard Sand	3538	3540	2	

3600

Wells was ...

Batt
Front water ...

Wells was ... from ...

STATE OF WEST VIRGINIA
DEPARTMENT OF MINES AND METALLURGY
DIVISION OF MINING
AFFIDAVIT TO BE MADE IN TESTIMONY OF THE FACTS TO BE MADE BY REGISTERED COALS OF THE DEPARTMENT AND NOT TO BE OBTAINED BY THE OPERATOR AND THE TRUE COPY (AND EXTRA COPIES) IS REQUIRED TO BE MAILED TO EACH COAL OPERATOR ABOVE NAMED AT THEIR RESPECTIVE ADDRESSES.

AFFIDAVIT

STATE OF WEST VIRGINIA

COUNTY OF Netzel

Sarrah W. H. Hain and Samuel B. Masten
being first duly sworn according to law depose and say that they are experienced in the work of plugging and filling oil and gas wells and were employed by Carroll's Nat. Gas well operators and participated in the work of plugging and filling the above well, that said work was commenced on the

1 day of August 1934, and that the well was plugged and filled the following manner:

Manner in which said well was plugged: Filled with clay to 2600' cement from 2190' to 2400', sealing Jordan Stray, Gordon & Fourth Sands. Filled clay from 2190' to 2400', set 6" solid wood plug at 2400' sealing Big Inj. Filled with clay from 2400' to 2013' and shot 6-3/4" Csg off at 2013' and pulled. Filled with clay from 2013' to 1620'. Set 8" solid wood plug at 1620' sealing and Salt Sands. Filled with clay from 1620' to 1210'. Shot 8" Csg at 1210' and not pull. Filled with clay from 1210' to 1121'.

Manner in which coal was plugged: Filled with cement from 1182' to 1121' this 20' below to 20' above Pittsburgh Coal. Filled with clay from 1121' to 1120'. Set Csg off at 1120' and pulled string out. Filled with clay from 1120' to 1080'. Filled with cement from 1080' to 1030'. Set Csg 30' below to 20' above the coal. Filled with clay from 1030' to 1000'. Set 6" solid wood plug at 1000'. Pulled string out and filled from 1000' to top of surface with clay.

Low dipose of instrument: 11-11-34
11-11-34
11-11-34

THE ABOVE AFFIDAVIT IS FILED FOR RECORD IN THE OFFICE OF THE REGISTER OF DEEDS OF THE COUNTY OF Netzel ON THE 5 day of Oct 1934.