



PITTSBURGH WVA. GAS

COMPANY OF

PITTSBURGH, PA.

LEAS 3504

LESSOR R.M. WHITE

ACRES 101

DIST CHURCH

COUNTY

WHEELING

STATE W.VA.


QTR 30 ANGLE MANNINGTON N.W. 3/4 DATE JUNE 16 1954

NO ON LEASE 2

LEAS 1234567890 RESERVATION

ELEVATION 1074'-L

S.S. TEASBARDEN

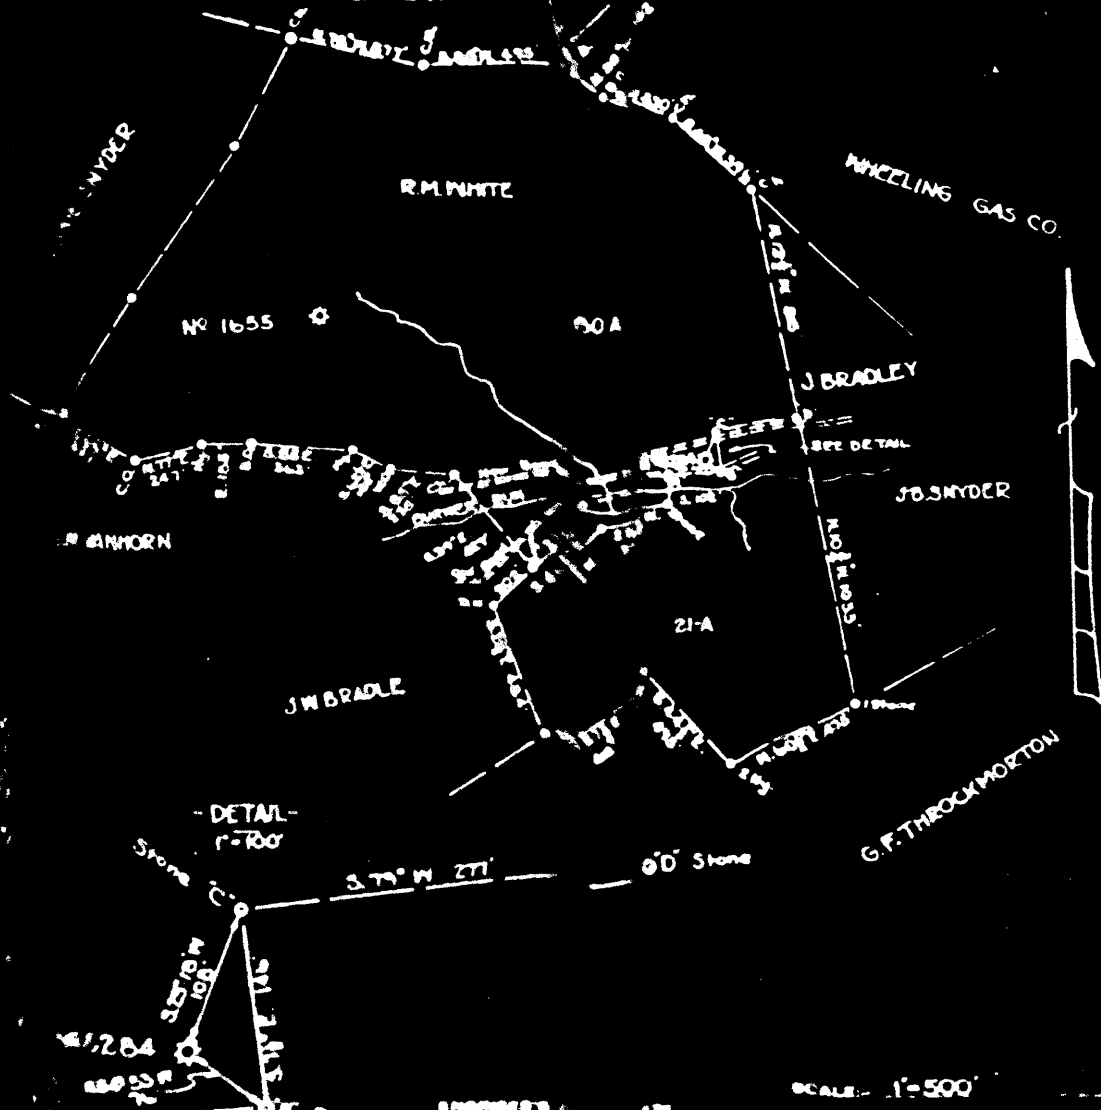

I hereby certify that this map is correct and all the information to the best of my knowledge and belief is true and correct.

James D. Jefferson

