



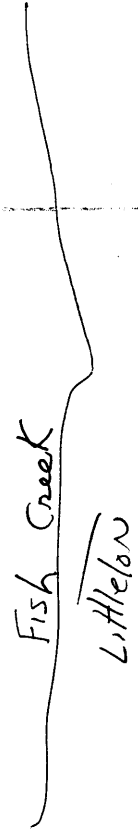

30195

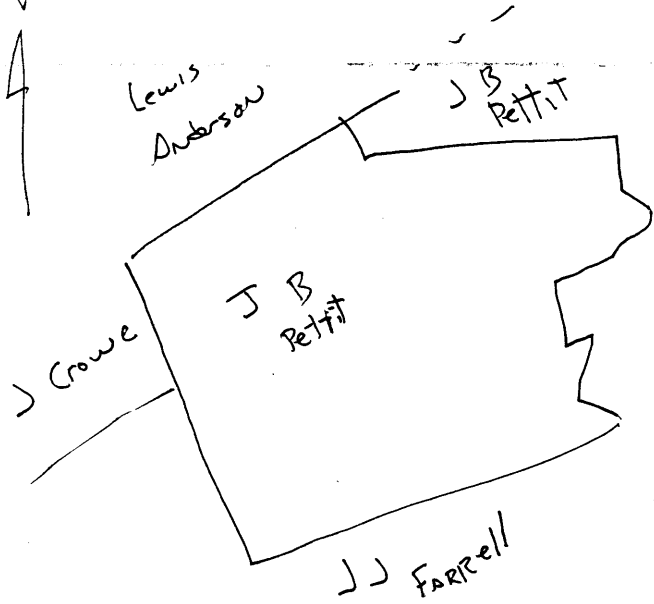

Section	Start	End	Feet	Total
Slate & Sand	100	100	0	100
Buff Sand	100	100	0	100
Yellowed Sand	100	100	0	100
Slate & Lime	100	100	0	100
Mapletown Red	100	100	0	100
Lime & Slate	100	100	0	100
Pitts. Cos.	100	100	0	100
Lime, Slate	100	100	0	100
Murphy Sand	100	100	0	100
Slate, Lime & Red Rock	100	100	0	100
Big Dunkard	100	100	0	100
Slate, Sand & Slate	100	100	0	100
First Salt	100	100	0	100
Slate	100	100	0	100
Second Salt	100	100	0	100
Slate & Sand	100	100	0	100
Third Salt	100	100	0	100
Slate & Red Rock	100	100	0	100
Little Lime	100	100	0	100
Slate	100	100	0	100
Big Lime	100	100	0	100
Big Injun	100	100	0	100
Slate & Lime	100	100	0	100
Fifty Foot	100	100	0	100
Slate	100	100	0	100
Thirty Foot	100	100	0	100
Slate	100	100	0	100
Strey	100	100	0	100
Pink Rock	100	100	0	100
Gordon	100	100	0	100
Bottom	100	100	0	100
TOTAL DEPTH				3100

shot  
Well was ~~shot~~ at 3095-3098

feet; well was shot at \_\_\_\_\_ feet

Salt  
Fresh water at

salt  
feet; fresh water at \_\_\_\_\_ feet

producing  
Well was \_\_\_\_\_ hole  
dry

April 8, 1884  
Date

Approved

*James H. [Signature]*  
Owner

STATE OF OHIO  
DEPARTMENT OF MINES AND REVENUE

Philadelphia Oil Co.  
Marietta, O., Va.

Vetrol

Well No. 3377

J. E. Petit Heirs

AFFIDAVIT

OHIO

STATE OF ~~OHIO~~

COUNTY OF Washington

J. T. BREWER

and

being first duly sworn according to law depose and say that they are experienced in the work of plugging and filling oil and gas wells and were employed by Israel E. Seaman and participated in the work of plugging and filling the above well that said work was conducted

14th day of April, 1936 and that the well was plugged and filled in the following manner:

Manner in which said well was plugged: Bridged shot hole at 3073 ft. Filled with no material from 3073 ft. to 2960 ft. Sealed hole from 2960 ft. to 2950 ft. Bridged hole Filled with non porous material from 2535 ft. to 2225 ft. Sealed hole from 2225 ft. to 2075 ft. of 6-5/8" casing from hole. Bridged hole at 2075 ft. Filled with non porous material from 2075 ft. to 1970 ft. Sealed hole from 1970 ft. to 1960 ft. Filled with non porous material from 1960 ft. to 1860 ft. Sealed hole from 1860 ft. to 1850 ft. Filled with non porous material from 1850 ft. to 1755 ft. Sealed hole from 1755 ft. to 1745 ft. Bridged hole at 1570 ft. with non porous material from 1570 ft. to 1475 ft. Sealed hole from 1475 ft. to 1465 ft. 1080 ft. of 8" casing from hole. Unable to get balance. Bridged hole at 1038 ft. Filled with neat cement from 1038 ft. to 960 ft., 30 ft. 20 ft. above coal. Filled with non porous material from 960 ft. to 935 ft. Filled with neat cement from 935 ft. to 860 ft., 30 ft. below and 20 ft. above coal. Filled with non porous material from 860 ft. to 715 ft. Filled with neat cement from 715 ft. to 660 ft., 30 ft. below and 20 ft. above coal. Filled with non porous material from 660 ft. to top. Erected marker according to

Description of monument: Concrete pier approximately 3 ft. in height from top with center of pipe extending approximately 5 ft. in ground. Pier set on concrete base 14ft. square by 4 inches thick. Brass disk embedded in concrete on top of pier with inscription: Well No. 3377, J. E. Petit Heirs Farm, abandoned April, 1936 by Israel E. Seaman.  
THE ABOVE DESCRIPTIONS MUST BE IN DETAIL AND IN ACCORDANCE WITH THE PROVISIONS OF SECTION 4, ARTICLE 4, CHAPTER 43 OF THE OHIO CONSTITUTION.  
and that the work of plugging and filling said well was completed on the 14th day of April, 1936

19 36

And under penalty of perjury depose and say that the above is true to the best of their knowledge and belief.