





30218

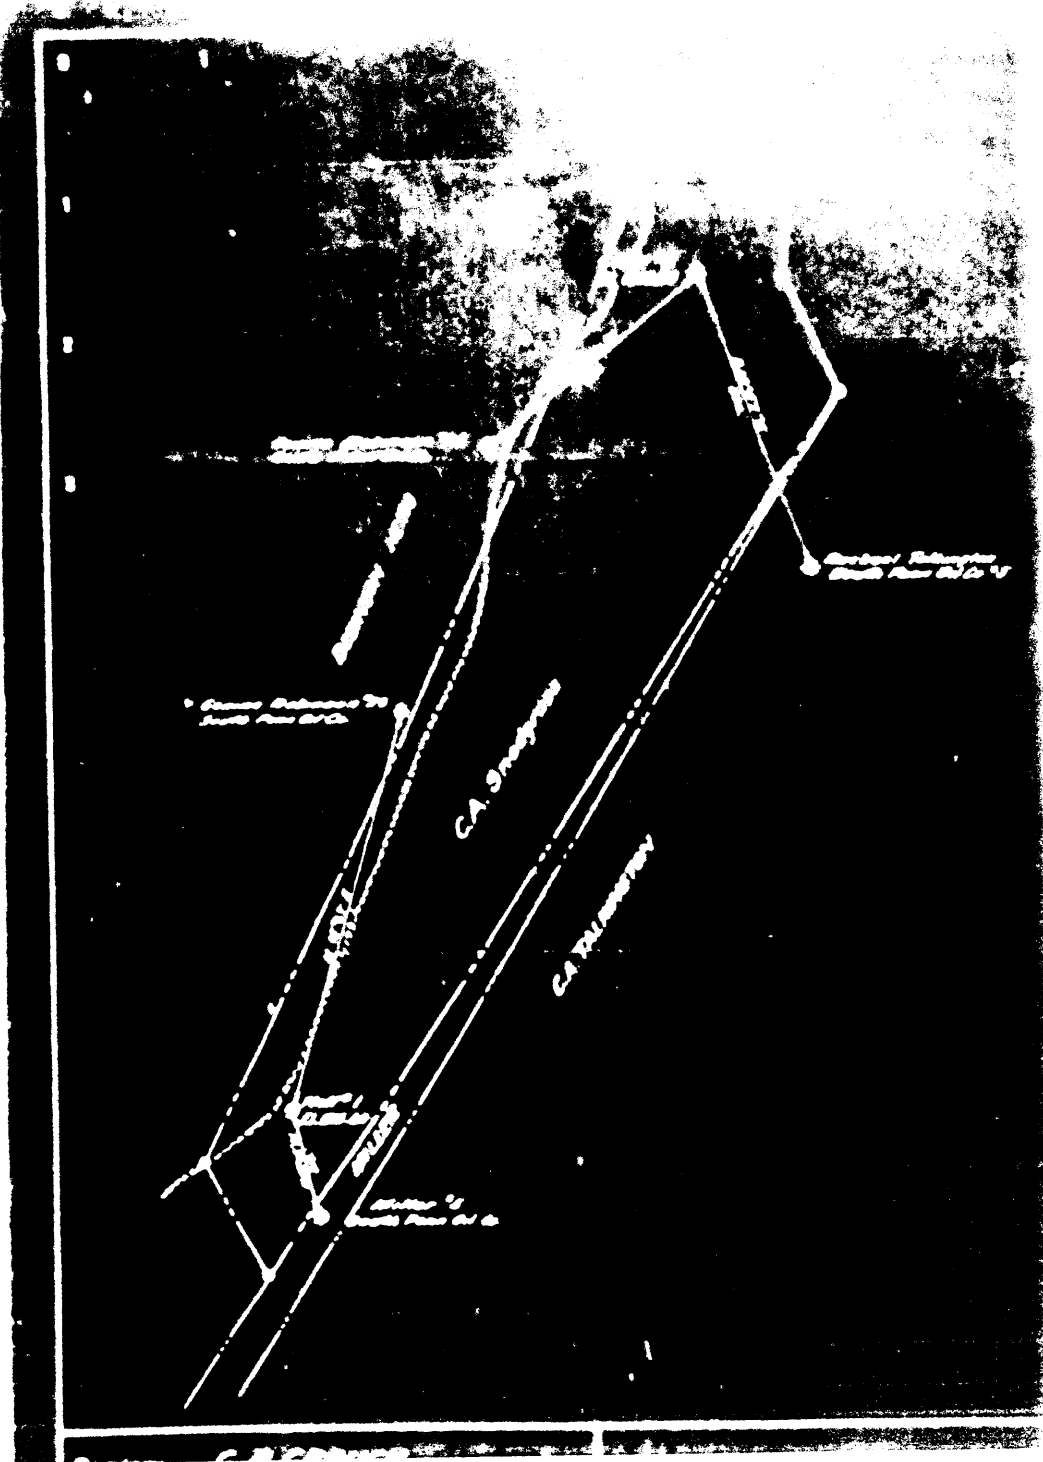

30218

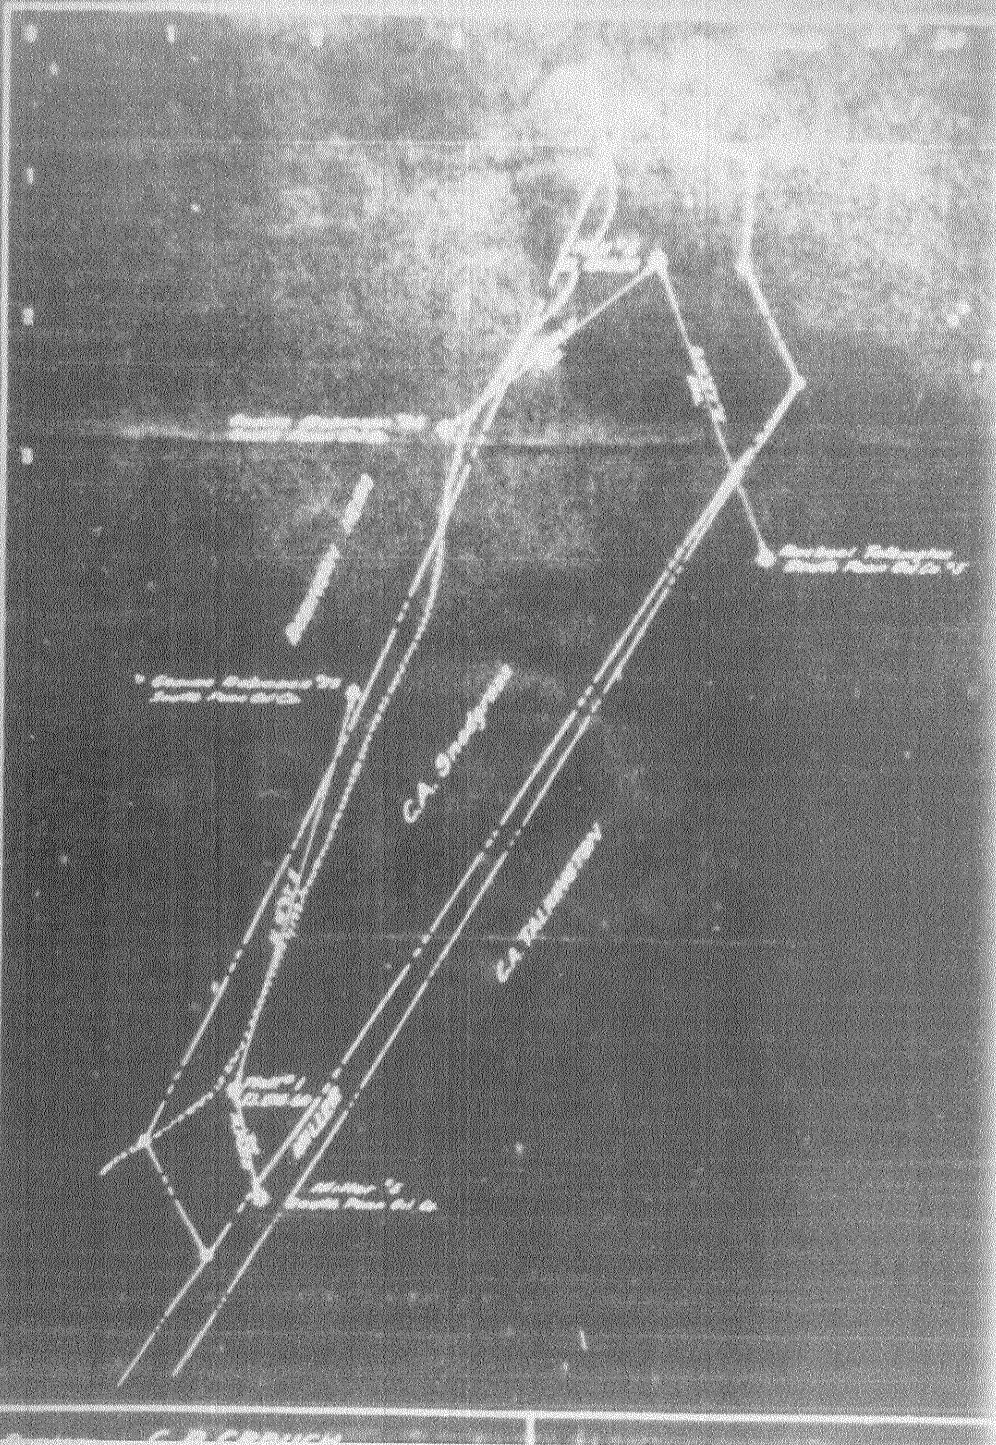

WET - 218 - A

Grant District, Wetzel County, W. Va.

By C. D. Crouch, Salem, W. Va.

On 45 acres, on head of David Talkington Run; surface owned by  
Robinson Improvement Co., Smithfield, W. Va., and mineral  
rights by G. A. Snodgrass Heirs.

Elevation, 1115.60' L.

14" conductor, 12'; 10" casing, 190'; 8 $\frac{1}{2}$ ", 1400'; 6 $\frac{5}{8}$ ", 2240'.

No liner used.

Coal was encountered at 1021-1027'.

Abandonment reported to Dept. of Mines Dec. 3, 1936.

Record did not give well No., but Dept. of Mines listed it as No. 1.

Well was shot at 3148'.

Producing hole.

	Top.	Bottom.	Thickness.
Pittsburgh Coal, black	1021	- 1027	6
Salt Sand, white, sandy	1856	- 2124	268
Big Injun Sand	2396	- 2571	175
Gordon Sand	3145	- 3160	15
Total depth		3176	