


Latitude

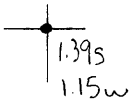

Longitude

Topo Location

7.5' Loc. _____ 15' Loc. _____
 _____ (calc.) _____

Company CD Gouch Oil Co

Farm Rena Wykert #1


15' Quad _____
 (sec.)

7.5' Quad Wileyville

District center

WELL LOCATION PLAT

County 103 Permit 30304

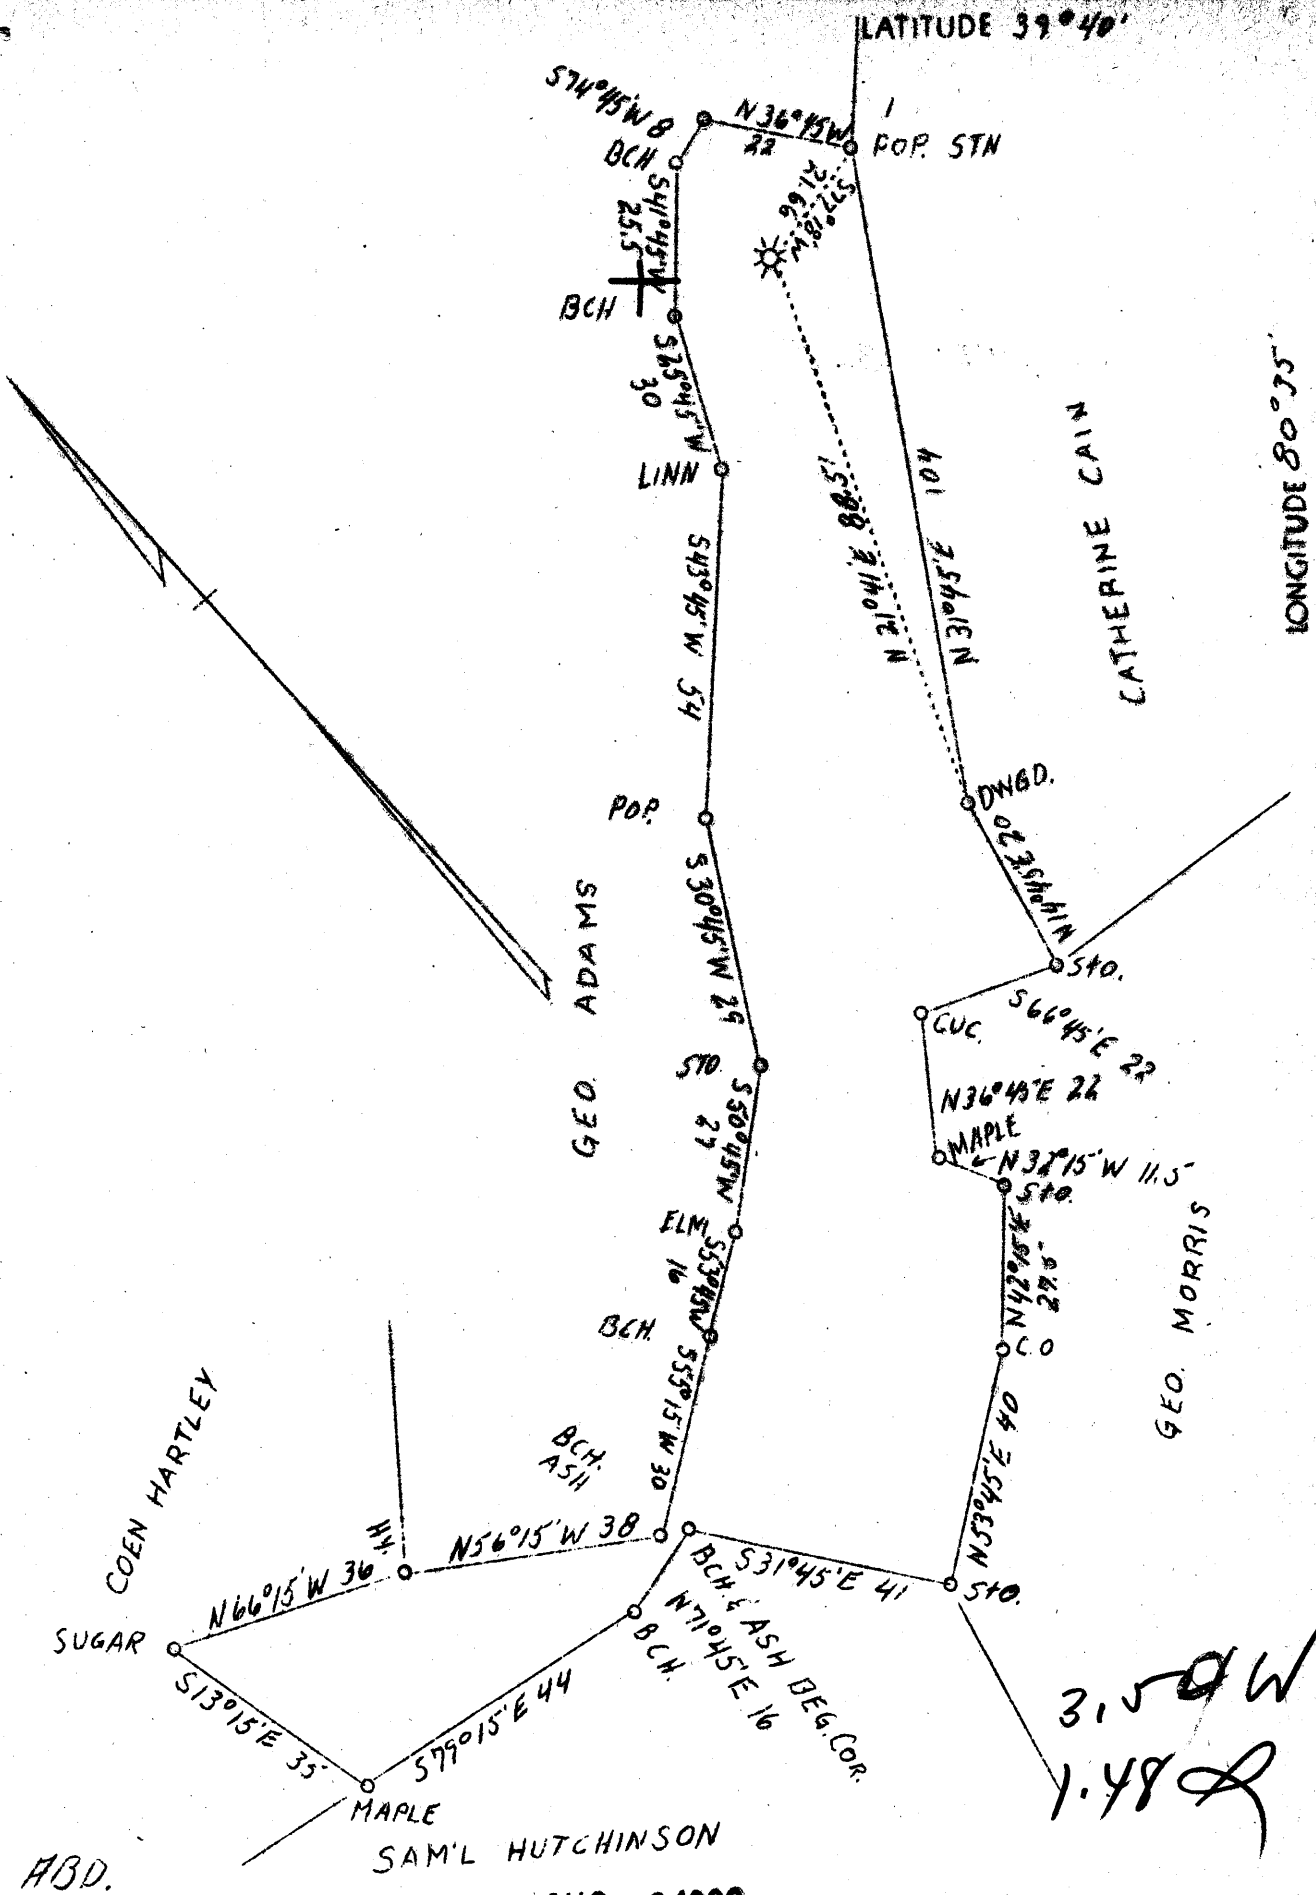

AUG - 8 1939

Company	C. D. Crouch Oil Co.
Address	New Martinsville, W. Va.
Farm	Rena Wykert
Tract	Sarah J. Furbee Hrs.
Acres	52-3/4
Well (Farm) No.	1
Elevation (SL)	1181.0
Quadrangle	Littleton
County	Wetzel
District	Center
Engineer	Hornor Bros.
Eng. Reg. No.	By: Paul Allen Hornor 602
Date	June 5, 1939
Scale	1" - 30 poles


STATE OF WEST VIRGINIA
Department of Mines
OIL & GAS DIVISION
Charleston

WELL LOCATION MAP

File No. Wpt-304-A

x Denotes location of well on U. S. Topographic Maps, scale 1 to 62,500, latitude and longitude lines being represented by border lines as shown.

- Denotes one inch spaces on border line of original tracing.

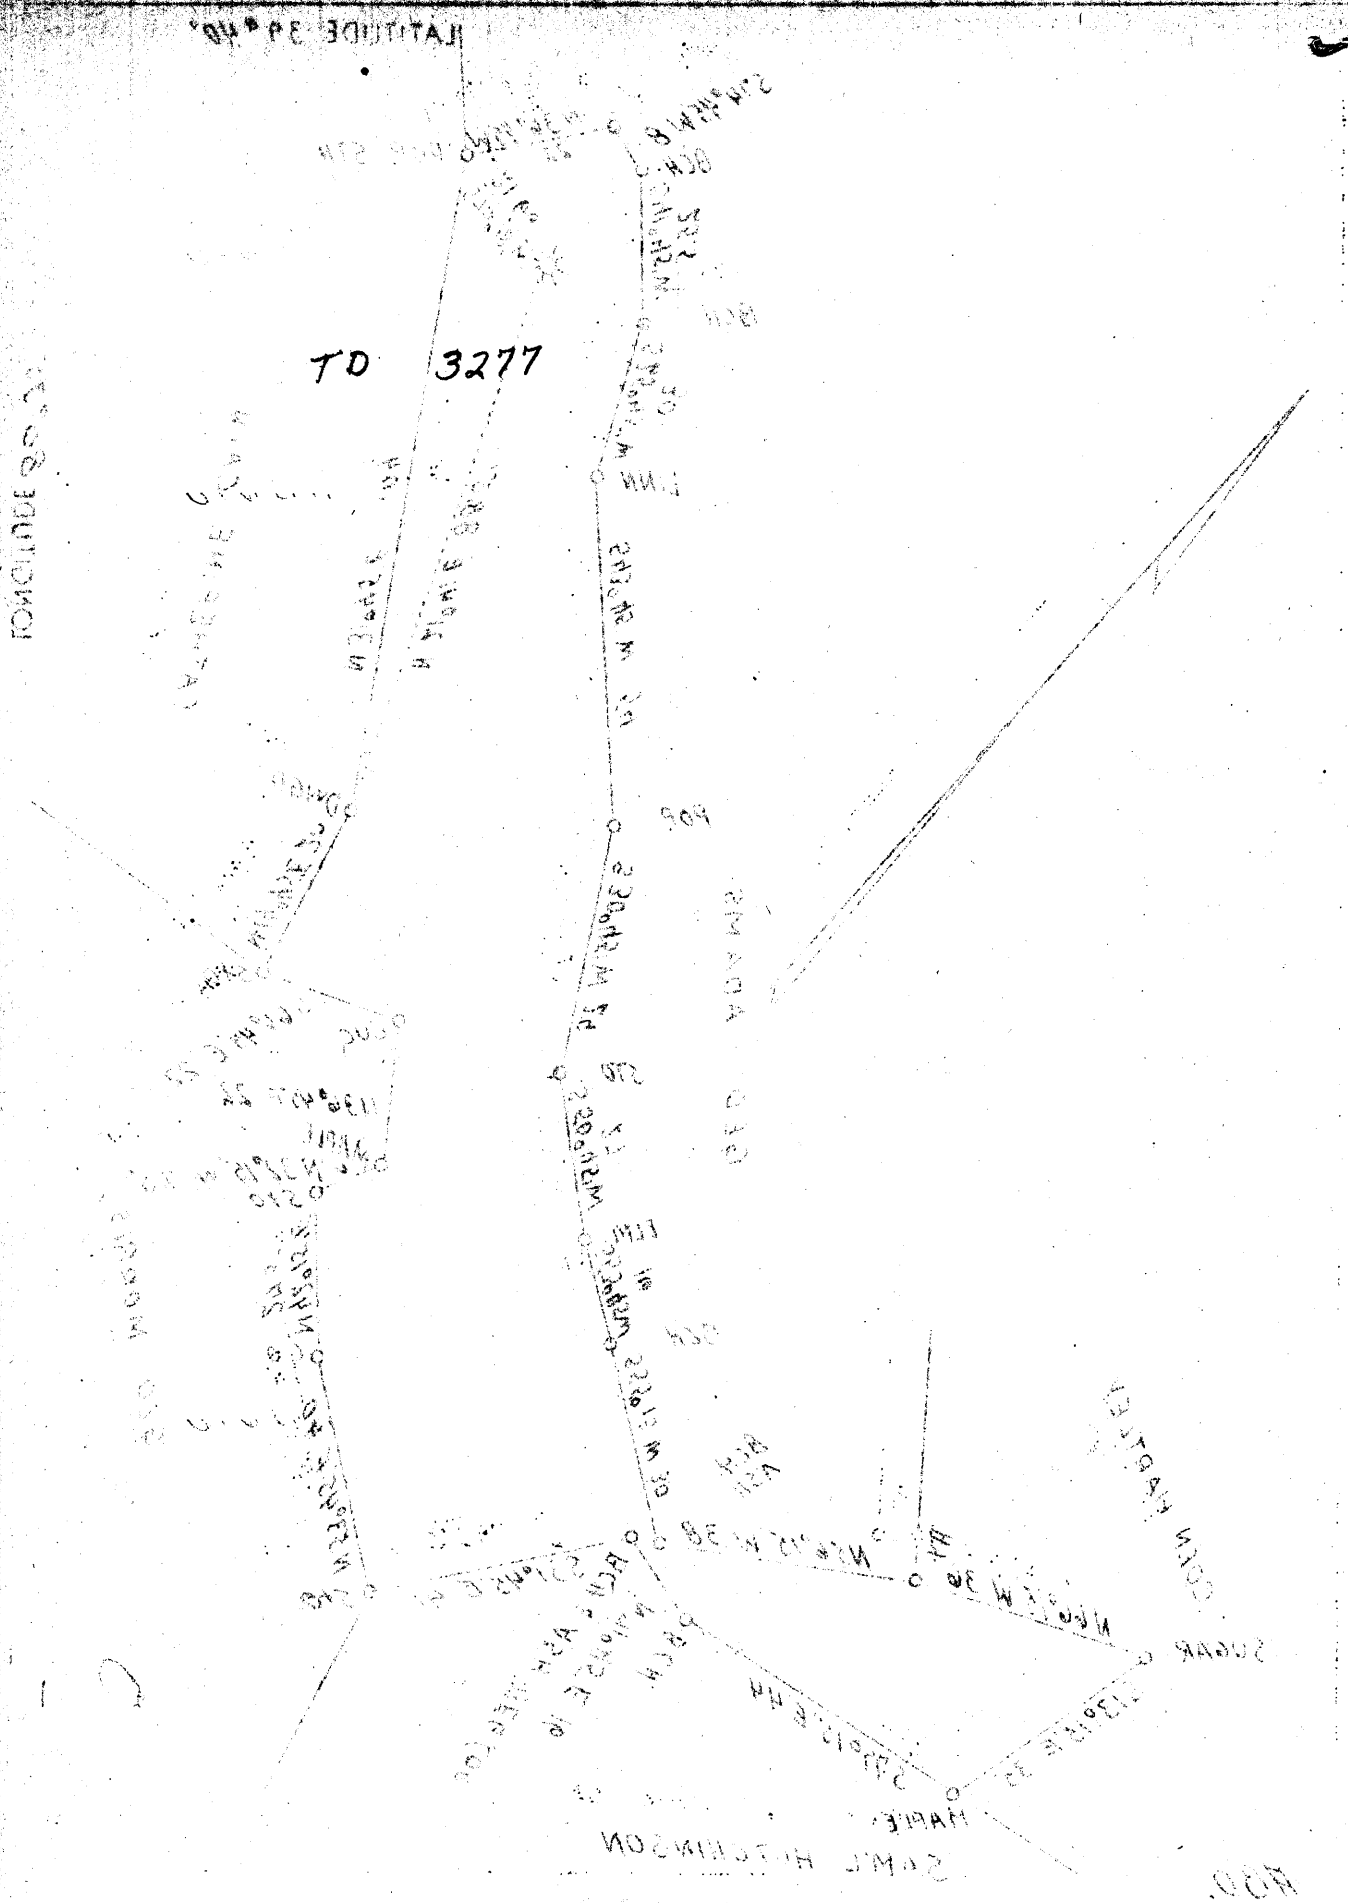

TD 3277

LONGITUDE 85.21

LATITUDE 39.40

of original tracing.
 - Denotes one face across on border line
 Date June 2, 1939
 Eng. Rec. No. 802

By: Paul Allen Hornum
 Engineer
 District
 County
 Quadrangle
 Elevation (SL)
 Well (Form) No. 1
 1181.0
 52-874

Acres
 Tract
 Farm
 Address
 County

By: Paul Allen Hornum
 Engineer
 District
 County
 Quadrangle
 Elevation (SL)
 Well (Form) No. 1
 1181.0
 52-874

Acres
 Tract
 Farm
 Address
 County

By: Paul Allen Hornum
 Engineer
 District
 County
 Quadrangle
 Elevation (SL)
 Well (Form) No. 1
 1181.0
 52-874

Acres
 Tract
 Farm
 Address
 County

of original tracing.
 - Denotes one face across on border line
 Date June 2, 1939
 Eng. Rec. No. 802

By: Paul Allen Hornum
 Engineer
 District
 County
 Quadrangle
 Elevation (SL)
 Well (Form) No. 1
 1181.0
 52-874


Acres
 Tract
 Farm
 Address
 County

By: Paul Allen Hornum
 Engineer
 District
 County
 Quadrangle
 Elevation (SL)
 Well (Form) No. 1
 1181.0
 52-874

Acres
 Tract
 Farm
 Address
 County

By: Paul Allen Hornum
 Engineer
 District
 County
 Quadrangle
 Elevation (SL)
 Well (Form) No. 1
 1181.0
 52-874

Acres
 Tract
 Farm
 Address
 County

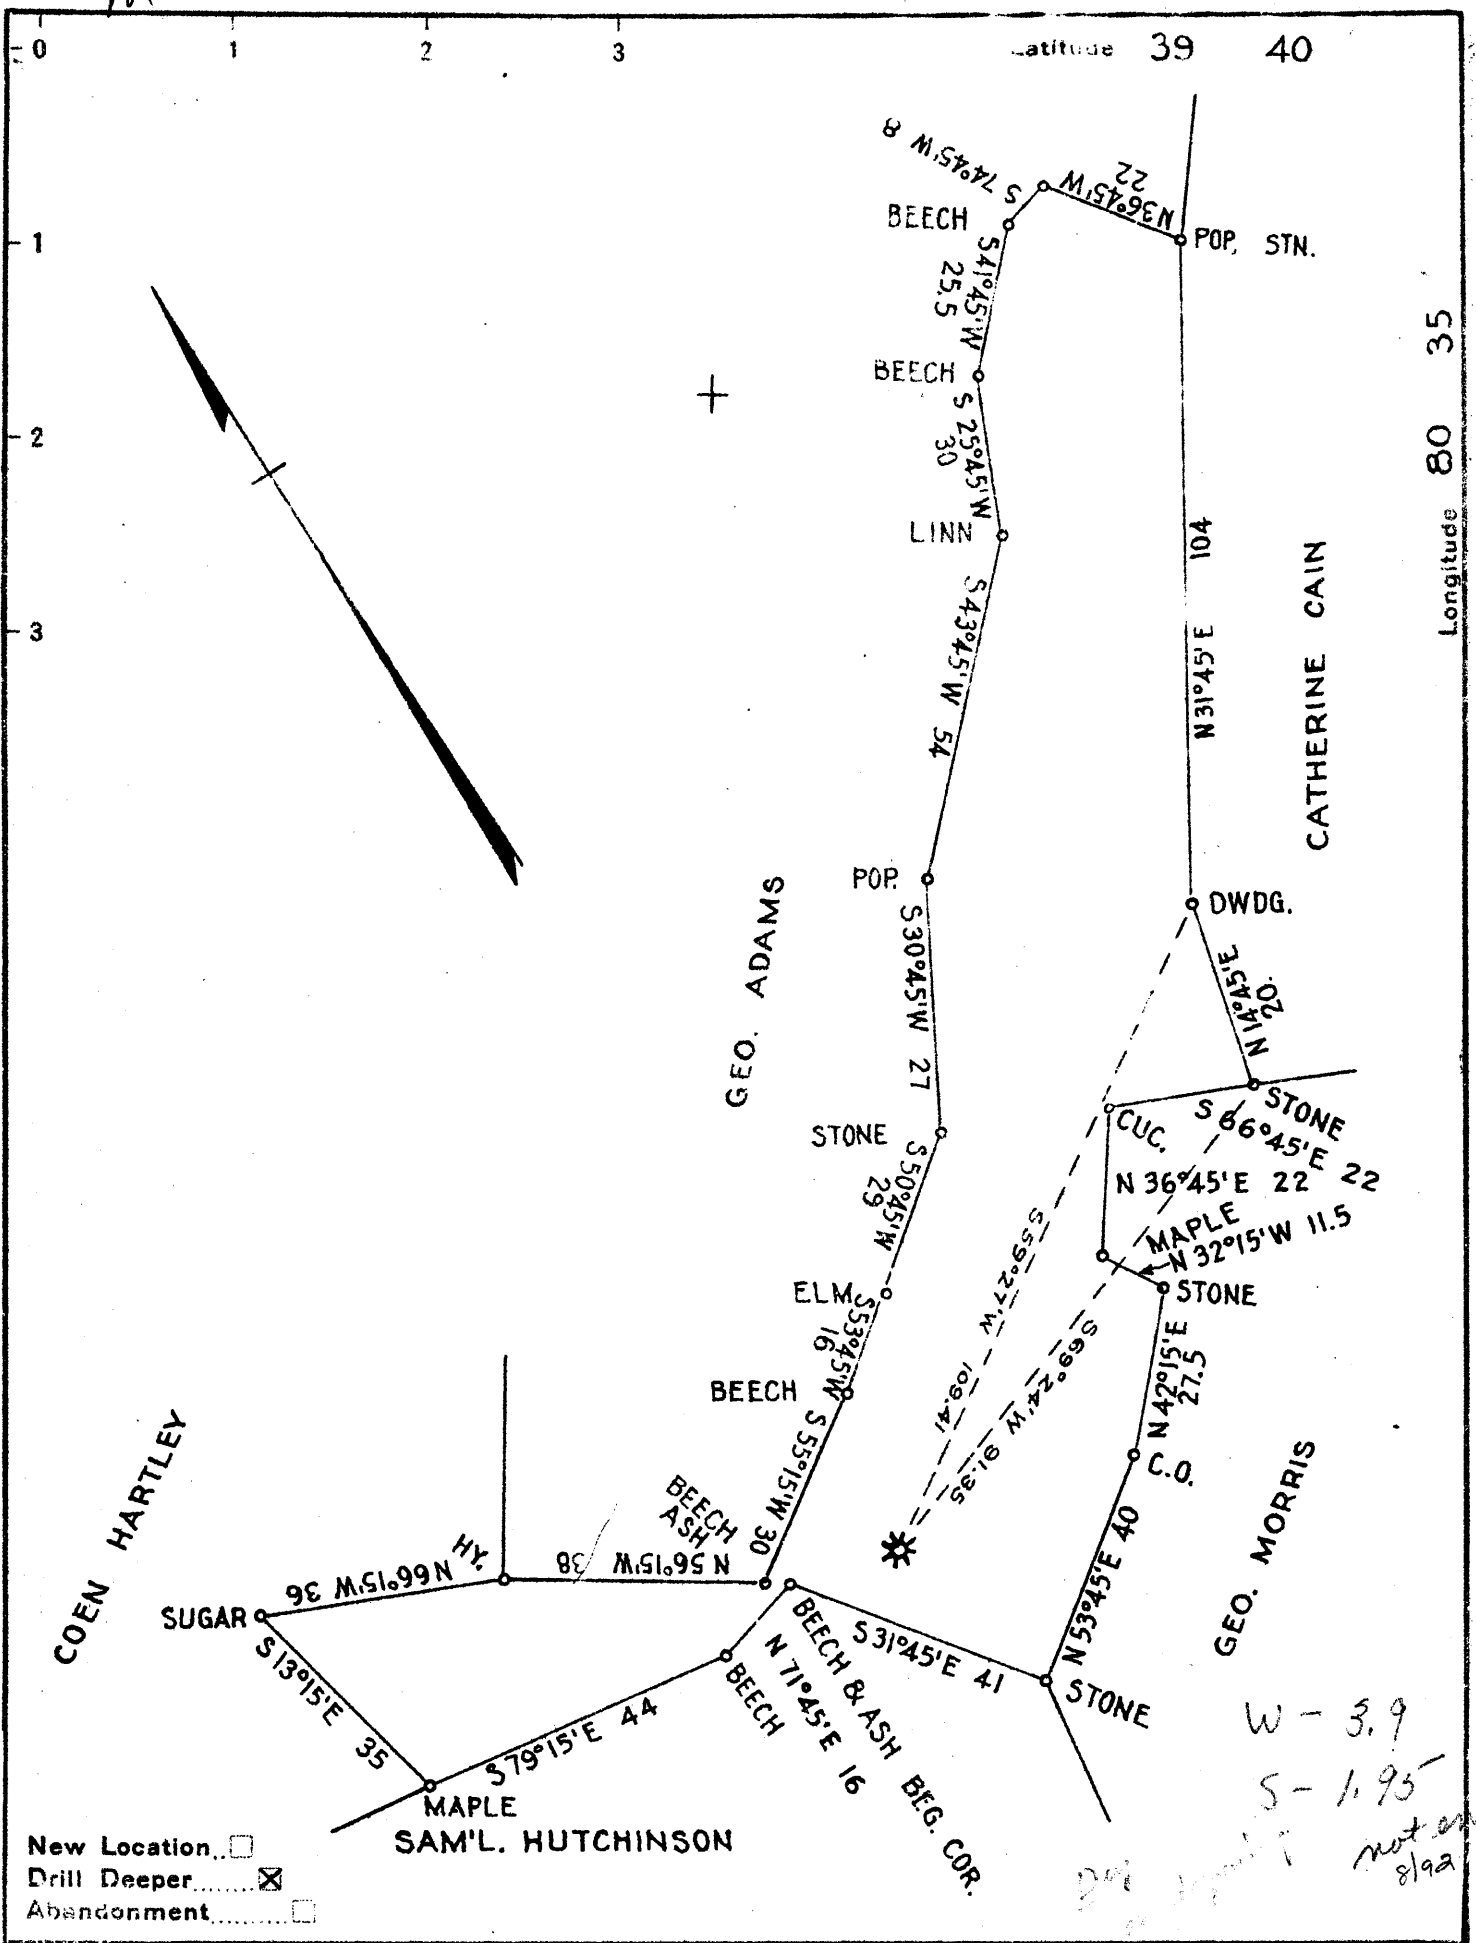

W - 3.9
 S - 1.95
 not entered
 8/92 SK

Company C.D. CROUCH OIL CO.
 Address NEW MARTINSVILLE W. VA.
 Farm RENA WYKERT
SARA J. FURBEE
 Tract HEIRS Acres 52 3/4 Lease No. _____
 Well (Farm) No. 5 Serial No. _____
 Elevation (Spirit Level) 1053.0
 Quadrangle LITTLETON C
 County WETZEL District CENTER
 Engineer HORNOR BROS. By Paul Allen Hornor
 Engineer's Registration No. 602
 File No. _____ Drawing No. _____
 Date 6-5-1939 Scale 1" = 30 POLES.

STATE OF WEST VIRGINIA
 DEPARTMENT OF MINES
 OIL AND GAS DIVISION
 CHARLESTON

WELL LOCATION MAP
 FILE NO. WET-304-B
 OLD ADL WELL.

+ Denotes location of well on United States Topographic Maps, scale 1 to 62,500, latitude and longitude lines being represented by border lines as shown.

- Denotes one inch spaces on border line of original tracing.