

Surface
 Jennie Anderson
 Littleton, W. Va.

Coal.
 Littleton Coal & Coke Co.
 Uniontown, Pa.

1.39 +.4W
 1.20

ABD.

SEP - 5 1939

Company	South Penn Oil Co.
Address	411 - 7th Ave., Pgh. Pa.
Farm	Elizabeth Anderson
Acres	100
Lease No.	53727
Well (Farm) No.	1
Elevation (S.L.)	1115.57
Quadrangle	Littleton
County	Wetzel
District	Center
Engineer	E. C. Tabler
Eng. Reg. No.	-
Date	July 25, 1939
Scale	1" = 800'



STATE OF WEST VIRGINIA
 Department of Mines
 OIL & GAS DIVISION
 Charleston

WELL LOCATION MAP

File No. WV-307-A

x Denotes location of well on U. S. Topographic Maps, scale 1 to 62,500, latitude and longitude lines being represented by border lines as shown.

- Denotes one inch spaces on border line of original tracing.

WEST VIRGINIA DEPARTMENT OF MINES
OIL AND GAS DIVISION

778

WELL RECORD

Ab 307-A
Permit No.


Oil or Gas Well **OIL**
(Kind)

Company **South Penn Oil Company**
Address **411 Seventh Ave., Pittsburgh, Pa.**
Farm **Elizabeth Anderson** Acres **100**
Location (waters) **Sugar Run**
Well No. **1** Elev. **1115.57'**
District **Center** County **Wetzel**
The surface of tract is owned in fee by **Jennie Anderson**
Littleton, Address **W. Va.**
Mineral rights are owned by **Jennie Anderson**
Littleton, Address **W. Va.**
Drilling commenced **January 16, 1905**
Drilling completed **March 24, 1905**
Date shot **March 25-1905** Depth of shot **---**
April 30-1913 **Gordon**
April 19-1939
Open Flow **---** /10ths Water in **---** Inch
--- /10ths Merc. in **---** Inch
Volume **---** Cu. Ft.
Rock Pressure **---** lbs. **---** hrs.
Oil **Est. 10 BBL** bbls., 1st 24 hrs.
Fresh water **---** feet **---** feet
Salt water **-? -** feet **---** feet

Casing and Tubing	Used in Drilling	Left in Well	Packers
Size			Kind of Packer
16			---
13			---
10	244' 5"		Size of
8 1/4	1343' 9"		---
6 5/8	2084'		Depth set
5 3/16	2533'		---
3			Perf. top
2			Perf. bottom
Liners Used			Perf. top
			Perf. bottom

CASING CEMENTED **---** SIZE **---** No. FT. **---** Date **---**
COAL WAS ENCOUNTERED AT **745 (?)** FEET **---** INCHES
845 FEET **120** INCHES **---** FEET **---** INCHES
--- FEET **---** INCHES **---** FEET **---** INCHES

Formation	Color	Hard or Soft	Top	Bottom	Oil Gas or Water	Depth Found	Remarks
NOTE:- Work Order date from field indicates Mapletown Coal from 745-755. Not shown on office well record.							
Pittsburgh Coal			845	855			
Dunkard Sand			---	---			
Salt Sand			1634	1882	Water	---	
Maxon Sand			---	---			
Injun Sand			2089	2332			
Berea Sand			---	---			
Gantz Sand			---	---			
Fifty Foot			---	---			
Thirty Foot			---	---			
Stray Sand			2900	2935			
Gordon Sand			2935	2960	Oil	2955	1000' after shot
Fourth Sand			2988	3006			
Fifth Sand			3072	3079			
Total Depth				3101			

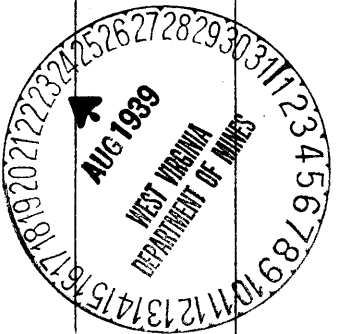

Formation	Color	Hard or Soft	Top	Bottom	Oil, Gas or Water	Depth Found	Remarks

Date August 21, 1939

APPROVED SOUTH PENN OIL COMPANY, Owner

By Elton E. Young Land Agent
S. P. O. Co.