


Latitude 39° 40'

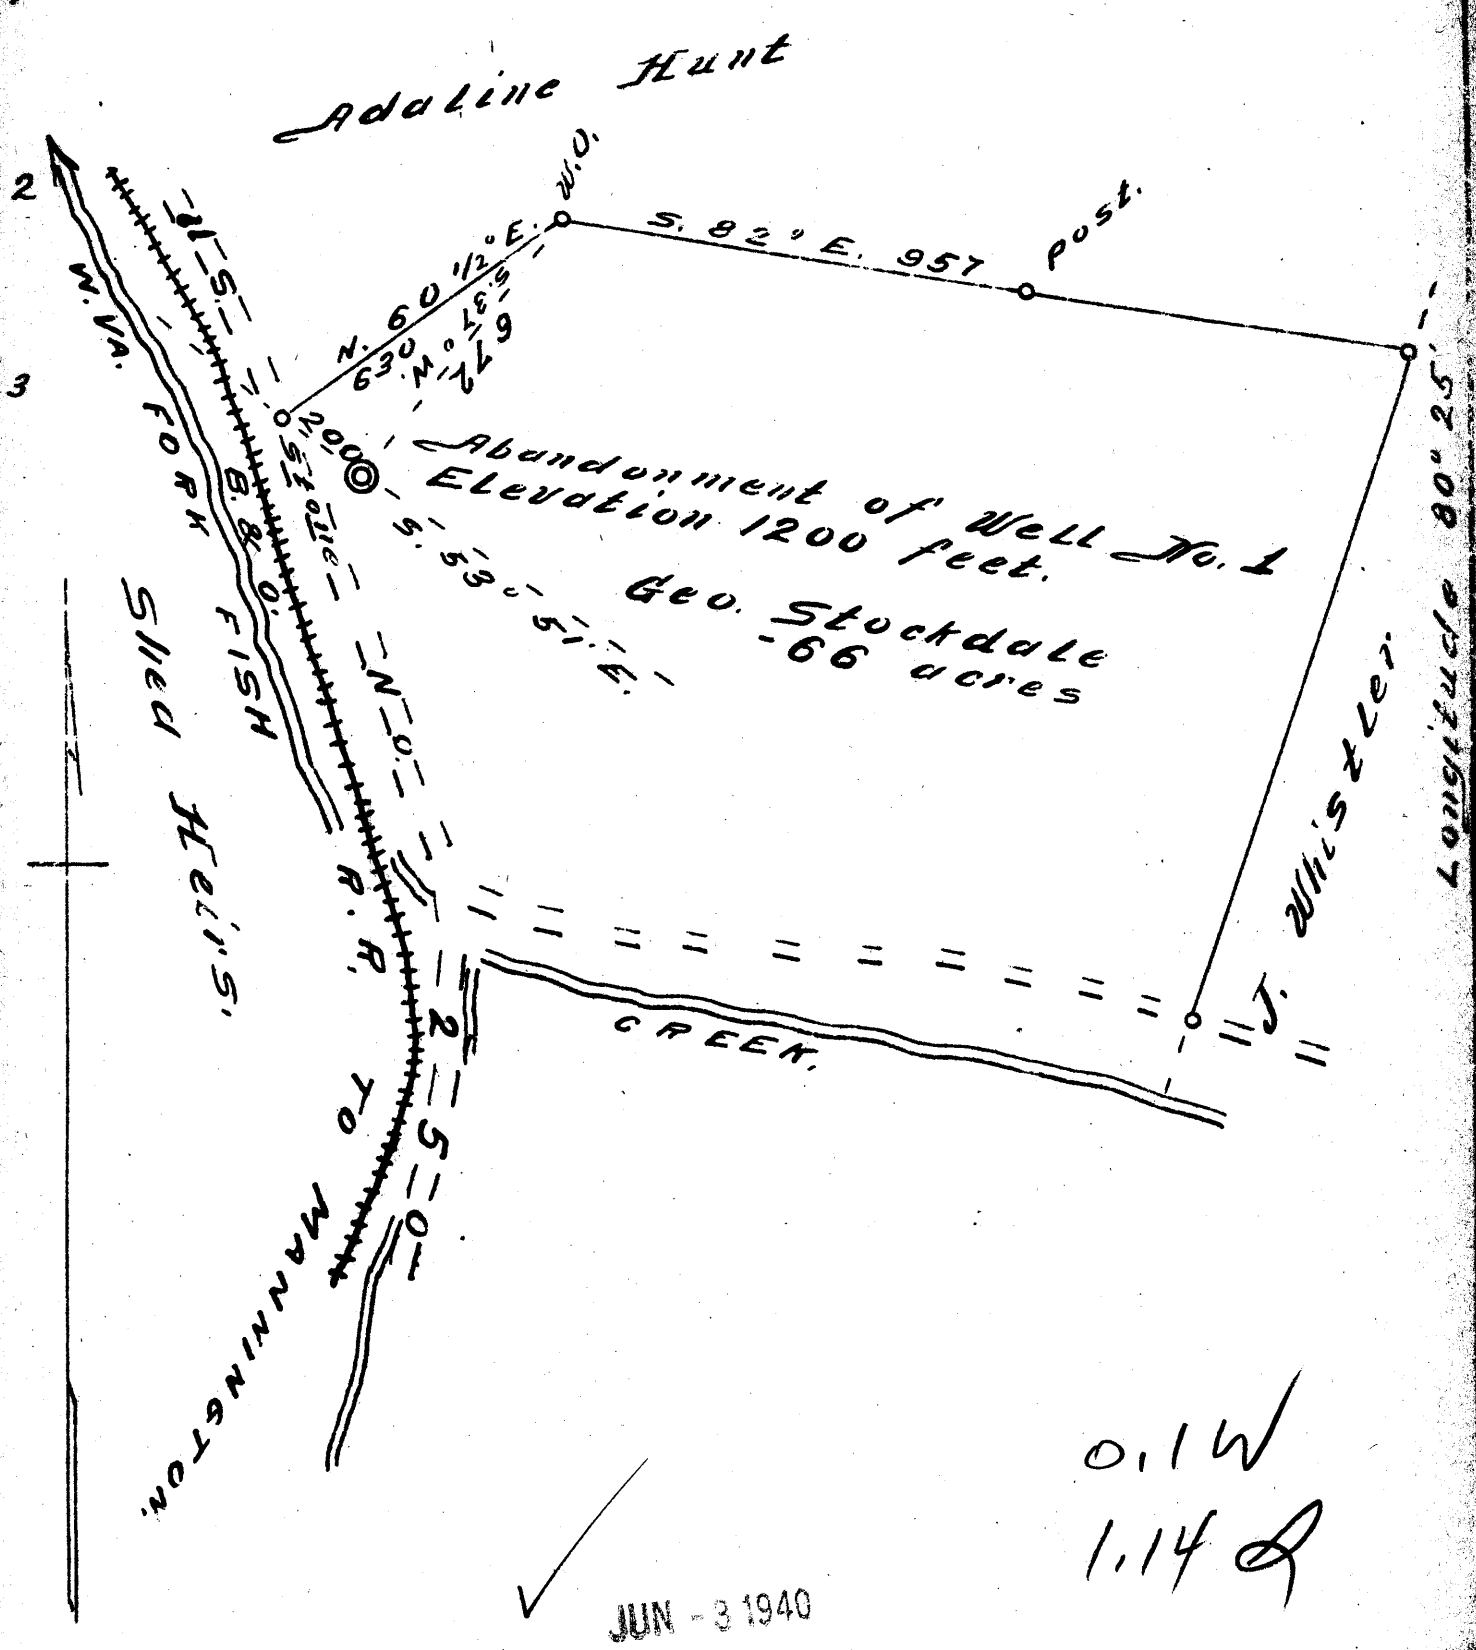

0.1W
1.14 Q

✓ JUN - 3 1940

COMPANY Maxton Oil & Gas
 ADDRESS Fairmont, W. Va.
 FARM Geo. Stockdale
 TRACT One Acres 66
 WELL abandonment No. 1
 QUADRANGLE Mannington W. C.
 COUNTY Wetzel
 DISTRICT Church
 ENGINEER David Weed WC
 REGISTRATION No. 233-16-5767
 DATE May 9 - 1940
 SCALE 1 inch = 400 feet.

State of West Virginia
 Department of Mines
 Oil & Gas Division
 Charleston
 Well Location Map
 File No. WET-327A