

Surface: Marion Gorby  
 Wileyville, W. Va.  
 Coal: State of West Virginia

2.67 2.7 W ✓  
 0.15 0.17 ✓

New Location   
 Drill Deeper   
 Abandonment

APR 15 1940

Company South Penn Natural Gas Co.  
 Address Parkersburg, West Va.  
 Farm Marion Gorby  
 Tract \_\_\_\_\_ Acres 82 Lease No. 28022  
 Well (Farm) No. 3 Serial No. \_\_\_\_\_  
 Elevation (Spirit Level) 1225.01  
 Quadrangle Littleton  
 County Wetzel District Center  
 Engineer E.C. Tabler  
 Engineer's Registration No. \_\_\_\_\_  
 File No. \_\_\_\_\_ Drawing No. \_\_\_\_\_  
 Date Apr. 15, 1940 Scale 1" = 400'

STATE OF WEST VIRGINIA  
 DEPARTMENT OF MINES  
 OIL AND GAS DIVISION  
 CHARLESTON

WELL LOCATION MAP  
 FILE NO. WET-330A

+ Denotes location of well on United States Topographic Maps, scale 1 to 62,500, latitude and longitude lines being represented by border lines as shown.  
 - Denotes one inch spaces on border line of original tracing.

STATE OF WEST VIRGINIA  
DEPARTMENT OF MINES  
OIL AND GAS DIVISION

796

WELL RECORD

AB  
Permit No. 330-A


Oil or Gas Well **OIL**  
(KIND)

Company **South Penn Natural Gas Company**  
Address **Union Trust Bldg. Parkersburg, W. Va.**  
Farm **Marion Corby** Acres **82**  
Location (waters) **Rocky Run**  
Well No. **5** Elev. **1285.01'**  
District **Center** County **Wetzel**  
The surface of tract is owned in fee by **Marion Corby**  
**Wileyville, W. Va.** Address **W. Va.**  
Mineral rights are owned by **Armina M. Abrams, et al**  
Address **Lisbon, Ohio**  
Drilling commenced **March 5, 1906.**  
Drilling completed **May 10, 1906.**  
Date shot **May 10-1906-3000** Depth of shot **stray**  
**Dec. 31-1935-4000**  
Open Flow /10ths Water in **---** Inch  
/10ths Merc. in **---** Inch  
Volume **---** Cu. Ft.  
Rock Pressure **---** lbs **---** hrs.  
Oil **10** bbls., 1st 24 hrs.  
Fresh water **---** feet **---** feet  
Salt water **1965** feet **2050** feet

Casing and Tubing	Used in Drilling	Left in Well	Packers
Size			
16			Kind of Packer <b>-</b>
13	<b>84'</b>		<b>-</b>
10	<b>1450'</b>		Size of <b>-</b>
8 1/4	<b>1750' (Pulled)</b>		<b>-</b>
6 5/8	<b>2013'</b>		Depth set <b>-</b>
5 3/16	<b>2400'</b>		<b>-</b>
3			Perf. top <b>-</b>
2			Perf. bottom <b>-</b>
Liners Used			Perf. top <b>-</b>
<b>Cond.</b>	<b>16'</b>		Perf. bottom <b>-</b>

CASING CEMENTED **-** SIZE **-** No. Ft. **-** Date **-**  
COAL WAS ENCOUNTERED AT **1060** FEET **60?** INCHES  
**1156** FEET **72** INCHES **-** FEET **-** INCHES  
**-** FEET **-** INCHES **-** FEET **-** INCHES

Formation	Color	Hard or Soft	Top	Bottom	Oil, Gas or Water	Depth Found	Remarks
Mapletown Coal			1060	(1065?)			
Pittsburgh Coal			1156	1162			
Dunkard Sand			1630	1760			
Gas Sand			1890	2000			
Salt Sand			2020	2185	Water	1965	
Big Line			2290	2375	Water	2050	
Big Injun Sand			2375	2615			
Stray Sand			3180	3204			
					Oil	3185	
<b>Total Depth</b>				<b>5243</b>			

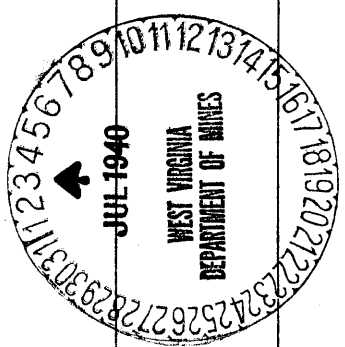

Formation	Color	Hard or Soft	Top	Bottom	Oil, Gas or Water	Depth Found	Remarks

Date **July 2,** 194**0**

APPROVED **SOUTH PENN NATURAL GAS COMPANY** Owner

By *Edwin Young* Land Agent (Title)