


Latitude  $39^{\circ} 45'$   
 Longitude  $80^{\circ} 25'$

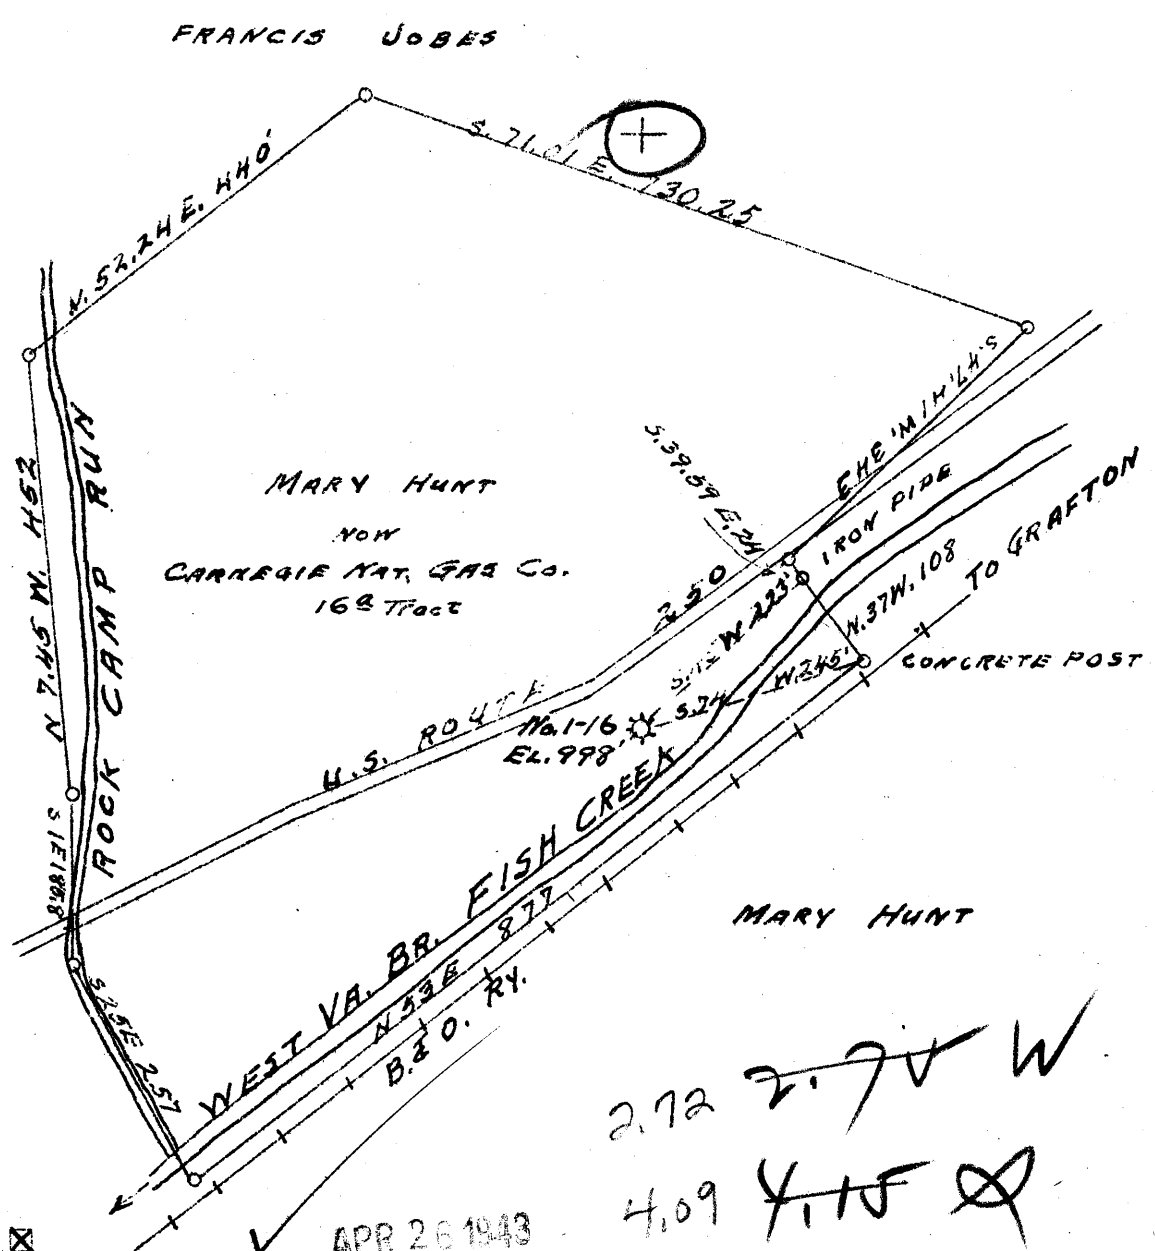

New Location   
 Drill Deeper   
 Abandonment

Company CARNEGIE NATURAL GAS CO.  
 Address PITTSBURGH, PENNA.  
 Farm MARY HUNT  
 Tract ONE Acres 119 Lease No E-2601-72  
 Well (Farm) No. 1 Serial No. 16  
 Elevation (Spirit Level) 998'  
 Quadrangle MANNINGTON N.W. 1/4  
 County WETZEL District CHURCH  
 Engineer D.T. BRITTON  
 Engineer's Registration No. \_\_\_\_\_  
 File No. \_\_\_\_\_ Drawing No. \_\_\_\_\_  
 Date 4-1-1943 Scale 1" = 200'

STATE OF WEST VIRGINIA  
 DEPARTMENT OF MINES  
 OIL AND GAS DIVISION  
 CHARLESTON

WELL LOCATION MAP  
 FILE NO. WET-442A

+ Denotes location of well on United States Topographic Maps, scale 1 to 62,500, latitude and longitude lines being represented by border lines as shown.  
 - Denotes one inch spaces on border line of original tracing.

MARY HUNT 16-1 CARNEGIE NAT. GAS CO. WET-442-A