


0 1 2 3 Latitude 39° 45'

1  
2  
3  
Longitude 80° 25'

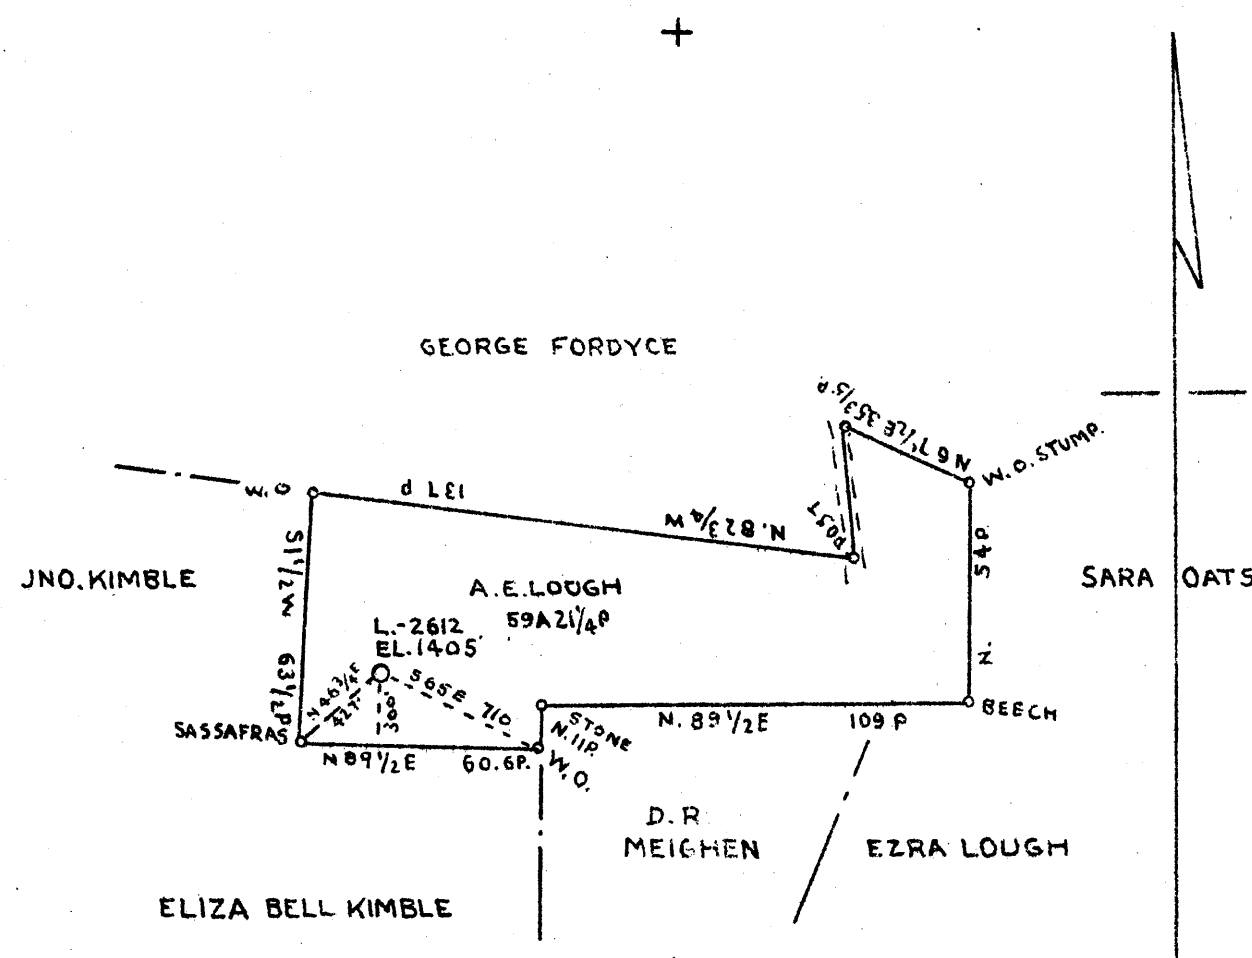

COAL OWNED BY T.L. ROGERSON AND EVERETT T. MOORE  
MOUNDSVILLE W.VA.

2.18 S  
3.50 W

New Location:

Drill Deeper:

Abandonment:

Company THE MANUFACTURERS LIGHT AND HEAT CO.  
 Address 800 UNION TRUST BLD'G PITTSBURGH. PA.  
 Farm A.E. LOUGH AND LEONARD GARRISON  
 Tract \_\_\_\_\_ Acres 59A21/4P Lease No. 5908  
 Well (Farm) No. 1 Serial No. 2612  
 Elevation (Spirit Level) 14.05'  
 Quadangle MANNINGTON NW  
 County WETZEL District CLAY  
 Engineer *J. L. Mercer*  
 Engineer's Registration No. \_\_\_\_\_  
 File No. Bk. 14 P. 34 INV. Drawing No. Y-10-943  
 Date SEPTEMBER 11-43 Scale 1" = 800'

STATE OF WEST VIRGINIA  
 DEPARTMENT OF MINES  
 OIL AND GAS DIVISION  
 CHARLESTON

WELL LOCATION MAP  
 File No. WET-453-A

— Denotes location of well on United States Topographic Maps, scale 1 to 62,500, latitude and longitude lines being represented by border lines as shown.

— Denotes one inch spaces on border line of original tracing