

New Location   
 Drill Deeper   
 Abandonment  Partial

OCT 24 1944

2.80 7.82 W

3.34 3.40

MAP 51138 SQ. N-7 W-6 FB 765 P.13

Company HOPE NATURAL GAS CO.  
 Address CLARKSBURG, W. VA.  
 Farm MARY MARTIN  
 Tract \_\_\_\_\_ Acres 60 Lease No. 30667  
 Well (Farm) No. \_\_\_\_\_ Serial No. 5439  
 Elevation (Spirit Level) 913'  
 Quadrangle LITTLETON  
 County WETZEL District GREEN  
 Engineer W. M. Bowen  
 Engineer's Registration No. 900  
 File No. \_\_\_\_\_ Drawing No. \_\_\_\_\_  
 Date 9-30-44 Scale 1" = 40 POLES

STATE OF WEST VIRGINIA  
 DEPARTMENT OF MINES  
 OIL AND GAS DIVISION  
 CHARLESTON

WELL LOCATION MAP  
 FILE NO. WET-483-A

+ Denotes location of well on United States Topographic Maps, scale 1 to 62,500, latitude and longitude lines being represented by border lines as shown.

- Denotes one inch spaces on border line of original tracing.



STATE OF WEST VIRGINIA  
DEPARTMENT OF MINES  
OIL AND GAS DIVISION

956

Permit No. 183-A

WELL RECORD

Oil or Gas Well \_\_\_\_\_  
(KIND)

Company Hope Natural Gas Company.  
 Address 445 West Main St. Clarksburg, W. Va.  
 Farm Mary Martin Acres 60  
 Location (waters) \_\_\_\_\_  
 Well No. 5439 Elev. 915  
 District Green County Wetzel  
 The surface of tract is owned in fee by \_\_\_\_\_  
 Address \_\_\_\_\_  
 Mineral rights are owned by \_\_\_\_\_  
 Address \_\_\_\_\_  
 Drilling commenced May 26, 1919  
 Drilling completed July 29, 1919  
 Date Shot \_\_\_\_\_ From \_\_\_\_\_ To \_\_\_\_\_  
 With \_\_\_\_\_  
 Open Flow \_\_\_\_\_ /10ths Water in \_\_\_\_\_ Inch  
 \_\_\_\_\_ /10ths Merc. in \_\_\_\_\_ Inch  
 Volume \_\_\_\_\_ Cu. Ft.  
 Rock Pressure \_\_\_\_\_ lbs. \_\_\_\_\_ hrs.  
 Oil \_\_\_\_\_ bbls., 1st 24 hrs.  
 Fresh water none recorded feet \_\_\_\_\_ feet  
 Salt water none recorded feet \_\_\_\_\_ feet


Casing and Tubing	Used in Drilling	Left in Well	Packers
Size			
16			Kind of Packer
13			
10	<b>306</b>	<b>Pulled</b>	Size of
8 1/4	<b>1100</b>	<b>1100</b>	
6 5/8	<b>1821</b>	<b>1821</b>	Depth set
5 3/16			
3			Perf. top
2	<b>2711</b>	<b>Pulled</b>	Perf. bottom
Liners Used			Perf. top
			Perf. bottom

CASING CEMENTED **Not cemented** SIZE \_\_\_\_\_ No. Ft. \_\_\_\_\_ Date \_\_\_\_\_  
 COAL WAS ENCOUNTERED AT 570 FEET 24 INCHES  
 \_\_\_\_\_ FEET \_\_\_\_\_ INCHES FEET \_\_\_\_\_ INCHES  
 \_\_\_\_\_ FEET \_\_\_\_\_ INCHES FEET \_\_\_\_\_ INCHES

Formation	Color	Hard or Soft	Top	Bottom	Oil, Gas or Water	Depth Found	Remarks
Coal			570	572			
Little Dunkard			1022	1036			
Big Dunkard			1085	1105			
First Salt			1385	1435			
Second Salt			1504	1606			
Maxon			1700	1745			
Big Lime			1783	1838			
Big Injun			1836	2066	gas	1856- 1868	
Berea			2213	2235			
Gantz			2395	2410			
Fifty foot			2415	2440			
Thirty Foot			2570	2576			
Gordon			2640	2670	gas	2648- 2657	
Fourth			2690	2702			
Total depth				2711			

TO BE PARTIALLY ABANDONED

JAN 29 1945

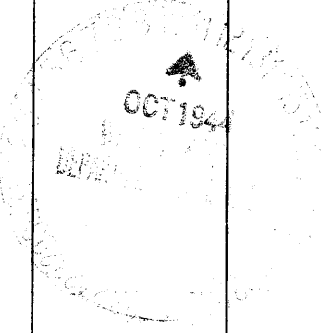

Formation	Color	Hard or Soft	Top	Bottom	Oil, Gas or Water	Depth Found	Remarks

Date October 9, 1944., 194

APPROVED Hope Natural Gas Company., Owner

By *[Signature]* Ass't. to Gen. Sup't.  
(Title)

