

New Location
 Drill Deeper
 Abandonment

OCT 6 1945

10 W
 546 553

Company Dunn-Mar Oil & Gas Co
 Address Waynesburg Pa.
 Farm F. F. Morgan
 Tract ONE Acres 250 Lease No. _____
 Well (Farm) No. _____ Serial No. Hope 7187
 Elevation (Spirit Level) 1182'
 Quadrangle Littleton.
 County Wetzel District Gran
 Engineer A. L. Headley
 Engineer's Registration No. _____
 File No. _____ Drawing No. _____
 Date 9-22-1945 Scale 1 in = 60 poles

STATE OF WEST VIRGINIA
 DEPARTMENT OF MINES
 OIL AND GAS DIVISION
 CHARLESTON

WELL LOCATION MAP
 FILE NO. Wet-509-A

+ Denotes location of well on United States Topographic Maps, scale 1 to 62,500, latitude and longitude lines being represented by border lines as shown.

- Denotes one inch spaces on border line of original tracing.



977

STATE OF WEST VIRGINIA
DEPARTMENT OF MINES
OIL AND GAS DIVISION

WELL RECORD

Permit No. 109-A

Oil or Gas Well Gas
(KIND)

Company Dunn-Mar Oil & Gas Co;
 Address Waynesburg, Pa. 260 West Wayne St;
 Farm F.E.Morgan Acres 250
 Location (waters) _____
 Well No. Hope # 7187 Elev. 1182
 District Grant County Wetzel
 The surface of tract is owned in fee by _____
 Address _____
 Mineral rights are owned by _____
 Address _____
 Drilling commenced Feb 27 1928
 Drilling completed June 20 1928
 Date Shot _____ From _____ To _____
 With _____
 Open Flow _____ /10ths Water in _____ Inch
 _____ /10ths Merc. in _____ Inch
 Volume _____ Cu. Ft.
 Rock Pressure _____ lbs. _____ hrs.
 Oil _____ bbls., 1st 24 hrs.
 Fresh water _____ feet _____ feet
 Salt water _____ feet _____ feet

Casing and Tubing	Used in Drilling	Left in Well	Packers
Size			
16			Kind of Packer
18			
10	461		Size of 2"x 5"
8 1/4	1340		
6 5/8	1692		Depth set 2922
5 3/16	2095		
3			Perf. top
2	2988		Perf. bottom
Liners Used			Perf. top
			Perf. bottom


CASING CEMENTED _____ SIZE _____ No. Ft. _____ Date _____

COAL WAS ENCOUNTERED AT 847-49 FEET _____ INCHES

_____ FEET _____ INCHES _____ FEET _____ INCHES

_____ FEET _____ INCHES _____ FEET _____ INCHES

Formation	Color	Hard or Soft	Top	Bottom	Oil, Gas or Water	Depth Found	Remarks
Pittsburgh Coal			847	849			
Little Dunkard sand			1198	1227			
Big Dunkard "			1320	1365			
1st Salt sand			1613	1664			
2nd " "			1740	1795			
Maxon sand			--	--			
Big lime			2050	2140			
Big Injun sand			2140	2315	Gas 2156		
Thirty Ft. Sand			2798	2803			
Gordon sand				3000	Gas 2987-	2995	
Fourth sand				3033			
Total Depth				3102			

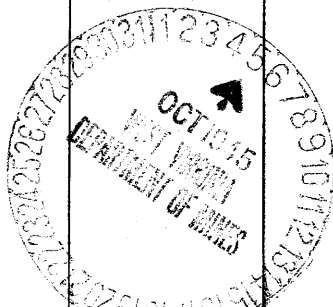

Formation	Color	Hard or Soft	Top	Bottom	Oil, Gas or Water	Depth Found	Remarks

Date Oct 4, 1945

APPROVED Dunn-Marlett Gas Co., Owner

By G. F. Stappers
(Title) Super