

Surface: Mrs. Ethel Shreve  
Smithfield, Wetzel Co., W.Va.

Coal: Consolidation Coal Co.  
Watson Bldg., Fairmont, W.Va.

New Location   
Drill Deeper   
Abandonment

NOV 13 1945  
On 400' Map # 2851 Squares N 4 E 3

4.31 4.37 W  
5.42

Company Raad Supply Co.  
 Address Salem, W.Va  
 Farm Jasper Shreve  
 Tract Acres 142.4<sup>a</sup> Lease No. \_\_\_\_\_  
 Well (Farm) No. 2 Serial No. \_\_\_\_\_  
 Elevation (Spirit Level) 815.75  
 Quadrangle Littleton  
 County Wetzel District Grant  
 Engineer E.C. Tabler  
 Engineer's Registration No. \_\_\_\_\_  
 File No. \_\_\_\_\_ Drawing No. \_\_\_\_\_  
 Date Nov 15<sup>th</sup> 1945 Scale 1" = 800'

STATE OF WEST VIRGINIA  
DEPARTMENT OF MINES  
OIL AND GAS DIVISION  
CHARLESTON

WELL LOCATION MAP  
FILE NO. WET-512-A

+ Denotes location of well on United States Topographic Maps, scale 1 to 62,500, latitude and longitude lines being represented by border lines as shown.

- Denotes one inch spaces on border line of original tracing



978

STATE OF WEST VIRGINIA  
DEPARTMENT OF MINES  
OIL AND GAS DIVISION

WELL RECORD

Permit No. 544-A

Oil or Gas Well Oil  
(KIND)

Company Reed Supply Company  
Address 184 E. Main St., Salem, W. Va.  
Farm Jasper Shreves Acres 142.4  
Location (waters) South Fork of Fishing Creek  
Well No. 2 Elev. 815.73  
District Grant County Wetzel

Casing and Tubing	Used in Drilling	Left in Well	Packers
Size			
16			Kind of Packer
13			
10	320'	320'	Size of
8 1/4	1105'	1105'	
6 5/8	1834'	1834'	Depth set
5 3/16	2417'	2417'	
3			Perf. top
2	2736'	2736'	Perf. bottom
Liners Used			Perf. top
			Perf. bottom

The surface of tract is owned in fee by Mrs. Ethel Shreves  
Address Smithfield, W. Va.  
Mineral rights are owned by Consolidation Coal Co.  
Watson Building Address Fairmont, W. Va.


Drilling commenced \_\_\_\_\_  
Drilling completed October 10, 1913.

Date Shot 10/15/13 From 2722' To 2732'  
With 3/11/14 2722' 2732'

Open Flow /10ths Water in \_\_\_\_\_ Inch  
/10ths Merc. in \_\_\_\_\_ Inch  
Volume \_\_\_\_\_ Cu. Ft.  
Rock Pressure \_\_\_\_\_ lbs. \_\_\_\_\_ hrs.  
Oil \_\_\_\_\_ bbls., 1st 24 hrs.  
Fresh water \_\_\_\_\_ feet \_\_\_\_\_ feet  
Salt water \_\_\_\_\_ feet \_\_\_\_\_ feet

CASING CEMENTED No SIZE \_\_\_\_\_ No. Ft. \_\_\_\_\_ Date \_\_\_\_\_  
COAL WAS ENCOUNTERED AT 593 FEET 60 INCHES  
\_\_\_\_\_ FEET \_\_\_\_\_ INCHES FEET \_\_\_\_\_ INCHES  
\_\_\_\_\_ FEET \_\_\_\_\_ INCHES FEET \_\_\_\_\_ INCHES

Formation	Color	Hard or Soft	Top	Bottom	Oil, Gas or Water	Depth Found	Remarks
Pittsburgh Coal			588	593			
Big Dunkard			1105	1120			
Gas Sand			1185	1220			
1st. Salt Sand			1390	1432			
2nd Salt Sand			1595	1635			
Maxon			1764	1824			
Little Lime			1824	1831			
Big Lime			1834	1918			
Big Injun			1918	2095			
50 Ft. Sand			2417	2429			
Gordon Stray			2630	2635			
Gordon			2720				
Oil			2722	2732	Oil		
Total Depth				2736			

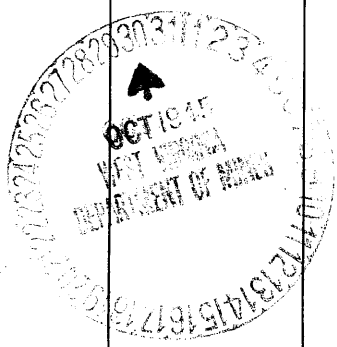

Formation	Color	Hard or Soft	Top	Bottom	Oil, Gas or Water	Depth Found	Remarks

Date October 29, 1945

APPROVED J. Mares Road, Owner

By \_\_\_\_\_ (Title)

