

New Location
 Drill Deeper
 Abandonment

2.00 2.05 W
 4.20 4.27
 JUL 15 1947

Company VALLEY RUN OIL & GAS CO.
 Address CAMERON, W. VA.
 Farm J. L. CARNEY
 Tract 1 Acres 81 Lease No. _____
 Well (Farm) No. 1 Serial No. _____
 Elevation (Spirit Level) 1194
 Quadrangle LITTLETON
 County WETZEL District CENTER
 Engineer GORDON W. SAMMONS
 Engineer's Registration No. 509
 File No. _____ Drawing No. _____
 Date 6-12-47 Scale 1" = 100'

STATE OF WEST VIRGINIA
 DEPARTMENT OF MINES
 OIL AND GAS DIVISION
 CHARLESTON

WELL LOCATION MAP
 FILE NO. Wet-586-A

+ Denotes location of well on United States Topographic Maps, scale 1 to 62,500, latitude and longitude lines being represented by border lines as shown.
 - Denotes one inch spaces on border line of original tracing.



STATE OF WEST VIRGINIA
DEPARTMENT OF MINES
OIL AND GAS DIVISION

1042

AP 586-A

WELL RECORD

Oil or Gas Well Oil

(KIND)


Company Valley Run Oil and Gas Company
 Address Box 186 Cameron, West Virginia
 Farm J. L. Carney Acres 81
 Location (waters) Carney Run
 Well No. one Elev. 1194
 District Center County Wetzel
 The surface of tract is owned in fee by J. L. Carney
Heirs Address Silver Hill,
 Mineral rights are owned by same as above
 Address _____
 Drilling commenced No record
 Drilling completed Well purchased Spring 1924
 Date Shot 11/26/25 From 3145' To 3125'
 With 20 qts. Glycerin

| Casing and Tubing | Used in Drilling | Left in Well | Packers |
|--------------------|------------------|--------------|-----------------------|
| Size | | | Kind of Packer |
| 16 | | | <u>hook-wall</u> |
| 13 | | | Size of <u>5 3/16</u> |
| 10 <u>300'</u> | <u>yes</u> | <u>?</u> | Depth set <u>2330</u> |
| 8 1/4 <u>1590</u> | <u>"</u> | <u>Yes</u> | |
| 6 3/4 <u>2280</u> | <u>"</u> | <u>"</u> | |
| 5 3/16 <u>2325</u> | <u>"</u> | <u>"</u> | |
| 3 | | | Perf. top _____ |
| 2 <u>3157</u> | <u>No</u> | <u>Yes</u> | Perf. bottom _____ |
| Liners Used | <u>None</u> | | Perf. top _____ |
| | | | Perf. bottom _____ |

Open Flow /10ths Water in _____ Inch
 /10ths Merc. in _____ Inch
 Volume _____ Cu. Ft.
 Rock Pressure _____ lbs. _____ hrs.
 Oil two bbls., 1st 24 hrs.
 Fresh water _____ feet _____ feet
 Salt water _____ feet _____ feet

CASING CEMENTED _____ SIZE _____ No. Ft. _____ Date _____
Not cemented
 COAL WAS ENCOUNTERED AT 1105 FEET _____ INCHES
1113 FEET _____ INCHES FEET _____ INCHES
 FEET _____ INCHES FEET _____ INCHES

| Formation | Color | Hard or Soft | Top | Bottom | Oil, Gas or Water | Depth Found | Remarks |
|--------------------|-------|--------------|------|--------|-------------------|-------------|---------|
| Clay | Light | Soft | 0 | 15 | | | |
| Shale | Gray | Med. | 15 | 50 | | | |
| Lime | Gray | Hard | 50 | 100 | water | | |
| Lime-Shells | Dark | Med. | 100 | 800 | | | |
| Lime-Shells | Dark | Hard | 800 | 1005 | | | |
| Coal | Black | Soft | 1005 | 1008 | | | |
| Shale | Light | Hard | 1008 | 1105 | | | |
| Coal | Black | Soft | 1105 | 1113 | | | |
| Lime-Shells | Gray | Med. | 1113 | 1300 | | | |
| Redrock | red | soft | 1300 | 1425 | | | |
| Sand | Light | Hard | 1425 | 1455 | | | |
| Slate & Shells | Light | Med. | 1455 | 1515 | | | |
| Sand | Light | Med. | 1515 | 1540 | | | |
| Lime & Shells | Light | Med. | 1540 | 1590 | | | |
| Sand | Light | Hard | 1590 | 1645 | | | |
| Sand & Lime Shells | Light | Hard | 1645 | 1760 | | | |

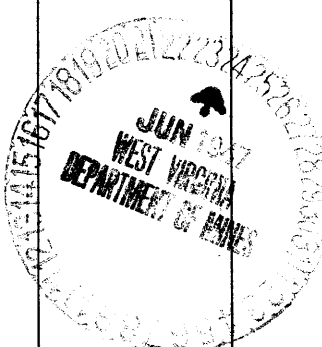

| Formation | Color | Hard or Soft | Top | Bottom | Oil, Gas or Water | Depth Found | Remarks |
|-------------------|------------|--------------|------|--------|-------------------|-------------|---------|
| Sand | Light | Hard | 1760 | 1790 | | | |
| Shells Sand | Light | Hard | 1790 | 1805 | | | |
| Sand | Light | Hard | 1805 | 1825 | | | |
| Slate | Dark | Soft | 1825 | 1855 | | | |
| Sand | Light | Hard | 1855 | 1890 | | | |
| Slate & Shells | Dark | Med. | 1890 | 2215 | | | |
| Sand | Light | Hard | 2215 | 2255 | | | |
| Lime | Light | Hard | 2255 | 2265 | | | |
| Slate | Dark | Soft | 2265 | 2270 | | | |
| Lime | Light | Hard | 2270 | 2325 | | | |
| Sand | Light | Hard | 2325 | 2560 | | | |
| Lime-Shells Slate | Lt. & Dark | Med. | 2560 | 3125 | | | |
| Sand | Light | Hard | 3125 | 3157 | Oil | 3125 | |

Date June 23, 19 47

APPROVED _____, Owner

By _____ (Title)