

Latitude 37 45

Longitude 80 25

Oscar Connor Heirs

Pa.
W.Va.

West 114

State Line.

Apple tree.

south 35
S. 70° W. 26
stone

47.8
S 17° 40' W 12.6
Well #. 3.

66.2
N. 80° 17' E 71.9
House.

Harry Antio.

S. 14° E 37 3/4
stone
S. 3 E 20
stone

S. N. Connor
now
I. H. Lough.

Beech

N. 70° E 69

S. 55° E 23
Beech

HY S. 57° E 27.5
Camp House.

N. 18 1/2° E 18.2
Beech


N. 27° W. 90.4

I. H. Lough.

N. H.C. Cross

S. 89 3/4° E 40.

Stella Bertch

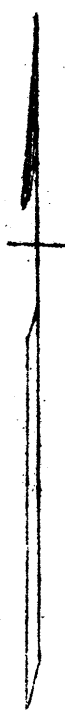

2.38
✓ APR 1948

New Location
Drill Deeper
Abandonment

Company Haight Oil Co.
 Address Hundred W.Va.
 Farm S. N. Connor.
 Tract 1 Acres 53 Lease No. 26467
 Well (Farm) No. 3. Serial No. _____
 Elevation (Spirit Level) 1335'
 Quadrangle Mannington
 County Wetzel District Church
 Engineer A. L. Headley.
 Engineer's Registration No. _____
 File No. _____ Drawing No. _____
 Date 12-24-1946 Scale 1 inch = 30 poles

STATE OF WEST VIRGINIA
DEPARTMENT OF MINES
OIL AND GAS DIVISION
CHARLESTON

WELL LOCATION MAP
FILE NO. Wet-639-A

+ Denotes location of well on United States Topographic Maps, scale 1 to 62,500, latitude and longitude lines being represented by border lines as shown.

- Denotes one inch spaces on border line of original tracing.



STATE OF WEST VIRGINIA
DEPARTMENT OF MINES
OIL AND GAS DIVISION

1073

WELL RECORD

Oil or Gas Well Oil (KIND)


Permit No. 6799A

Company Haught Oil Co., A. H. Snider
 Address Hundred, W. Va.
 Farm S. N. Connor Acres _____
 Location (waters) _____
 Well No. 3 Elev. _____
 District Church County Wetzel
 The surface of tract is owned in fee by _____
 Address _____
 Mineral rights are owned by _____
 Address _____
 Drilling commenced _____
 Drilling completed _____
 Date Shot _____ From _____ To _____
 With _____
 Open Flow _____ /10ths Water in _____ Inch
 _____ /10ths Merc. in _____ Inch
 Volume _____ Cu. Ft.
 Rock Pressure _____ lbs. _____ hrs.
 Oil _____ bbls., 1st 24 hrs.
 Fresh water _____ feet _____ feet
 Salt water _____ feet _____ feet

Casing and Tubing	Used in Drilling	Left in Well	Packers
Size			
16			Kind of Packer _____
13			
10	<u>392'</u>	<u>392'</u>	Size of _____
8 1/4	<u>1528' 9"</u>	<u>1528' 9"</u>	
6 3/8	<u>2271'</u>	<u>2271'</u>	Depth set _____
5 3/16	<u>2900'</u>	<u>2900'</u>	
3			Perf. top _____
2			Perf. bottom _____
Liners Used			Perf. top _____
			Perf. bottom _____

CASING CEMENTED _____ SIZE _____ No. Ft. _____ Date _____
 COAL WAS ENCOUNTERED AT 1060 FEET 72 INCHES
 _____ FEET _____ INCHES FEET _____ INCHES
 _____ FEET _____ INCHES FEET _____ INCHES

Formation	Color	Hard or Soft	Top	Bottom	Oil, Gas or Water	Depth Found	Remarks
Pgh. Coal			1060	1066			
Dunkard.			1560	1615			
Gas Sand.			1745	1780			
Salt Sand.			1878	1915			
2nd Salt			2000	2115			
Pencil Cave,			2250	2260			
Big Jugun			2310	2560			
30 Ft.			2890	2925			
50 ft.			3050	3095			
Gordon Stray.			3129	3145			
1st Pay.				3142	<u>Oil & Gas</u>		
Total Depth.				3150			

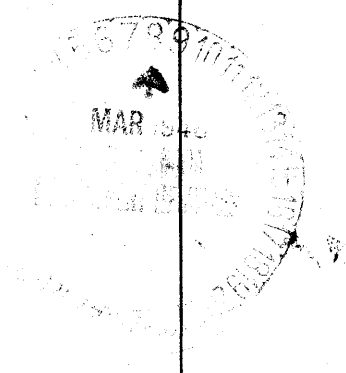

MAR 1944