

New Location
 Drill Deeper
 Abandonment

Company A. M. Snider
 Address Hundred W.Va.
 Farm Suda Ornduff
 Tract 1 Acres Lot Lease No. NE
 Well (Farm) No. 1 Serial No. NE
 Elevation (Spirit Level) 1061'
 Quadrangle Littleton
 County Wetzel District Clay
 Engineer A. L. Headley
 Engineer's Registration No. _____
 File No. _____ Drawing No. _____
 Date 9-23-1948 Scale 1" = 50'

STATE OF WEST VIRGINIA
 DEPARTMENT OF MINES
 OIL AND GAS DIVISION
 CHARLESTON

WELL LOCATION MAP
 FILE NO. WET-727-A

+ Denotes location of well on United States Topographic Maps, scale 1 to 62,500, latitude and longitude lines being represented by border lines as shown.
 - Denotes one inch spaces on border line of original tracing.



STATE OF WEST VIRGINIA
DEPARTMENT OF MINES
OIL AND GAS DIVISION

12-18

WELL RECORD

Permit No. 77A

Oil or Gas Well X (KIND)

Company Duane Snider
Address Hundred, West Virginia
Farm Suda Ornduff Acres Lot
Location (waters) Fishing Creek
Well No. 1 Elev. 1061
District Clay County Wetzel
The surface of tract is owned in fee by Suda Ornduff
Littleton Address West Virginia
Mineral rights are owned by Suda Ornduff
Littleton Address West Virginia
Drilling commenced No Record
Drilling completed No Record
Date Shot See below From _____ To _____
With _____


Casing and Tubing	Used in Drilling	Left in Well	Packers
Size			
16			Kind of Packer
13			
10			Size of
8 1/4	1114	1114	
6 5/8	2018	2018	Depth set
5 3/16			
* 3			Perf. top
2			Perf. bottom
Liners Used			Perf. top
5"	610	610	Perf. bottom

Open Flow _____ /10ths Water in _____ Inch
_____ /10ths Merc. in _____ Inch
Volume _____ Cu. Ft.
Rock Pressure _____ lbs. _____ hrs.
Oil _____ bbls., 1st 24 hrs.
Fresh water _____ feet _____ feet
Salt water _____ feet _____ feet

CASING CEMENTED _____ SIZE _____ No. Ft. _____ Date _____
COAL WAS ENCOUNTERED AT 835 FEET 84 INCHES
____ FEET _____ INCHES FEET _____ INCHES
____ FEET _____ INCHES FEET _____ INCHES

Formation	Color	Hard or Soft	Top	Bottom	Oil, Gas or Water	Depth Found	Remarks
Pittsburgh Coal			835	842			
Big Dunkard Sand			1310	1360	Gas	1560-1580	
First Salt Sand			1590	1610			
Second Salt Sand			1620	1660	Gas	1625	
Little Lime			1985	1992			
Pencil Cave			1992	1996			
Big Lime			1996	2054	Gas	2158	
Big Injun Sand			2054	2315	Gas	2161	
Gordon Stray Sand			2860	2878			
Gordon Sand			2893				
First Oil Pay			2906	2910			
Total Depth				2912			

Shot July 27, 1926 with 20 Qts, from 2904 to 2912

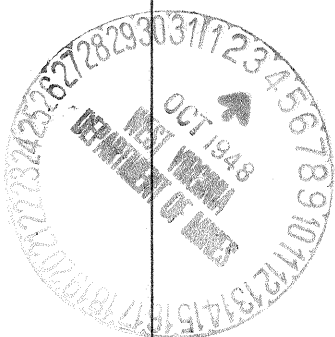

APR 10 1949