

3.35 S
3.79 W

COAL OWNED BY T.L. ROGERSON & EVERETT F. MOORE
MOUNDSVILLE W.VA

NEW LOCATION.....
DRILL DEEPER.....
ABANDONMENT.....

COMPANY The Manufacturers Light and Heat Co.
 ADDRESS 800 Union Trust Bldg. Pittsburgh Pa.
 FARM Sara Ann Sexton
 TRACT _____ ACRES 40 ± LEASE No. 5483
 WELL (FARM) No. 1 SERIAL No. 1912
 ELEVATION (SPIRIT LEVEL) 1305'
 QUADRANGLE Mannington N.W. 1/4
 COUNTY Wetzel DISTRICT Clay
 ENGINEER J. L. Moore
 ENGINEER'S REGISTRATION No. _____
 FILE No. _____ DRAWING No. Y-13-110
 DATE Oct - 8 - 1948 SCALE 1" = 800'

STATE OF WEST VIRGINIA
DEPARTMENT OF MINES
OIL AND GAS DIVISION
CHARLESTON

WELL LOCATION MAP
FILE No. Wet-737-A

+ DENOTES LOCATION OF WELL ON UNITED STATES TOPOGRAPHIC MAPS, SCALE 1 TO 62,500. LATITUDE AND LONGITUDE LINES BEING REPRESENTED BY BORDER LINES AS SHOWN.
 — DENOTES ONE INCH SPACES ON BORDER LINE OF ORIGINAL TRACING.



STATE OF WEST VIRGINIA
DEPARTMENT OF MINES
OIL AND GAS DIVISION

1318
[Handwritten signature]

WELL RECORD

Permit No. 737-A


Oil or Gas Well
(KIND)

Company The Manufacturers Light & Heat Company
Address 800 Union Trust Building
Farm S. A. Sexton Acres 40
Location (waters) _____
Well No. 1912 Elev. _____
District _____ County Wayne
The surface of tract is owned in fee by Sarah A. Masters, Agt.
Littleton, W. Va. Address _____
Mineral rights are owned by The Mfrs. Light & Heat Co.
800 Union Trust Bldg. Address Pittsburgh, Pa.
Drilling commenced May 9th, 1916
Drilling completed April 17th, 1916
Date Shot _____ From _____ To _____
With _____
Open Flow /10ths Water in _____ Inch
_____ /10ths Merc. in _____ Inch
Volume _____ Cu. Ft.
Rock Pressure _____ lbs. _____ hrs.
Oil _____ bbls., 1st 24 hrs.
Fresh water _____ feet _____ feet
Salt water _____ feet _____ feet

Casing and Tubing	Used in Drilling	Left in Well	Packers
Size			
16			Kind of Packer
18			
10	201	NONE	Size of
8 1/4	1378'10"	1378'10"	
6 5/8	2032'10"	2032'10"	Depth set
5 3/16			
3			Perf. top
2			Perf. bottom
Liners Used			Perf. top
			Perf. bottom

CASING CEMENTED _____ SIZE _____ No. Ft. _____ Date _____
COAL WAS ENCOUNTERED AT 480 FEET 72 INCHES
705 FEET 60 INCHES 812 FEET 96 INCHES
1520 FEET 60 INCHES _____ FEET _____ INCHES

Formation	Color	Hard or Soft	Top	Bottom	Oil, Gas or Water	Depth Found	Remarks
Clay			0	120			
Bluff Sand			120	160			
Slate & Lime			160	260			
Red Rock			260	360			
Sand			360	480			
Coal			480	486			
Slate, Lime & Rock			486	586			
Sand			586	686			
Red Rock			686	705			
Coal			705	710			
Slate & Shells			710	812			
Coal Pittsburgh			812	820			
Slate & Lime			820	930			
Sand Murphy			930	960			
Red Rock			960	1060			
Sand			1060	1160			
Slate & Lime			1160	1215			
Little Dunkard			1215	1245			
Red Rock			1245	1300			
Big Dunkard			1300	1345			
Slate			1345	1475			
Gas Sand			1475	1520			
Coal			1520	1525			
Sand			1525	1590			
1st Salt Sand			1590	1610			
Red Rock			1610	1795			
2nd Salt Sand			1795	1885			
Slate & Shells			1885	2005			
Big Lime			2005	2070			
Big Injun			2070	2148			
Slate			2148	2178			
Squaw Sand			2178	2275			
Sand			2275	2305			
Slate, Lime & Rock			2305	2810			
Fifty Foot			2810	2815	Gas 2810	7/10 water	"2" opening
Sand			2815	2873			
Sand			2873	2885			
Gordon Sand			2885	2918	Oil and Gas at 2911		

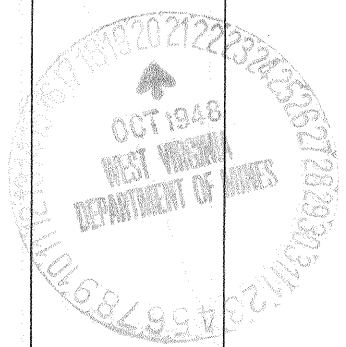

Formation	Color	Hard or Soft	Top	Bottom	Oil, Gas or Water	Depth Found	Remarks
Clay			2918	2945			
Fourth Sand			2945	2966			
Red Rock			2966	3025			
Fifth Sand			3025	3028			
TOTAL DEPTH			3035				

Date OCTOBER 18TH, 1948

APPROVED THE MANUFACTURERS LIGHT & HEAT COMPANY, Owner

By Ben Cooper LAND AGENT.
(Title)

S. A. SEXTON NO. 1912 WELL.

.....District, *Wetzel* County, W. Va. *wetzel 737A*
 By The Manufacturers Light & Heat Co., 800 Union Trust Bldg.,
 Pittsburgh, Pa.

Abandoned under permit-A?

On 40 acres,

Elevation,' L.

Surface owned by Sarah A. Masters, Agent, Littleton, W. Va., and minerals
 by The Manufacturers Light & Heat Co., 800 Union Trust Bldg.,
 Pittsburgh, Pa.

Drilling commenced May 9, 1916; completed April 17, 1916.

10" casing, 201' (pulled); 8 1/2", 1378' 10"; 6 3/8", 2032' 10".

Coal was encountered at 480-486, 705-710, 812-820, and 1520-1525'.

Gas well. Abandonment reported to Dept. of Mines Oct. 18, 1949.

	Top.	Bottom.
Clay	0	120
Bluff Sand	120	160
Slate and lime	160	260
Red rock	260	360
Sand	360	480
Coal	480	486
Slate, lime and rock	486	586
Sand	586	686
Red rock	686	705
Coal	705	710
Slate and shells	710	812
Pittsburgh Coal	812	820
Slate and lime	820	930
Murphy Sand	930	960
Red rock	960	1060
Sand	1060	1160
Slate and lime	1160	1215
Little Dunkard Sand	1215	1245
Red rock	1245	1300
Big Dunkard Sand	1300	1345
Slate	1345	1475
Gas Sand	1475	1520
Coal	1520	1525
Sand	1525	1590
1st Salt Sand	1590	1610
Red rock	1610	1795
2nd Salt Sand	1795	1885
Slate and shells	1885	2005
Big Lime	2005	2070
Big Injun Sand	2070	2148
Slate	2148	2178
Squaw Sand	2178	2275
Sand	2275	2305
Slate, lime and rock	2305	2310
Fifty-foot Sand (gas, 2810', 7/10 W.2")	2310	2815
Sand	2815	2873
Sand	2873	2885
Gordon Sand (oil and gas at 2911')	2885	2918
Clay	2918	2945
Fourth Sand	2945	2966
Red rock	2966	3025
Fifth Sand	3025	3028
Total depth		3035

Clay District, Wetzel County, W. Va.

NOT LOCATED

M. L. & H. Co. No. 1912.

Probably on SA SAXTON

Completed, 1916.

PROPERTY, N-12 Map

Elevation, 1120' E.

Oil and gas well.

On Brown Run.

	Top.	Bottom.
Mapletown Coal (little gas)	705	710
Pittsburgh Coal	812	820
Murphy Sand, soft	930	960
Little Dunkard, hard sh. 1228'	1215	1245
Big Dunkard, Hard	1300	1345
Gas Sand, hard	1475	1520
Coal	1520	1525
1 Salt Sand	1590	1610
2 Salt Sand (gas, 1845')	1795	1885
Big Lime	2005	2070
Big Injun Sand	2070	2256
50-Ft. (gas, 2870')	2810	2876
30-Ft. Sand	2873	2885
Gordon (G. Stray) oil and gas, 2911'	2898	2918
4th (Gordon) Sand	2945	2966
5th (4th) Sand	3025	3028
Total depth		3035