

Surface: Mrs. Opal Ice Francis; R.F.D #1, Martinsburg, W.Va.  
 Coal: Elmer E. Ice Hrs. Address Mrs. Elmer E. Ice,  
 R.F.D, Smithfield, Wetzel Co, W.Va.

4.68 S  
 3.50 W

- New Location...
- Drill Deeper.....
- Abandonment.....

Company The Interstate Pipe & Supply Co.  
 Address Marietta Ohio  
 Farm V.A. Ice  
 Tract \_\_\_\_\_ Acres 125 1/2 Lease No. \_\_\_\_\_  
 Well (Farm) No. 1 Serial No. \_\_\_\_\_  
 Elevation (Spirit Level) Floor - 873.42  
 Ground - 872.92  
 Quadrangle LITTLETON  
 County Wetzel District Grant  
 Engineer E.C. Tabler  
 Engineer's Registration No. \_\_\_\_\_  
 File No. \_\_\_\_\_ Drawing No. \_\_\_\_\_  
 Date Jan. 13<sup>th</sup> 1948 Scale 1" = 400 Feet.

STATE OF WEST VIRGINIA  
 DEPARTMENT OF MINES  
 OIL AND GAS DIVISION  
 CHARLESTON

**WELL LOCATION MAP**  
 FILE NO. Wet-773-A

+ Denotes location of well on United States Topographic Maps, scale 1 to 62,500, latitude and longitude lines being represented by border lines as shown.  
 - Denotes one inch spaces on border line of original tracing.



1197

STATE OF WEST VIRGINIA  
DEPARTMENT OF MINES  
OIL AND GAS DIVISION

AS 773-A

WELL RECORD

Permit No. \_\_\_\_\_ Oil or Gas Well Oil (KIND)

Company The Interstate Pipe & Supply Company  
Address P. O. Box 611, Marietta, Ohio  
Farm V. A. Ioe Acres 125 1/2  
Location (waters) Fallen Timber Run  
Well No. 1 Elev. 872.92  
District Grant County Wetzel  
The surface of tract is owned in fee by Mrs. Opal Ioe Francis  
R. F. D. #1 Address Martinsburg, W. Va.  
Mineral rights are owned by Elmer E. Ioe Heirs, o/o  
Mrs. Elmer E. Ioe Address RFD Smithfield, W. Va.

Casing and Tubing	Used in Drilling	Left in Well	Packers
Size			
16			Kind of Packer
13			
10	162	none	Size of
8 1/4	1178	none	
6 3/8	1932	1932	Depth set
5 3/16	2500	2500	
3			Perf. top
2			Perf. bottom
Liners Used			Perf. top
4 1/2 x 4	390' (top at 2288')		Perf. bottom


Drilling commenced 6/14/12  
Drilling completed 7/27/12  
Date Shot 1912-1925 From 2782 To 2797  
With \_\_\_\_\_  
Open Flow /10ths Water in \_\_\_\_\_ Inch  
/10ths Merc. in \_\_\_\_\_ Inch  
Volume \_\_\_\_\_ Cu. Ft.  
Rock Pressure \_\_\_\_\_ lbs. \_\_\_\_\_ hrs.  
Oil \_\_\_\_\_ bbls., 1st 24 hrs.  
Fresh water \_\_\_\_\_ feet \_\_\_\_\_ feet  
Salt water \_\_\_\_\_ feet \_\_\_\_\_ feet

CASING CEMENTED \_\_\_\_\_ SIZE \_\_\_\_\_ No. Ft. \_\_\_\_\_ Date \_\_\_\_\_  
COAL WAS ENCOUNTERED AT 657 FEET 96 INCHES  
\_\_\_\_\_ FEET \_\_\_\_\_ INCHES FEET \_\_\_\_\_ INCHES  
\_\_\_\_\_ FEET \_\_\_\_\_ INCHES FEET \_\_\_\_\_ INCHES

Formation	Color	Hard or Soft	Top	Bottom	Oil, Gas or Water	Depth Found	Remarks
Pittsburgh Coal			657	665			
Big Dunkard			1119	1125			
Gas Sand			1215	1365			
1st Salt Sand			1450	1520			
2nd Salt Sand			1600	1735			
Little Lime			1900	1908			
Big Lime			1917	1974			
Gas			1980				
Big Injun			1974	2174			
Water			2175		2 bailers per hour		
50 Ft. Sand			---	---			
Stray			2755	2750			
Gordon			2780	2798			
Top of pay			2788	2797			
Total depth				2798			

Record of 4" inserted liner and cave packer used in February 20, 1919, 22' 7" one jt., 21' 10" jt., 22' 5" jt., 22' 2" jts., 1 4" cave packer 2' long, 1 4x6 R & L nipple. Packer set at 2719' 6". Top of liner 2621' 6".--Pulled.

September 5, 1925: Run 309' of 4-1/2" x 4" liner in two sections  
1st section 7 jts.--perforated joint set on bottom, 155' bell collar and nipple on top  
2nd section 153', 7 jts., bell collar and nipple on top. Top of liner 2288'.

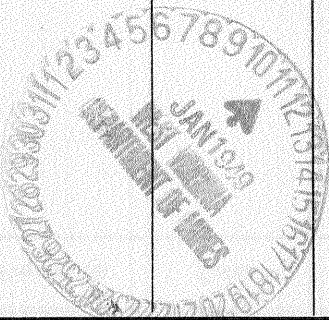

Formation	Color	Hard or Soft	Top	Bottom	Oil, Gas or Water	Depth Found	Remarks

Date January 10, 19 49

APPROVED THE INTERSTATE PIPE & SUPPLY COMPANY, Owner

By Adolph Beru  
(Title) a.