

0152 S
0178 W

Surface owner unknown
Coal owned by Pittsburgh-Consolidation
Coal Co., Fairmont, W. Va.

New Location
Drill Deeper
Abandonment

Company SAM BEREN
Address Marietta, Ohio
Farm B. W. Peterson
Tract Acres 79 Lease No. NE
Well (Farm) No. 26 Serial No.
Elevation (Spirit Level) 1425
Quadrangle Centerpoint
County Wetzel District Grant
Engineer W. H. Johnson
Engineer's Registration No. 1737
File No. Drawing No.
Date Dec. 1948 Scale 1" = 500'

STATE OF WEST VIRGINIA
DEPARTMENT OF MINES
OIL AND GAS DIVISION
CHARLESTON

WELL LOCATION MAP
FILE NO. Wet-804-A

+ Denotes location of well on United States
Topographic Maps, scale 1 to 62,500, lat-
itude and longitude lines being represented
by border lines as shown.

- Denotes one inch spaces on border line
of original tracing.



STATE OF WEST VIRGINIA
DEPARTMENT OF MINES
OIL AND GAS DIVISION

1291

804 A

WELL RECORD


Permit No. 804 A Oil or Gas Well Oil (KIND)

Company Strauss & Beren
Address Marietta, Ohio
Farm B. W. Peterson Acres 79
Location (waters) Stouts Run
Well No. 26 Elev. 1425
District Grant County Wetzel
The surface of tract is owned in fee by _____
Address _____
Mineral rights are owned by Pittsburgh Consolidat-
ion Coal Company Address Wairmont, W. Va.
Drilling commenced July 20, 1908
Drilling completed Oct. 5, 1908
Date Shot _____ From _____ To _____
With _____
Open Flow _____ /10ths Water in _____ Inch
_____ /10ths Merc. in _____ Inch
Volume _____ Cu. Ft.
Rock Pressure _____ lbs. _____ hrs.
Oil _____ bbls., 1st 24 hrs.
Fresh water _____ feet _____ feet
Salt water _____ feet _____ feet

Casing and Tubing	Used in Drilling	Left in Well	Packers
Size			
16			Kind of Packer
13			
10	252'	None	Size of
8 1/4	1338'	None	
6 5/8	2557'	2557'	Depth set
5 3/16	2749'	2749'	
3			Perf. top
2			Perf. bottom
Liners Used	750' - 4" x 4 1/2"		Perf. top
			Perf. bottom

CASING CEMENTED _____ SIZE _____ No. Ft. _____ Date _____
COAL WAS ENCOUNTERED AT 1340 FEET _____ INCHES
_____ FEET _____ INCHES FEET _____ INCHES
_____ FEET _____ INCHES FEET _____ INCHES

Formation	Color	Hard or Soft	Top	Bottom	Oil, Gas or Water	Depth Found	Remarks
Pittsburgh Coal			1340	1346			
Little Dunkard			1695	1730			
Big Dunkard			1820	1850			
Salt Sand			2240	2340			
Little Lime			2545	2555			
Pencil Cave			2555	2557			
Big Lime			2557	2607			
Big Injun			2607	2728			
50' Sand			3090	3115			
30' Sand			3215	3250			
Stray Sand			3394	3402			
Gordon Sand			3437	3459			
TOTAL DEPTH				3459			

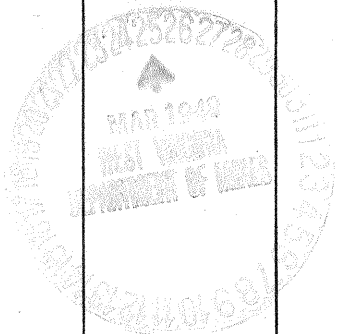

MAR 6 1909