

879-A S 1.71  
 #5232 | W 2.53  
 ---  
 880-A S 1.64  
 #5442 W 2.79

New Location   
 Drill Deeper   
 Abandonment  5232

Map Sh. 38 N 8 W 5 FB. 971 P-34-35-36.

Company Hope Natural Gas Co  
 Address Clarksburg, W.Va.  
 Farm C. A. Long  
 Tract \_\_\_\_\_ Acres 90 Lease No. 34715  
 Well (Farm) No. \_\_\_\_\_ Serial No. As Shown  
 Elevation (Spirit Level) As Shown  
 Quadrangle Littleton  
 County Wetzel District Green  
 Engineer Wm Bowers  
 Engineer's Registration No. 900  
 File No. \_\_\_\_\_ Drawing No. \_\_\_\_\_  
 Date 11-7-50 Scale 1" = 40P

STATE OF WEST VIRGINIA  
 DEPARTMENT OF MINES  
 OIL AND GAS DIVISION  
 CHARLESTON

**WELL LOCATION MAP**

FILE NO. Wet - 879-A - #5232  
Wet - 880-A - #5442

+ Denotes location of well on United States Topographic Maps, scale 1 to 62,500, latitude and longitude lines being represented by border lines as shown.

- Denotes one inch spaces on border line of original tracing.



STATE OF WEST VIRGINIA  
DEPARTMENT OF MINES  
OIL AND GAS DIVISION

1324

Ab 880-A

WELL RECORD

Permit No. \_\_\_\_\_ ~~Oil~~ or Gas Well \_\_\_\_\_ (KIND)


Company Hope Natural Gas Company.  
Address 445 West Main St. Clarksburg, W. Va.  
Farm C.A. Long. Acres 90  
Location (waters) \_\_\_\_\_  
Well No. 5442 Elev. 943  
District Green County Wetzel  
The surface of tract is owned in fee by \_\_\_\_\_  
Address \_\_\_\_\_  
Mineral rights are owned by \_\_\_\_\_  
Address \_\_\_\_\_  
Drilling commenced April 26, 1919  
Drilling completed June 10, 1919  
Date Shot \_\_\_\_\_ From \_\_\_\_\_ To \_\_\_\_\_  
With \_\_\_\_\_  
Open Flow \_\_\_\_\_ /10ths Water in \_\_\_\_\_ Inch  
\_\_\_\_\_ /10ths Merc. in \_\_\_\_\_ Inch  
Volume \_\_\_\_\_ Cu. Ft.  
Rock Pressure \_\_\_\_\_ lbs. \_\_\_\_\_ hrs.  
Oil \_\_\_\_\_ bbls., 1st 24 hrs.  
Fresh water none recorded feet \_\_\_\_\_ feet  
Salt water none recorded feet \_\_\_\_\_ feet

Casing and Tubing	Used in Drilling	Left in Well	Packers
Size			
16			Kind of Packer _____
13			
10	<u>401</u>	<u>Pulled</u>	Size of _____
8 1/4	<u>1230</u>	<u>1230</u>	
6 5/8	<u>1878</u>	<u>1878</u>	Depth set _____
5 3/16	<u>2626</u>	<u>2626</u>	
3			Perf. top _____
2	<u>2822</u>	<u>2822</u>	Perf. bottom _____
Liners Used			Perf. top _____
			Perf. bottom _____

NOT CASING CEMENTED \_\_\_\_\_ SIZE \_\_\_\_\_ No. Ft. \_\_\_\_\_ Date \_\_\_\_\_

COAL WAS ENCOUNTERED AT 290 FEET 36 INCHES  
667 FEET 36 INCHES FEET INCHES  
FEET INCHES FEET INCHES

Formation	Color	Hard or Soft	Top	Bottom	Oil, Gas or Water	Depth Found	Remarks
Coal			290	293			
Pittsburgh Coal			667	670			
Little Dunkard			1128	1140			
Big Dunkard			1220	1240			
Gas sand			1275	1300			
First Salt			1416	1446			
Second Salt			1500	1555			
Little Lime			1818	1830			
Pencil cave			1830	1842			
Big Lime			1842	1919			
Big Injun			1919	2160	gas	1933	
Gantz			2303	2332			
Gorson Stray			2729	2770	gas	2731	
Total depth				2805			

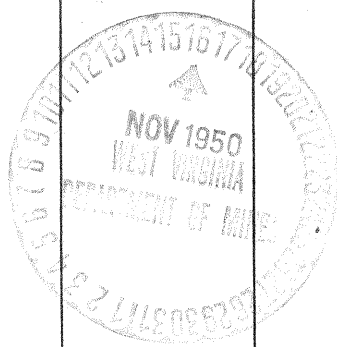

(Over)

FEB 23 1951

