

30895  
Green

New Location   
 Drill Deeper   
 Abandonment  E 4223

Map Sh 39 NT W2 F7906 P-21-22-23

Company	Hope Natural Gas Co
Address	Clarksburg Wyo
Farm	Aaron Bassett
Tract	Acres 290 Lease No. 68
Well (Farm) No.	Serial No. 7222

STATE OF WEST VIRGINIA  
 DEPARTMENT OF MINES  
 OIL AND GAS DIVISION  
 CHARLESTON

**WELL LOCATION MAP**

FILE NO. W-4 - 295.2 - 4/22/23



1376

STATE OF WEST VIRGINIA  
DEPARTMENT OF MINES  
OIL AND GAS DIVISION

WELL RECORD

Permit No. 895-A

Other Gas Well (KIND)


Company Hope Natural Gas Company  
 Address 445 West Main St., Clarksburg, W. Va.  
 Farm Aaron Bassett Acres 290  
 Location (waters) \_\_\_\_\_  
 Well No. 4223 Elev. 893  
 District Green, County Wetzel  
 The surface of tract is owned in fee by \_\_\_\_\_  
 Address \_\_\_\_\_  
 Mineral rights are owned by \_\_\_\_\_  
 Address \_\_\_\_\_  
 Drilling commenced June 1, 1916  
 Drilling completed July 31, 1916  
 Date Shot \_\_\_\_\_ From \_\_\_\_\_ To \_\_\_\_\_  
 With \_\_\_\_\_

Casing and Tubing	Used in Drilling	Left in Well	Packers
Size			Kind of Packer
16			
13			
10	303	303	Size of
8 1/4	1136	1136	
6 3/8	1804	1804	Depth set
5 3/16			
3			Perf. top
2	2700	Pulled	Perf. bottom
Liners Used			Perf. top
			Perf. bottom

Open Flow \_\_\_\_\_ /10ths Water in \_\_\_\_\_ Inch  
 \_\_\_\_\_ /10ths Merc. in \_\_\_\_\_ Inch  
 Volume \_\_\_\_\_ Cu. Ft.  
 Rock Pressure \_\_\_\_\_ lbs. \_\_\_\_\_ hrs.  
 Oil \_\_\_\_\_ bbls., 1st 24 hrs.  
 Fresh water none recorded feet \_\_\_\_\_ feet  
 Salt water none recorded feet \_\_\_\_\_ feet

CASING CEMENTED NOT SIZE \_\_\_\_\_ No. Ft. \_\_\_\_\_ Date \_\_\_\_\_  
 COAL WAS ENCOUNTERED AT 210 FEET 60 INCHES  
580 FEET 60 INCHES FEET INCHES  
 FEET INCHES FEET INCHES

Formation	Color	Hard or Soft	Top	Bottom	Oil, Gas or Water	Depth Found	Remarks
Coal			210	215			
Coal			580	585			
Little Dunkard			955	975			
Big Dunkard			1131	1161			
First Salt			1450	1475			
Second Salt			1555	1570			
Maxon			1695	1725			
Little Lime			1777	1787			
Pencil cave			1787	1789			
Big Lime			1789	1883			
Big Injun			1883	2096	gas	1883	
Squaw			2105	2120			
Berea			2300	2304			
Gordon stray			2646	2650			
Gordon			2654	2692	gas	2654	
Fourth			2700	2720			
Fifth			2794	2799			
Total depth				2804			

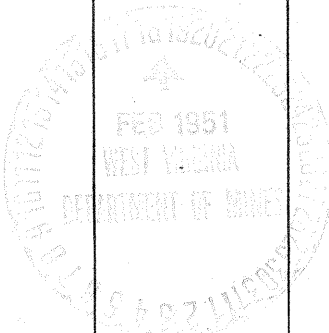

Formation	Color	Hard or Soft	Top	Bottom	Oil, Gas or Water	Depth Found	Remarks

Date February 6, 1951, 19

APPROVED Hope Natural Gas Company., Owner

By \_\_\_\_\_

