


30910
GRANT

39° 35'

80° 30'

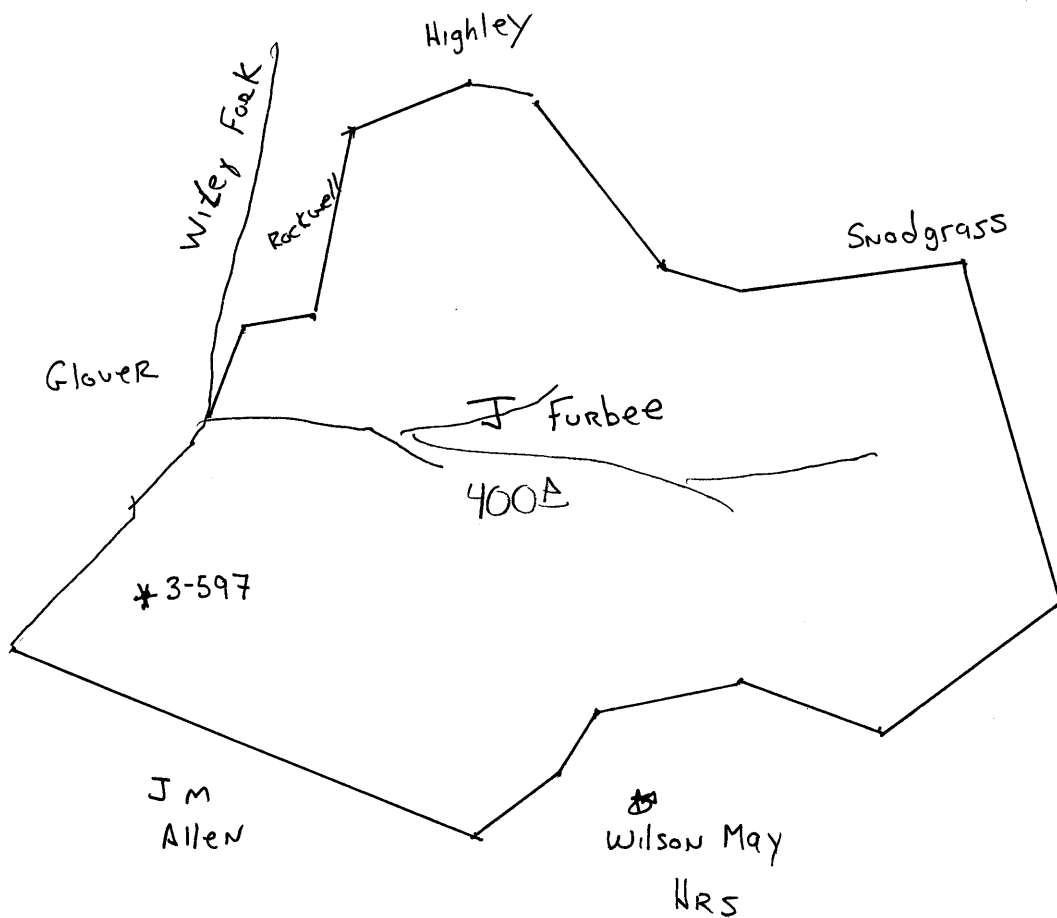

CARNEGIE NAT GAS

Sarah J Furbee #3-597



STATE OF WEST VIRGINIA
DEPARTMENT OF MINES
OIL AND GAS DIVISION

1347

Ad 910-A

WELL RECORD
WELL TO BE ABANDONED

Oil or Gas Well GAS
(KIND)

Company CARNEGIE NATURAL GAS COMPANY,
Address 1015 Frick Building, Pittsburgh, Pa.
Farm Sarah J. Furbee Acres 400
Location (waters) Wiley Fork
Well No. 3-597 Elev. 1250'
District Grant County Netzel
The surface of tract is owned in fee by W. S. Furbee Estate,
ary H., Howard R. & R.D. Furbee Trustees, Address Hannington, W. Va.
Mineral rights are owned by Same
Address _____


Drilling commenced August 23, 1916
Drilling completed September 13, 1916
Date Shot _____ From _____ To _____
With _____
Open Flow _____ /10ths Water in _____ Inch
_____ /10ths Merc. in _____ Inch
Volume _____ 760,000 Cu. Ft.
Rock Pressure _____ lbs. _____ hrs.
Oil _____ bbls., 1st 24 hrs.
Fresh water 100 feet _____ feet
Salt water 1715 feet _____ feet

Casing and Tubing	Used in Drilling	Left in Well	Packers
Size			Kind of Packer
16			
13			
10	<u>294</u>	<u>294</u>	Size of
8 3/4	<u>1325</u>	<u>1325</u>	
6 3/4			Depth set
5 3/16			
3			Perf. top
2			Perf. bottom
Liners Used			Perf. top
			Perf. bottom

CASING CEMENTED _____ SIZE _____ No. Ft. _____ Date _____

COAL WAS ENCOUNTERED AT 731 FEET _____ INCHES
831 FEET _____ INCHES FEET _____ INCHES
_____ FEET _____ INCHES FEET _____ INCHES

Formation	Color	Hard or Soft	Top	Bottom	Oil, Gas or Water	Depth Found	Remarks
Mapleton Coal			731	734	Water	100, 175	
Pittsburgh Coal			831	836	Show Gas		
Little Dunkard			1166	1180			
Big Dunkard			1305	1345			
Gas Sand			1565	1678	Gas	1589	
First Salt Sand			1704	1737	Water	1715	
Second Salt Sand			1765	1770			
Third Salt Sand			1780	1848	Gas	1842 - 1848	
			Total Depth	1848			

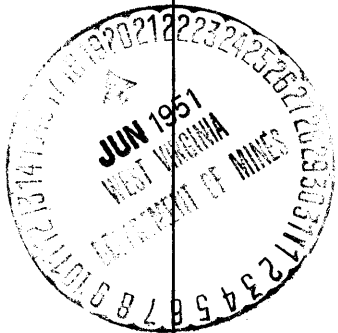

Formation	Color	Hard or Soft	Top	Bottom	Oil, Gas or Water	Depth Found	Remarks

Date June 18, 1951

APPROVED CARNEGIE NATURAL GAS COMPANY, Owner

By B. H. Archer
(Title) Land Agent