

**Latitude**

**Longitude**

2.295  
.11w

**Topo Location**

7.5' Loc. \_\_\_\_\_ 15' Loc. \_\_\_\_\_  
\_\_\_\_\_ (calc.) \_\_\_\_\_

**Company** Hope Nat Gas Co  
**Farm** Fox Hrs # 897  
**15' Quad** \_\_\_\_\_  
(sec.)  
**7.5' Quad** Porters Falls  
**District** Green

**WELL LOCATION PLAT**

**County** 103 **Permit** 30927

R. Butler

Wm  
Gadd


R. Lemasters

897

Fox Hrs  
60<sup>△</sup>

E  
Pittman

H Butler

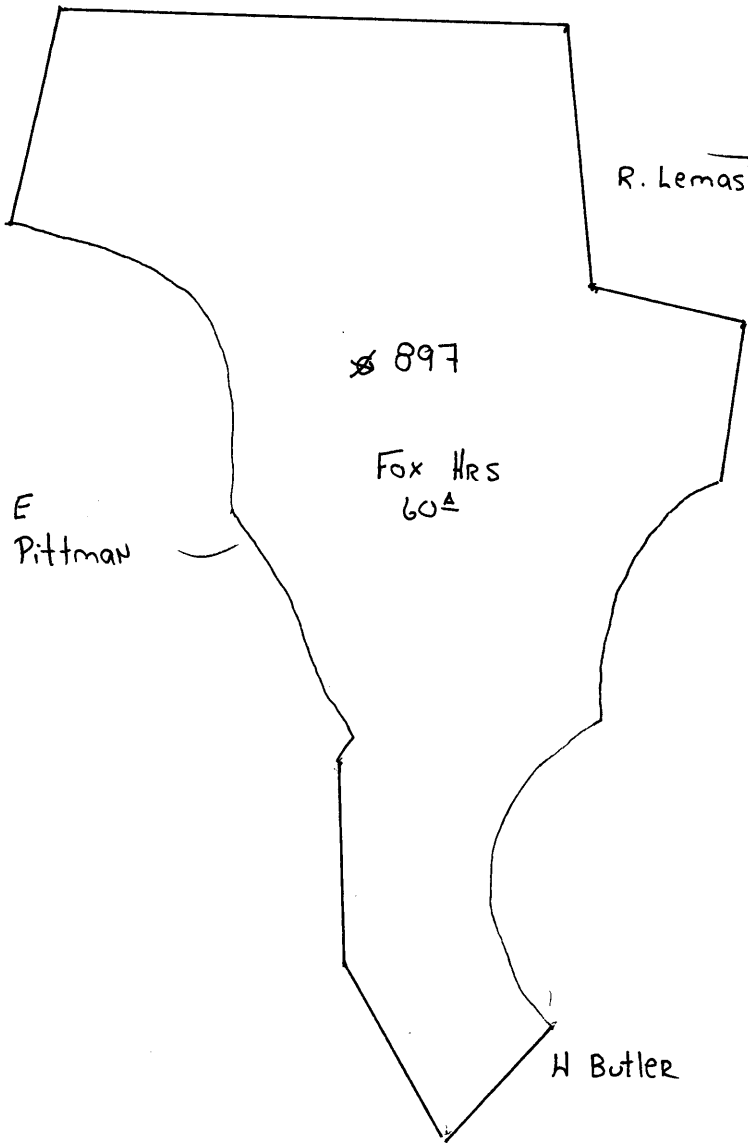



STATE OF WEST VIRGINIA  
DEPARTMENT OF MINES  
OIL AND GAS DIVISION

1246

WELL RECORD

Permit No. 907 A ~~Oil~~ Gas Well (KIND)

Company Hope Natural Gas Company.  
Address 445 West Main St., Clarksburg, W. Va.  
Farm Fox Hrs. Acres 60  
Location (waters) \_\_\_\_\_  
Well No. 897 Elev. 1270  
District Green County Wetzel  
The surface of tract is owned in fee by \_\_\_\_\_  
Address \_\_\_\_\_  
Mineral rights are owned by \_\_\_\_\_  
Address \_\_\_\_\_  
Drilling commenced Jan. 14, 1907  
Drilling completed Mar. 22, 1907  
Date Shot \_\_\_\_\_ From \_\_\_\_\_ To \_\_\_\_\_  
With \_\_\_\_\_  
Open Flow \_\_\_\_\_ /10ths Water in \_\_\_\_\_ Inch  
\_\_\_\_\_ /10ths Merc. in \_\_\_\_\_ Inch  
Volume \_\_\_\_\_ Cu. Ft.  
Rock Pressure \_\_\_\_\_ lbs. \_\_\_\_\_ hrs.  
Oil \_\_\_\_\_ bbls., 1st 24 hrs.  
Fresh water \_\_\_\_\_ feet \_\_\_\_\_ feet  
Salt water 1965 feet \_\_\_\_\_ feet

Casing and Tubing	Used in Drilling	Left in Well	Packers
Size			Kind of Packer
16			
13	<u>40</u>	<u>40</u>	
10	<u>1451</u>	<u>1451</u>	Size of
8 1/4	<u>1980</u>	<u>1980</u>	
6 1/2	<u>2195</u>	<u>2195</u>	Depth set
5 3/16			
3			Perf. top
2	<u>2238</u>	<u>Pulled</u>	Perf. bottom
Liners Used			Perf. top
			Perf. bottom

~~NOT~~  
CASING CEMENTED \_\_\_\_\_ SIZE \_\_\_\_\_ No. Ft. \_\_\_\_\_ Date \_\_\_\_\_  
COAL WAS ENCOUNTERED AT 960 FEET ? INCHES  
\_\_\_\_\_ FEET \_\_\_\_\_ INCHES FEET \_\_\_\_\_ INCHES  
\_\_\_\_\_ FEET \_\_\_\_\_ INCHES FEET \_\_\_\_\_ INCHES

Formation	Color	Hard or Soft	Top	Bottom	Oil, Gas or Water	Depth Found	Remarks
Pittsburgh Coal			960	967 Est.			
Little Dunkard			1365	1396			
Big Dunkard			1465	1500			
Gas sand			1630	1655			
First Salt			1755	1800			
Second Salt			1960	2010	water	1965	
Little Lime			2100	2120			
Pencil cave			2120	2128			
Big Lime			2175	2201			
Big Injun			<del>2175</del> 2201		gas	2206	
Total Depth				2246			

Formation	Color	Hard or Soft	Top	Bottom	Oil, Gas or Water	Depth Found	Remarks



Date August 15, 1951, 19\_\_

APPROVED Hope Na ural Gas Company., Owner

By \_\_\_\_\_

(Title)