

39°45'00"

Latitude

80°40'00"

Longitude

+ 11.83s
:58w

Topo Location


Actually plots in
Meade District of
Marshall Co

7.5' Loc. _____ 15' Loc. _____
_____ (calc.) _____

Company Valley Steele Prod. Co.
Farm HENRY Mason #6
15' Quad _____
(sec.)
7.5' Quad Wileyville
District Meade (RECORDED AS WETZEL)

WELL LOCATION PLAT

County 103 **Permit** 30977

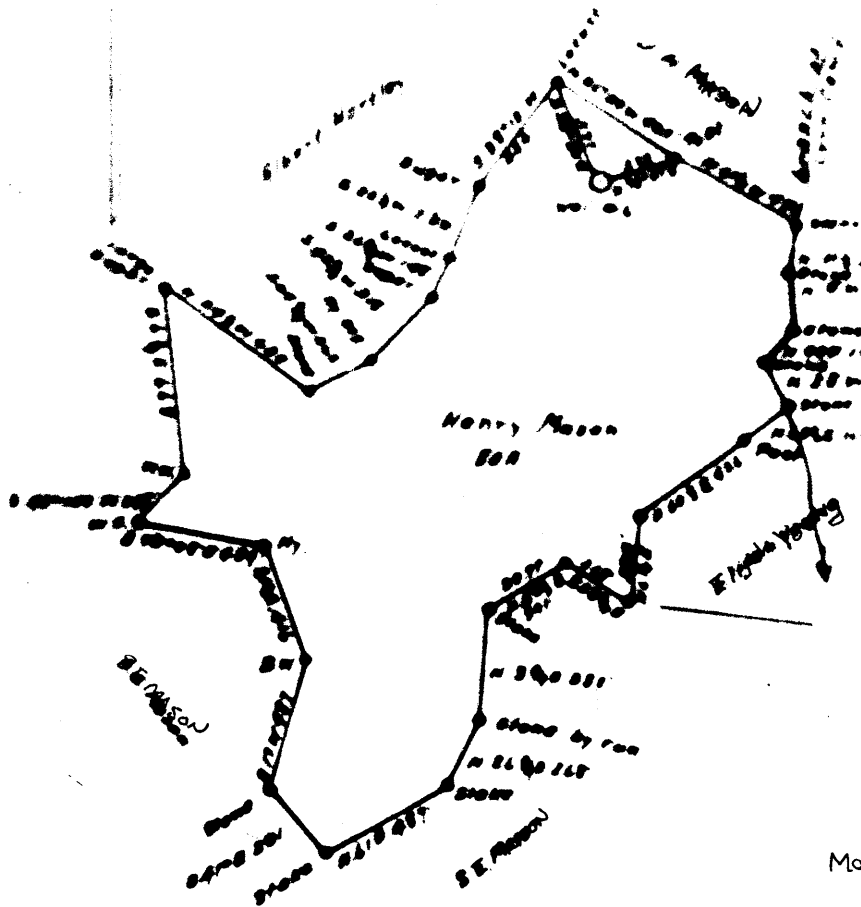

Marshall Co?

Surface: S.C. Young
 R. E. Cameron, W. Va.
 Coal: Adaline Coal Co.
 % Hugh N. Jones
 Oil: Reed Bros. Pittsburg.

See Location
 See Owner
 Abandonment

Company	Henry Steele Products Co
Address	St. Louis, Mo
Name	Henry Mason
Tract	1 Acres 80 Lease No.
Map (Pages) No.	6 Cont. No.
Section	(Spot Level) 1120'
Geographic	Cameron
County	Marshall District Made

STATE OF WEST VIRG.
 DEPARTMENT OF MINES
 OIL AND GAS DIVISION
 CHARLESTON

WELL LOCATION
 FILE NO. WEE-9

↓ Denotes location of well on U.S. Topographic Maps, scale 1 to 6. Hubs and latitude lines being.

30977

WELL RECORD

Permit No. _____

Oil or Gas Well _____

Company Valley Steel Products Co.
 Address Sta. L. Co., Mo.
 Farm Henry Mason Acres _____
 Location (town) _____ Elev. _____
 Well No. 5
 District Merino County Wetzel
 The surface of tract is owned by _____
 Mineral rights are owned by _____
 Drilling commenced _____
 Drilling completed Sept. 4, 1902
 Date Shot From _____ To _____
 With _____
 Open Flow /10ths Water _____ Inch
 /10ths Merc. _____ Inch
 Volume _____ Cu. Ft.
 Rock Pressure _____ lbs.
 Oil _____ lbs. per 24 hrs.
 Fresh water _____ feet
 Salt water _____ feet

Casing and Tubing	Used in Drilling	Left in Well	Feet
10			Kind of Packer
12			Size of _____
10			Depth set _____
8 1/2		<u>2411</u>	Feet top _____
8		<u>2400</u>	Feet bottom _____
8		<u>2330</u>	Feet top _____
			Feet bottom _____

CASING CEMENTED _____ No. Ft. _____ Date _____

COAL WAS ENCOUNTERED AT 800 FEET 60 INCHES
920 FEET 120 INCHES FEET INCHES
 FEET INCHES FEET INCHES

Formation	Color	Hard or Soft	Top	Bottom	Oil, Gas or Water	Depth Found	Remarks
Mapleton Coal			800	805			
Pgh. Coal			920	930			
Salt.			1665	1765			
Big Linn			1985	2024			
" Injan			2024	2335			
Gordon Stray.			2899	2904			
" Sand			2919	2930	Oil	2920-2930	
Total Depth				2934.			



AFFIDAVIT SHOULD BE MADE IN TRIPlicate AND ONE COPY SHOULD BE FILED IN THE OFFICE OF THE STATE SUPERVISOR OF MINING AND ONE COPY SHOULD BE FILED IN THE OFFICE OF THE STATE SUPERVISOR OF OIL AND GAS.

Adaline Coal Co.
 COAL OPERATOR OF WELLS
 1014 Grant Bldg. 1st Fl. N.W.
 ADDRESS

Valley Steel Product Co.
 WELL OPERATOR
 21. 1st St. N.E.
 ADDRESS

COAL OPERATOR OF WELLS

WELL NO. **112** Section **18 52**

Meade District

W-1001 County

NAME OF PROPERTY OWNER

Well No. **512**

Henry Rosen Owner

STATE SUPERVISOR SUPERVISING PLUMBERS

L.F. Donist


AFFIDAVIT

STATE OF WEST VIRGINIA.

County of **Netool**

Walter Conley and **George Hestler**
 being first duly sworn according to law depose and say that they are experienced in the work of plugging and filling oil and gas wells and were employed by **Valley Steel** well operator, and participated in the work of plugging and filling the above well, that said work was commenced on the **7th** day of **July** **1952**, and that the well was plugged and filled in the following manner:

NAME OF THE WELLS	PLUGGING MATERIAL		PLUGGED WITH	QUANTITY	REMARKS
	DEPTH	TO			
	Clay	2214	2400		
	Cement	2000	2200	2000	F.
	Bridge	2000	Stone pt., 2300		
	Clay	2300	1900	2000	1/2"
	Cement	1900	1800	2100	5/16"
	Clay	1800	1615	700	5/8"
	Cement	1615	1400		
	Bridge	1400	Stone pt., 900		
	Clay	900	800		
	Cement	800	800		Pgh Coal
	Clay	800	835		
	Cement	835	700		Mapletown Coal
	Clay	700	to surface.		
	Pgh Coal	960	800		
	Mapletown	835	700		erected marker according to law.

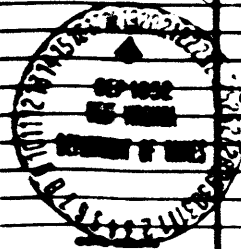

and that the work of plugging and filling said well was completed on the **16th** day of **July**, **1952**.

And further deponents saith not.

Sworn to and subscribed before me this **31** day of **July**, **1952**.

Walter Conley
George Hestler
Henry Rosen

My commission expires:

Notary Public