

Company CARNEGIE NATURAL GAS

Address PITTSBURGH, PA

Farm MARY C. SIX

Tract \_\_\_\_\_ Acres 59 Lease No. E-65074

Well (Farm) No. 1 Serial No. E-655

Elevation (Spirit Level) 1200

Quadrangle LITTLETON S.E.

County WETZEL District GRANT

Engineer J. H. [Signature]

Engineer's Registration No. 1850

File No. \_\_\_\_\_ Drawing No. \_\_\_\_\_

Date 1-30-53 Scale 1" = 40 Poles

STATE OF WEST VIRGINIA  
 DEPARTMENT OF MINES  
 OIL AND GAS DIVISION  
 CHARLESTON

**WELL LOCATION MAP**  
 FILE NO. Wet-989-A

+ Denotes location of well on United States Topographic Maps, scale 1 to 62,500, latitude and longitude lines being represented by border lines as shown.

- Denotes one inch spaces on border line of original tracing.

MARY C. SIX M. 1 (E-655) CARNEGIE N.G. Co. - WET-989-A



STATE OF WEST VIRGINIA  
DEPARTMENT OF MINES  
OIL AND GAS DIVISION

1415

WELL RECORD  
GAS WELL TO BE ABANDONED

Oil or Gas Well Gas  
(KIND)


Permit No. 989A  
Company Carnegie Natural Gas Company  
Address 1015 Frick Building, Pittsburgh 19, Pa.  
Farm Mary C. Six Acres 59  
Location (waters) Branch of Wiley Fork  
Well No. 655 Elev. 1200  
District Grant County Wetzel  
The surface of tract is owned in fee by Bruce Brookover  
Address Jacksonburg, W. Va.  
Mineral rights are owned by See Below  
Address \_\_\_\_\_  
Drilling commenced 10-19-16  
Drilling completed 1-17-17  
Date Shot \_\_\_\_\_ From \_\_\_\_\_ To \_\_\_\_\_  
With \_\_\_\_\_  
Open Flow 3/10ths Water in 5-3/16 Inch  
\_\_\_\_\_ /10ths Merc. in \_\_\_\_\_ Inch  
Volume \_\_\_\_\_ Cu. Ft.  
Rock Pressure \_\_\_\_\_ lbs. \_\_\_\_\_ hrs.  
Oil \_\_\_\_\_ bbls., 1st 24 hrs.  
Fresh water \_\_\_\_\_ feet \_\_\_\_\_ feet  
Salt water 1959 feet \_\_\_\_\_ feet

Casing and Tubing	Used in Drilling	Left in Well	Packers
Size			
16			Kind of Packer
13			
10	697	None	Size of
8 3/4	1606	None	
6 5/8	2029	2029	Depth set
5 3/16	2265	2265	
3			Perf. top
2			Perf. bottom
Liners Used			Perf. top
			Perf. bottom

CASING CEMENTED \_\_\_\_\_ SIZE \_\_\_\_\_ No. Ft. \_\_\_\_\_ Date \_\_\_\_\_  
COAL WAS ENCOUNTERED AT 905 FEET \_\_\_\_\_ INCHES  
1000 FEET \_\_\_\_\_ INCHES FEET \_\_\_\_\_ INCHES  
\_\_\_\_\_ FEET \_\_\_\_\_ INCHES FEET \_\_\_\_\_ INCHES

Formation	Color	Hard or Soft	Top	Bottom	Oil, Gas or Water	Depth Found	Remarks
Mapleton Coal			905	907			
Pittsburgh Coal			1000	1005			
Little Dunkard			1420	1440			
Big Dunkard			1470	1500			
Gas Sand			1654	1679			
1st Salt Sand			1744	1765			
2nd Salt Sand			1894	2049	Water	1959	
Pencil Cave			2183	2198			
Big Line			2198	2265			
Big Injun			2265	2480	Gas	2268	
50 Foot Sand			2835	2850			
30 Foot Sand			2960	2966			
Gordon Sand			3045	3084			
4th Sand			3112	3140	Gas	3115	
5th Sand			3175	3192			
TOTAL DEPTH				3221			

Owners of Mineral Rights:  
Roxie H. Brookover,  
Jacksonburg, W. Va.  
R. M. Brookover,  
Jacksonburg, W. Va.  
Lorraine Kilcoyne,  
Smithfield, W. Va.  
Heirs of A. A. Merrifield,  
Sarah V. Merrifield, Attorney-in-fact,  
Jacksonburg, W. Va.

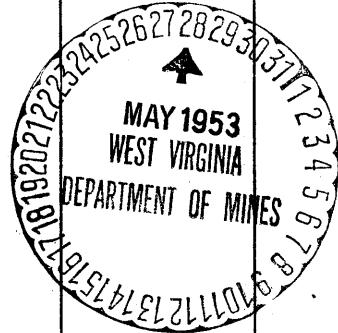

Formation	Color	Hard or Soft	Top	Bottom	Oil, Gas or Water	Depth Found	Remarks

Date May 27, \_\_\_\_\_, 19 53

APPROVED Carnegie Natural Gas Company, Owner

By B. H. Archer  
(Title) Land Agent