

New Location...
 Drill Deeper.....
 Abandonment.....

AUG 3 1953

Company CARNEGIE NATURAL GAS
 Address PITTSBURGH PA
 Farm F.M. WADE
 Tract _____ Acres 130 Lease No. E9390-71
 Well (Farm) No. 2 Serial No. E1195
 Elevation (Spirit Level) 1333'
 Quadrangle LITTLETON NE.
 County WETZEL District CENTER
 Engineer J. M. Wade
 Engineer's Registration No. 1850
 File No. _____ Drawing No. _____
 Date 7-1-53 Scale 1"=40 FEET

STATE OF WEST VIRGINIA
 DEPARTMENT OF MINES
 OIL AND GAS DIVISION
 CHARLESTON

WELL LOCATION MAP
 FILE NO. Wet-991-A

+ Denotes location of well on United States Topographic Maps, scale 1 to 62,500, latitude and longitude lines being represented by border lines as shown.
 - Denotes one inch spaces on border line of original tracing.



STATE OF WEST VIRGINIA
DEPARTMENT OF MINES
OIL AND GAS DIVISION

1421

WELL RECORD
WELL TO BE ABANDONED

Oil or Gas Well Oil
(KIND)


Permit No. 991A
Company Carnegie Natural Gas Company,
Address 1015 Frick Building, Pittsburgh 19, Pa.
Farm F. M. Wade Acres 130
Location (waters) Knob Fork
Well No. 2-1195 Elev. 1333
District Center County Wetzel
The surface of tract is owned in fee by Price A. Gorby
Wets Address W. Va.
Mineral rights are owned by F. M. Wade Heirs
Littleton Address W. Va.
Drilling commenced 9-3-23 D. D. 3-3-26
Drilling completed 10-23-23 D. D. 4-17-26
Date Shot 4-22-26 From 3289 To 3295
With 16 qts.

Casing and Tubing	Used in Drilling	Left in Well	Packers
Size			
16			Kind of Packer
13			
10	290	290	Size of
8 3/4	1710	1710	
6 5/8	2407	2407	Depth set
5 3/16			
3			Perf. top
2	3300	3300	Perf. bottom
Liners Used			Perf. top
			Perf. bottom

Open Flow /10ths Water in _____ Inch
/10ths Merc. in _____ Inch
Volume _____ Cu. Ft.
Rock Pressure _____ lbs. _____ hrs.
Oil 4 bbls. week _____ bbls., 1st 24 hrs.
Fresh water 160 feet _____ feet
Salt water 2020 feet _____ feet

CASING CEMENTED _____ SIZE _____ No. Ft. _____ Date _____
COAL WAS ENCOUNTERED AT 1130 FEET _____ INCHES
1230 FEET _____ INCHES FEET _____ INCHES
_____ FEET _____ INCHES FEET _____ INCHES

Formation	Color	Hard or Soft	Top	Bottom	Oil, Gas or Water	Depth Found	Remarks
Mapleton Coal			1130	1135			
Pittsburgh Coal			1230	1236			
Little Dunkard			1623	1673			
Big Dunkard			1705	1745			
Gas Sand			1875	1915			
1st Salt Sand			2006	2023	Gas Water	2007 2020	
2nd Salt Sand			2095	2130			
3rd Salt Sand			2220	2265			
Little Lime			2348	2372			
Pencil Cave			2372	2375			
Big Lime			2375	2435			
Big Injun Sand			2435		Gas Gas	2440-2445 2510-2513	
Total Depth 10-22-23				2535			
Big Injun Sand				2694			
Gordon Stray			3279	3298	Oil	3289-3294	
Total Depth 4-17-26				3300			

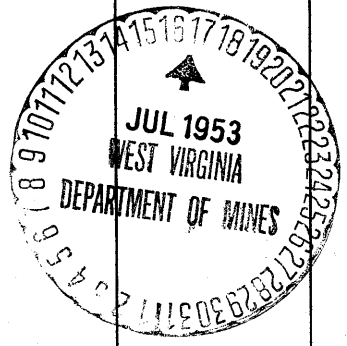

JAN 2 1954
JAN 2 RECD
(Over)

