


Latitude 39° 35'

Longitude 80° 40'

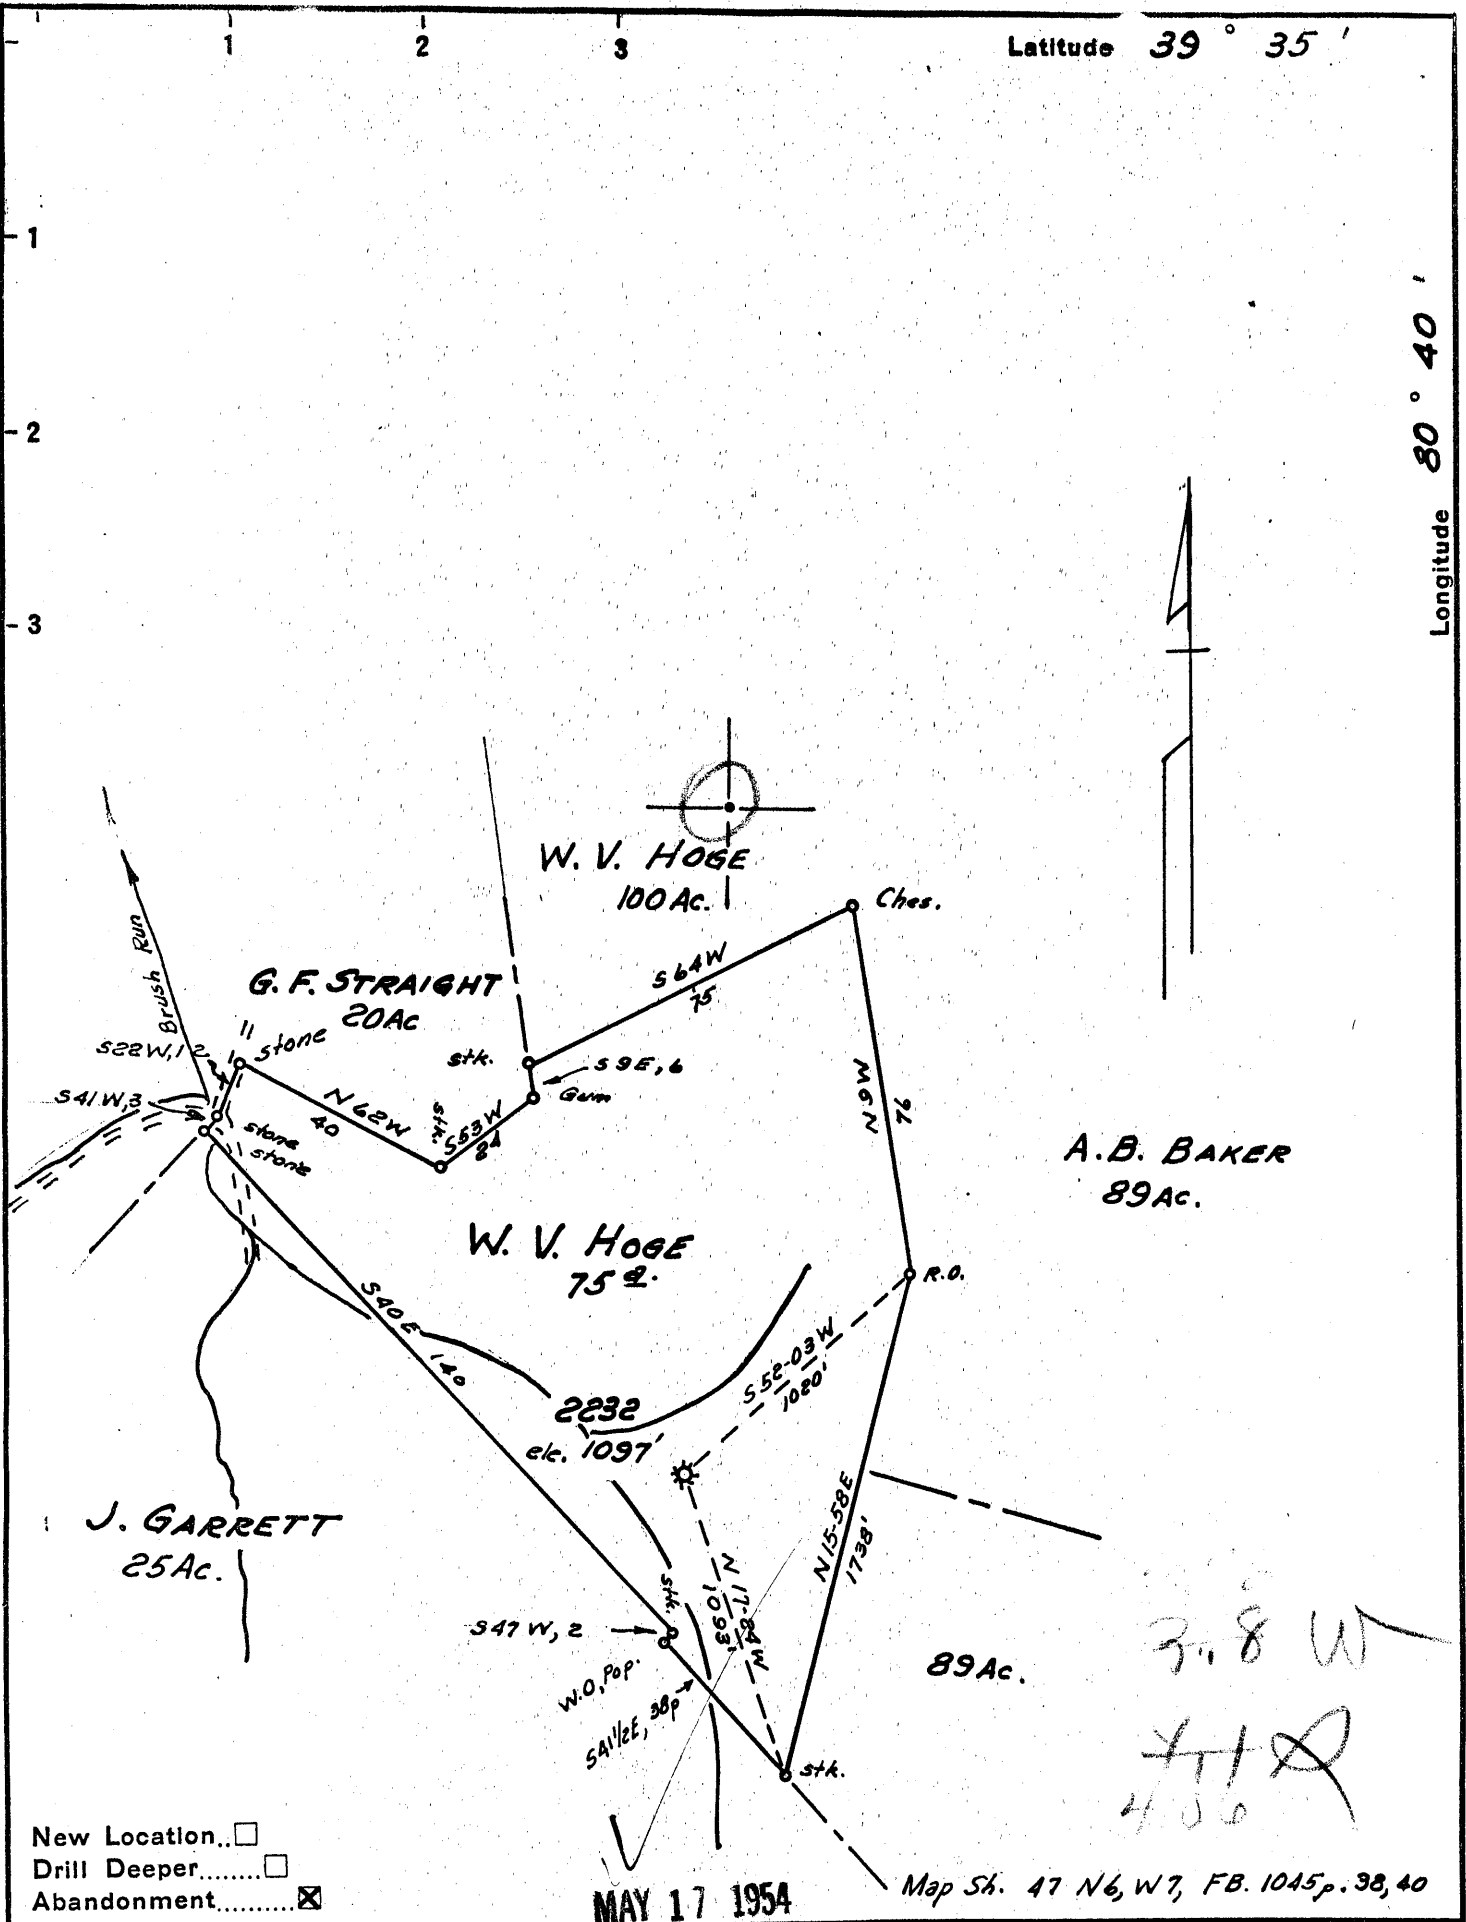

- New Location...
- Drill Deeper.....
- Abandonment.....

MAY 17 1954

Map Sh. 47 N6, W7, FB. 1045 p. 38, 40

Company HOPE NATURAL GAS CO.
 Address CLARKSBURG, W.VA.
 Farm W. V. HOGE
 Tract _____ Acres 75 Lease No. 23736
 Well (Farm) No. _____ Serial No. 2232
 Elevation (Spirit Level) 1097'
 Quadrangle LITTLETON
 County WETZEL District GREEN
 Engineer Guy H. Bradley
 Engineer's Registration No. 2425
 File No. _____ Drawing No. 1" = 4'
 Date 7 APRIL 1954 Scale 1" = 40p.

STATE OF WEST VIRGINIA
 DEPARTMENT OF MINES
 OIL AND GAS DIVISION
 CHARLESTON

WELL LOCATION MAP
 FILE NO. Wet-1004-A

+ Denotes location of well on United States Topographic Maps, scale 1 to 62,500, latitude and longitude lines being represented by border lines as shown.

- Denotes one inch spaces on border line of original tracing.

W.V. HOGE No. 2232 - HOPE N.G. Co. - WET-1004-A



STATE OF WEST VIRGINIA
DEPARTMENT OF MINES
OIL AND GAS DIVISION

1421

Collector
104-A

WELL RECORD

Oil or Gas Well **Gas**

(KIND)

Permit No. 104-A

Company Hope Natural Gas Company

Address 445 West Main St., Clarksburg, W.Va.

Farm W. V. Hoge Acres 75

Location (waters) _____

Well No. 2232 Elev. 1097'

District Green, County Wetzel

The surface of tract is owned in fee by _____
Address _____

Mineral rights are owned by _____
Address _____

Drilling commenced 6-16-11

Drilling completed 8-22-11

Date Shot Not shot From _____ To _____

With _____

Open Flow _____ /10ths Water in _____ Inch
_____ /10ths Merc. in _____ Inch

Volume _____ Cu. Ft.

Rock Pressure _____ lbs. _____ hrs.

Oil None _____ bbls., 1st 24 hrs.

Fresh water None _____ feet _____ feet

Salt water 1790' & 2145' feet _____ feet

Casing and Tubing	Used in Drilling	Left in Well	Packers
Size			Kind of Packer
16			
13			
10			Size of
8 1/4			
6 5/8	2016'	2016'	Depth set
5 3/16	2841'	2841'	
3			Perf. top
2	2954'	2954'	Perf. bottom
Liners Used			Perf. top
			Perf. bottom

CASING CEMENTED _____ SIZE _____ No. Ft. _____ Date _____


No Cementing

COAL WAS ENCOUNTERED AT 330 FEET ? INCHES

755 FEET 24 INCHES FEET INCHES

FEET INCHES FEET INCHES

Formation	Color	Hard or Soft	Top	Bottom	Oil, Gas or Water	Depth Found	Remarks
Native Coal			330	?			
Pittsburgh Coal			755	757			
Little Dunkard			1095	1135			
Big Dunkard			1263	1283			
Gas Sand			1502	1520			
1st Salt			1560	1570			
2nd Salt			1690	1830	Water	1790	
MAXON			1960	2000			
Little Lime			2000	2009			
Pencil Cave			2009	2012			
Big Lime			2012	2062			
Big Injun			2062	2280	Gas Water	2070 2145	
Berea			2415	2480			
Fifty Foot			2615	2625			
Gordon Stray			2840	2875	Gas	2847	
Fourth			2905	2909			
Total Depth				2933 1/2'			

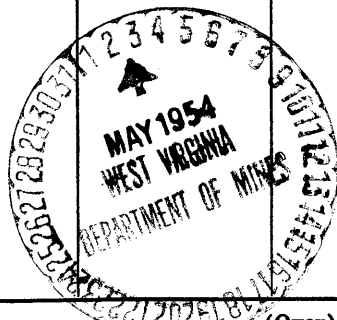

(Over)

NOV 12 1954

Formation	Color	Hard or Soft	Top	Bottom	Oil, Gas or Water	Depth Found	Remarks

Date April 15, 19 54

APPROVED Hope Natural Gas Company, Owner

By _____ (Title)