


Latitude 39° 40'

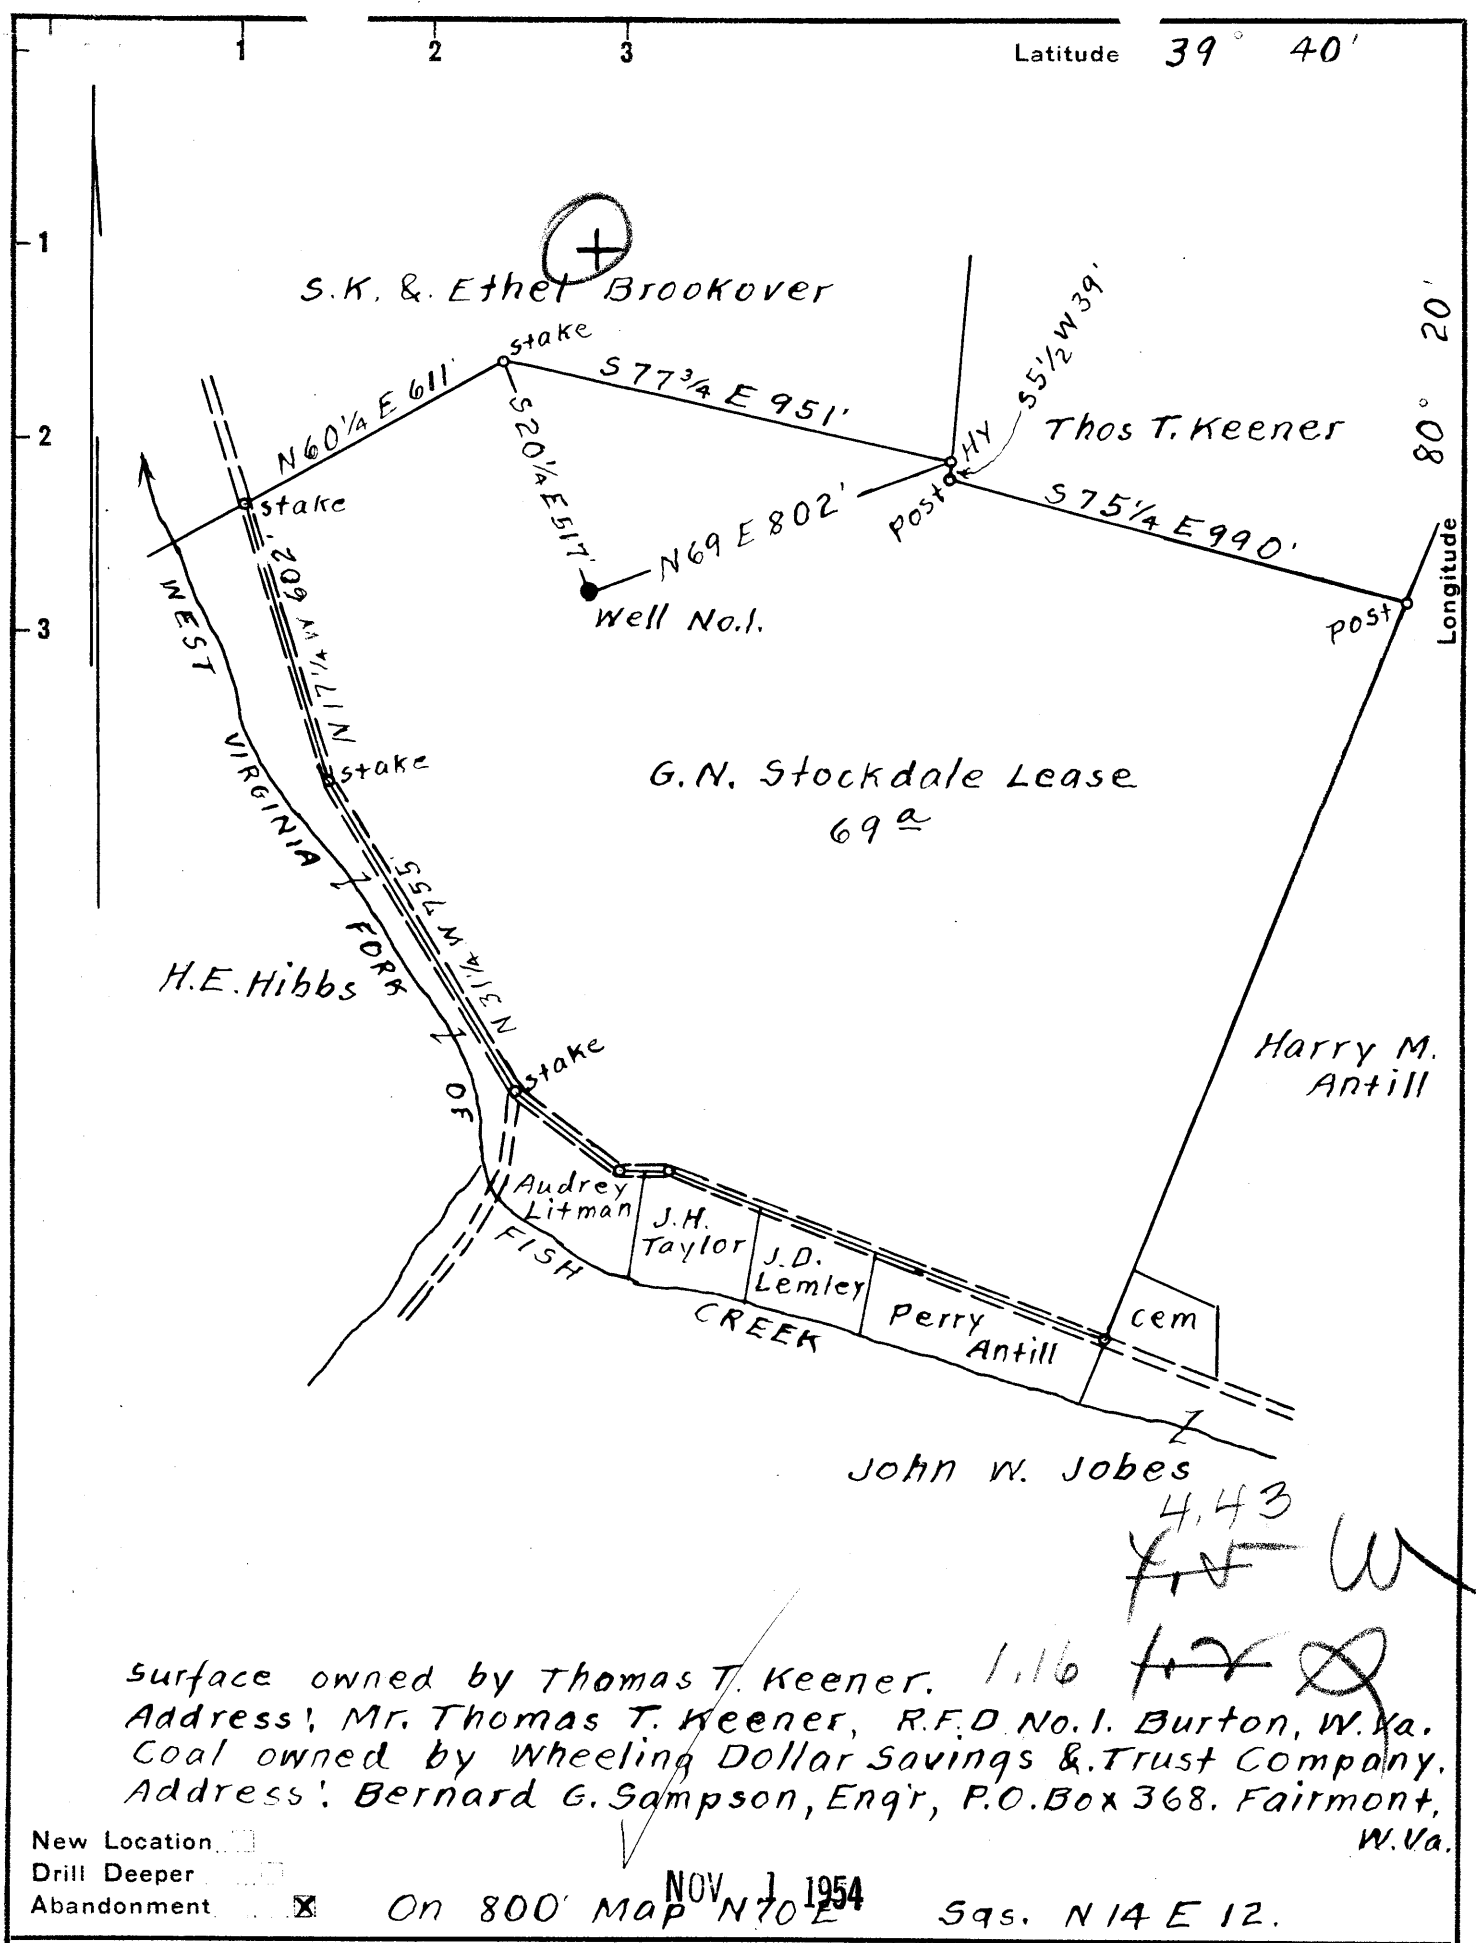

surface owned by Thomas T. Keener. 1.16 ~~for~~ ~~W~~
 Address: Mr. Thomas T. Keener, R.F.D. No. 1. Burton, W. Va.
 Coal owned by Wheeling Dollar Savings & Trust Company.
 Address: Bernard G. Sampson, Engr, P.O. Box 368. Fairmont, W. Va.

New Location
 Drill Deeper
 Abandonment On 800' MAP NOV 1 1954 Sqs. N14 E 12.

Company William Moses
 Address Salem, W. Va.
 Farm G.N. Stockdale
 Tract _____ Acres 69 Lease No. _____
 Well (Farm) No. 1 Serial No. 47
 Elevation (Spirit Level) Floor - 1349.75
Ground - 1348.09
 Quadrangle Mannington
 County Wetzel District Church
 Engineer Elsworth Haines
 Engineer's Registration No. 2221
 File No. _____ Drawing No. _____
 Date Sept. 30th, 1954 Scale 1" = 400 Feet

STATE OF WEST VIRGINIA
 DEPARTMENT OF MINES
 OIL AND GAS DIVISION
 CHARLESTON

WELL LOCATION MAP
 FILE NO. Wet-1007-A

+ Denotes location of well on United States Topographic Maps, scale 1 to 62,500, latitude and longitude lines being represented by border lines as shown.
 - Denotes one inch spaces on border line of original tracing.



STATE OF WEST VIRGINIA
DEPARTMENT OF MINES
OIL AND GAS DIVISION

1437

WELL RECORD

Permit No. 1007-A

Oil or Gas Well OIL
(KIND)


Company William Moses
Address Salem, W. Va.
Farm G. N. STOCKDALE Acres 69
Location (waters) _____
Well No. 1 Elev. 1348.09
District CHURCH County WETZEL
The surface of tract is in fee by WHEELING DOLLAR SAVINGS, BERNARD SAUNDERS ENGINEER
Mineral rights are owned by P. O. BOX 368 FAIRMONT Address W. V. A.
Drilling commenced 1/1/09
Drilling completed 3/12/09
Date Shot _____ From _____ To _____
With _____

Casing and Tubing	Used in Drilling	Left in Well	Packers
Size			Kind of Packer
16			
13			
10		<u>320</u>	Size of
8 1/2		<u>1597</u>	Depth set
6 1/2		<u>2113</u>	
5 3/16			
3			Perf. top
2		<u>2320</u>	Perf. bottom
Liners Used			Perf. top
			Perf. bottom

Open Flow _____ /10ths Water in _____ Inch
_____ /10ths Merc. in _____ Inch
Volume _____ Cu. Ft.
Rock Pressure _____ lbs. _____ hrs.
Oil _____ bbls., 1st 24 hrs.
Fresh water _____ feet _____ feet
Salt water _____ feet _____ feet

CASING CEMENTED _____ SIZE _____ No. Ft. _____ Date _____
COAL WAS ENCOUNTERED AT _____ FEET _____ INCHES
_____ FEET _____ INCHES _____ FEET _____ INCHES
_____ FEET _____ INCHES _____ FEET _____ INCHES

Formation	Color	Hard or Soft	Top	Bottom	Oil, Gas or Water	Depth Found	Remarks
			<u>1160</u>	<u>1169</u>			
			<u>1565</u>	<u>1615</u>			
			<u>1642</u>	<u>1700</u>			
			<u>1820</u>	<u>1880</u>			
			<u>1980</u>	<u>2050</u>			
			<u>2105</u>	<u>2165</u>			
			<u>2284</u>	<u>2319</u>			
			<u>2320</u>				

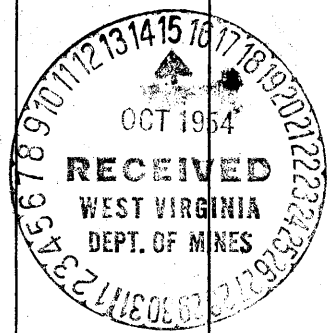

JAN 7 1955