

New Location...
 Drill Deeper.....
 Abandonment..... 5243

JUNE 25 1956

Sh. 39 N8 W4 FB 1005 P 35,36,39

Company HOPE NATURAL GAS CO.
 Address CLARKSBURG, W. VA.
 Farm PLEASY HAUGHT
 Tract _____ Acres 200 Lease No. 485
 Well (Farm) No. _____ Serial No. 23 & 5243
 Elevation (Spirit Level) 711 & 1068
 Quadrangle LITTLETON
 County WETZEL District GREEN
 Engineer W.M. Bowers
 Engineer's Registration No. 900
 File No. _____ Drawing No. _____
 Date May 28, 1956 Scale 1" = 40'

STATE OF WEST VIRGINIA
 DEPARTMENT OF MINES
 OIL AND GAS DIVISION
 CHARLESTON

WELL LOCATION MAP
 FILE NO. Wet-1025-A

+ Denotes location of well on United States Topographic Maps, scale 1 to 62,500, latitude and longitude lines being represented by border lines as shown.
 - Denotes one inch spaces on border line of original tracing.



1456

STATE OF WEST VIRGINIA
DEPARTMENT OF MINES
OIL AND GAS DIVISION

Quadrangle Littleton
Permit No. 1205A

WELL RECORD

Oil or Gas Well Gas
(KIND)

Company Hope Natural Gas Company
Address Clarksburg, W. Va.
Farm Pleasy Haught Acres 200
Location (waters) _____
Well No. 5243 Elev. 1068'
District Green County Wetzel
The surface of tract is owned in fee by _____
Address _____
Mineral rights are owned by _____
Address _____
Drilling commenced 3-11-19
Drilling completed 4-24-19
Date Shot Not shot From _____ To _____
With _____
Open Flow _____ /10ths Water in _____ Inch
_____ /10ths Merc. in _____ Inch
Volume Exhausted Cu. Ft.
Rock Pressure _____ lbs. _____ hrs.
Oil 1935' Show _____ bbls., 1st 24 hrs.
Fresh water 1680' feet _____ feet
Salt water _____ feet _____ feet


Casing and Tubing	Used in Drilling	Left in Well	Packers
Size			
16			Kind of Packer
13			
10			Size of
8 1/4	1400	1400	
6 3/4	2022	2022	Depth set
5 3/16	2659	2659	
3			Perf. top
2	2986	2986	Perf. bottom
Liners Used			Perf. top
			Perf. bottom

CASING CEMENTED _____ SIZE _____ No. Ft. _____ Date _____

Not Cemented

COAL WAS ENCOUNTERED AT 340 FEET 36 INCHES
804 FEET 60 INCHES FEET INCHES
FEET INCHES FEET INCHES

Formation	Color	Hard or Soft	Top	Bottom	Oil, Gas or Water	Depth Found	Remarks
Coal			340	343			
Pittsburgh Coal			804	809			
Little Dunkard			1205	1217			
Big Dunkard			1240	1252			
Gas Sand			1375	1403			
First Salt			1450	1480			
Second Salt			1630	1730	Water	1680	
Sand			1783	1865			
Maxon			1920	1950	Oil	1936'	
Little Lime			1950	1965			
Pencil Cave			1965	1980			
Big Lime			1980	2035			
Big Injun			2035	2057	Gas	2038	
Red Rock			2720	2748			
Gordon Gray			2840	2867			
Gordon			2869	2875			
Fourth			2888	2957	Gas	2890'	
Total Depth				2957'			

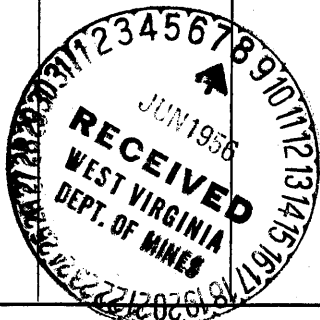

June 7, 1956
Jack Bailey
Hope Natural Gas Company

OCT 26 1956