

New Location...   
 Drill Deeper.....   
 Abandonment.....

Surface: Duane Lemley  
 Littleton, W.Va.

Coal: Hanna Coal Co.  
 St. Clairsville, O.

JULY 3 1956

N17 E5 Map N79

Company	South Penn Natural Gas Co.		
Address	Parkersburg, W.Va.		
Farm	S. Strosnider		
Tract	Acres	Lease No.	81429
Well (Farm) No.	1	Serial No.	
Elevation (Spirit Level)	1139.59 Ground		
Quadrangle	Littleton		
County	Wetzel	District	Clay
Engineer	Wm. S. Hayes		
Engineer's Registration No.	1429		
File No.	Drawing No.		
Date	MAY 28, 1956 Scale 1" = 400'		

STATE OF WEST VIRGINIA  
 DEPARTMENT OF MINES  
 OIL AND GAS DIVISION  
 CHARLESTON

WELL LOCATION MAP  
 FILE NO. WET-1026-A

+ Denotes location of well on United States Topographic Maps, scale 1 to 62,500, latitude and longitude lines being represented by border lines as shown.  
 - Denotes one inch spaces on border line of original tracing.



STATE OF WEST VIRGINIA  
DEPARTMENT OF MINES  
OIL AND GAS DIVISION

1462

WELL RECORD

Permit No. Ab 1076-2

Oil or Gas Well OIL  
(KIND)


Company SOUTH PENN NATURAL GAS COMPANY  
Address P. O. Box 1280, Parkersburg, W. Va.  
Farm S. Streamider Acres 90  
Location (waters) \_\_\_\_\_  
Well No. 1 Elev. 1139.59  
District Clay County Netzel  
The surface of tract is owned in fee by Dwain C. Lowley  
Littleton, W. Va. Address \_\_\_\_\_  
Mineral rights are owned by Dwain C. Lowley et al  
Littleton, W. Va. Address \_\_\_\_\_  
Drilling commenced June 29, 1916  
Drilling completed Sept. 7, 1916  
Date Shot 8-29 From \_\_\_\_\_ To \_\_\_\_\_  
With 30 lbs.

Casing and Tubing	Used in Drilling	Left in Well	Packers
Size			Kind of Packer
16			
13			
10	<u>155'</u>	<u>None</u>	Size of
8 1/4	<u>1436'</u>	<u>None</u>	
6 5/8	<u>2166'</u>	<u>2166'</u>	Depth set
5 3/16	<u>3023'-7"</u>	<u>3023'-7"</u>	
3			Perf. top
2			Perf. bottom
Liners Used			Perf. top
			Perf. bottom

Open Flow /10ths Water in \_\_\_\_\_ Inch  
/10ths Merc. in \_\_\_\_\_ Inch  
Volume \_\_\_\_\_ Cu. Ft.  
Rock Pressure \_\_\_\_\_ lbs. \_\_\_\_\_ hrs.  
Oil Estimated 10 bbls. bbls., 1st 24 hrs.  
~~Water~~ water 1760 feet  
Salt water \_\_\_\_\_ feet

CASING CEMENTED \_\_\_\_\_ SIZE \_\_\_\_\_ No. Ft. \_\_\_\_\_ Date \_\_\_\_\_  
COAL WAS ENCOUNTERED AT 950' FEET 8 1/2 INCHES  
\_\_\_\_\_ FEET \_\_\_\_\_ INCHES FEET \_\_\_\_\_ INCHES  
\_\_\_\_\_ FEET \_\_\_\_\_ INCHES FEET \_\_\_\_\_ INCHES

Formation	Color	Hard or Soft	Top	Bottom	Oil, Gas or Water	Depth Found	Remarks
<u>Pittsburgh Coal</u>			<u>950</u>	<u>957</u>			
<u>Bankard Sand</u>			<u>1280</u>	<u>1528</u>			
<u>Salt Sand</u>			<u>1710</u>	<u>1995</u>			
					<u>Water</u>	<u>1760</u>	
<u>Injun Sand</u>			<u>2177</u>	<u>2423</u>			
					<u>Gas</u>	<u>2275</u>	
<u>Garden</u>			<u>3005</u>				
					<u>Oil</u>	<u>?</u>	
<b>TOTAL DEPTH</b>				<u>3095</u>			

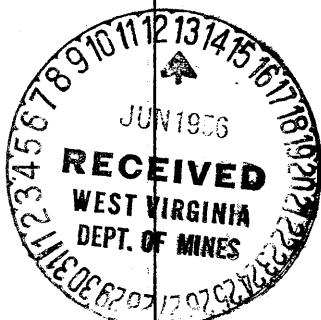

OCT 26 1956

