


Latitude 39 35
Longitude 80 40

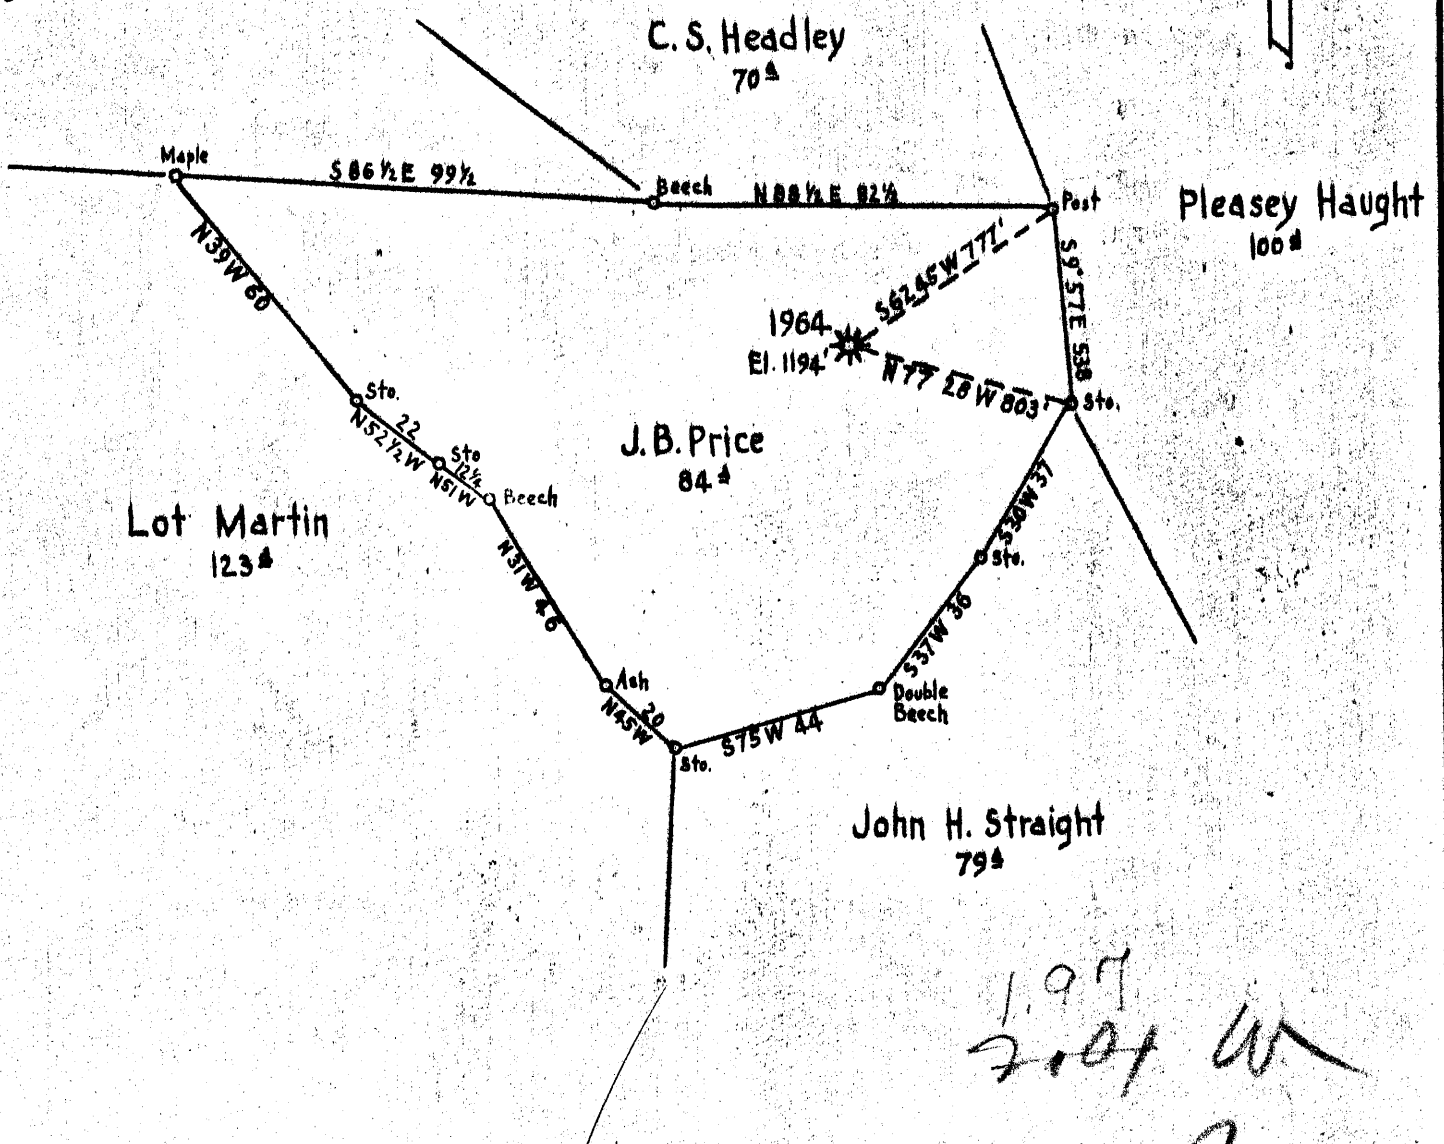

New Location...
 Drill Deeper.....
 Abandonment.....

AUG 6 1956

FB 1005 P 37 Sh. 39 N 8 W 5

*1.97
2.01 W
7.0
1.96*

Company HOPE NATURAL GAS CO.
 Address CLARKSBURG, W. VA.
 Farm J.B. Price
 Tract Acres 84 Lease No. 5341
 Well (Farm) No. Serial No. 1964
 Elevation (Spirit Level) 1194'
 Quadrangle LITTLETON
 County WETZEL District GREEN
 Engineer W.M. Bowers
 Engineer's Registration No. 900
 File No. Drawing No.
 Date JULY 13, 1956 Scale 1"=40'

STATE OF WEST VIRGINIA
 DEPARTMENT OF MINES
 OIL AND GAS DIVISION
 CHARLESTON

WELL LOCATION MAP
 FILE NO. Wet-1029-A

+ Denotes location of well on United States Topographic Maps, scale 1 to 62,500, latitude and longitude lines being represented by border lines as shown.
 - Denotes one inch spaces on border line of original tracing.



1460

Littleton

STATE OF WEST VIRGINIA
DEPARTMENT OF MINES
OIL AND GAS DIVISION

Gas

Quadrangle Hope Natural Gas Company
Permit No. 445 West Main Street

WELL RECORD


Oil or Gas Well _____ (KIND)

Company J. B. Price 84
 Address 1964
 Farm Green Acres 1194
 Location (waters) Wetzel
 Well No. _____ Elev. _____
 District _____ County _____
 The surface of tract is owned in fee by _____
 _____ Address 11-8-10
 Mineral rights are owned by _____
 _____ Address 1-5-11
Not shot
 Drilling commenced _____
 Drilling completed _____
 Date Shot _____ From _____ To _____
 With _____
 Open Flow None /10ths Water in _____ Inch
 _____ /10ths Merc. in _____ Inch
 Volume No water found Cu. Ft.
 Rock Pressure _____ lbs. _____ hrs.
 Oil _____ bbls., 1st 24 hrs.
 Fresh water _____ feet _____ feet
 Salt water _____ feet _____ feet

Casing and Tubing	Used in Drilling	Left in Well	Packers
Size			
16			Kind of Packer
13	2169	2169	
10	2993	2993	Size of
8 1/4			
6 1/2	3079	3079	Depth set
5 3/16			
3			Perf. top
2			Perf. bottom
Liners Used			Perf. top
			Perf. bottom

No Cementing
 CASING CEMENTED SIZE 667 No. Ft. 48 Date _____
912 72
 COAL WAS ENCOUNTERED AT _____ FEET _____ INCHES
 _____ FEET _____ INCHES FEET _____ INCHES
 _____ FEET _____ INCHES FEET _____ INCHES

Coal Formation	Color	Hard or Soft	<u>667</u> Top	<u>677</u> Bottom	Oil, Gas or Water	Depth Found	Remarks
Coal			912	918			
Little Dunkard			1305	1365			
Big Dunkard			1455	1470			
First Salt			1755	1790			
Second Salt			1920	1970			
Little Lime			2075	2081			
Big Lime			2087	2165			
Big Injun			2165	2400	Gas	2175	
Fifty Foot			2775	2825			
Thirty Foot			2925	2933			
Gordon Stray			2967	3008	Gas	2967-72	
Gordon			None				
Fourth Sand			3030	3034			
Total Depth				3057'			

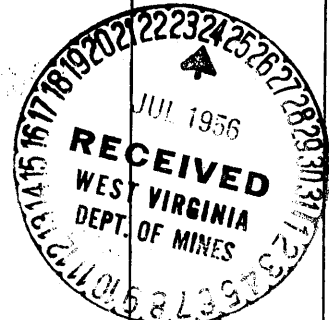

July 18, 1956
Jack Bailey
 Hope Natural Gas Company