

New Location...
 Drill Deeper.....
 Abandonment.....

AUG 27 1957

Company Dunn-Mar Oil & Gas Co
 Address Waynesburg Pa.
 Farm Alice Edsel
 Tract 1 Acres 150 Lease No. _____
 Well (Farm) No. 2-4-6-7-10 Serial No. _____
 Elevation (Spirit Level) 2=1481 6=1439 10=1417
4=1410 7=1347
 Quadrangle Mannington
 County Wetzel District Church
 Engineer A. L. Headley
 Engineer's Registration No. 2021
 File No. _____ Drawing No. _____
 Date 10-23-56 Scale 1" = 600'

STATE OF WEST VIRGINIA
 DEPARTMENT OF MINES
 OIL AND GAS DIVISION
 CHARLESTON

WELL LOCATION MAP

FILE NO. Wet-1050-A-#6
Wet-1051-A-#2

+ Denotes location of well on United States Topographic Maps, scale 1 to 62,500, latitude and longitude lines being represented by border lines as shown.

- Denotes one inch spaces on border line of original tracing.

ALICE EDGELL Nos 6 & 2 - DUNN-MAR O & G Co - WET-1050-51A



STATE OF WEST VIRGINIA
DEPARTMENT OF MINES
OIL AND GAS DIVISION

1474

WELL RECORD

Permit No. 1051A

[Signature]

Oil or Gas Well Oil
(KIND)


Company Dunn-Mar Oil and Gas Company
Address Waynesburg, Pennsylvania
Farm E. A. Edgall Acres 200
Location (waters) Wheeling Creek
Well No. 2 Elev. 1481'
District Church County Wetzel
The surface of tract is owned in fee by E. A. Edgall Heirs
Address _____
Mineral rights are owned by _____
Address _____

Drilling commenced December 20, 1917
Drilling completed February 18, 1918
Date Shot 4-27-23 From 2444' To 2450'
With 20 quarts nitro-glycerine
Open Flow _____ /10ths Water in _____ Inch
_____ /10ths Merc. in _____ Inch
Volume _____ Cu. Ft.
Rock Pressure _____ lbs. _____ hrs.
Oil _____ bbls., 1st 24 hrs.
Fresh water _____ feet _____ feet
Salt water _____ feet _____ feet

Casing and Tubing	Used in Drilling	Left in Well	Packers
Size			Kind of Packer
16			
13			
10	155	155	Size of
8 1/4			
6 3/8	2155	2155	Depth set
5 3/16	2161	2161	
3			Perf. top
2	2450	2450	Perf. bottom
Liners Used			Perf. top
			Perf. bottom

CASING CEMENTED _____ SIZE _____ No. Ft. _____ Date _____
COAL WAS ENCOUNTERED AT 1280 FEET 0 INCHES
_____ FEET _____ INCHES _____ FEET _____ INCHES
_____ FEET _____ INCHES _____ FEET _____ INCHES

Formation	Color	Hard or Soft	Top	Bottom	Oil, Gas or Water	Depth Found	Remarks
Fgh. Coal	Black	Soft	1280	1286			
Little Dunkard	Grey	Hard	1676	1696			
Big Dunkard	Grey	Hard	1760	1800			
Salt Sand	White	Hard	2020	2240			
Marion Sand	Grey	Hard	2384			Oil	2415
					Oil	2443	
			Total Depth		2450		

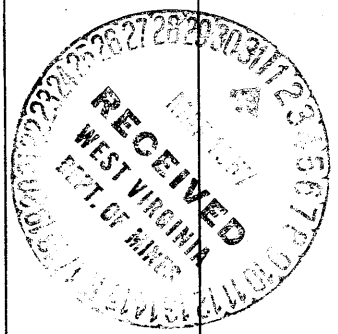

JUN 20 1957