

Company South Penn Natural Gas Co.
 Address Parkersburg, W.Va.
 Farm Helen M. Jamison
 Tract _____ Acres 202 Lease No. 15545
 Well (Farm) No. 3 & 6 Serial No. _____
 Elevation (Spirit Level) (3) 1270.60 ch. (6) 1184.51 ch.
 Quadrangle Centerpoint
 County Wetzel District Green
 Engineer Al Hilbert
 Engineer's Registration No. 2534
 File No. 1269 Drawing No. _____
 Date May 19, 1959 Scale 1" = 40 Poles or 660'


STATE OF WEST VIRGINIA
 DEPARTMENT OF MINES
 OIL AND GAS DIVISION
 CHARLESTON

WELL LOCATION MAP
 FILE NO. Wet-1094-A-#3
Wet-1095-A-#6

+ Denotes location of well on United States Topographic Maps, scale 1 to 62,500, latitude and longitude lines being represented by border lines as shown.

- Denotes one inch spaces on border line of original tracing.

HELEN M. JAMISON Nos. 3 & 6 - SOUTH PENN N.G. Co. - WET-1094-9.

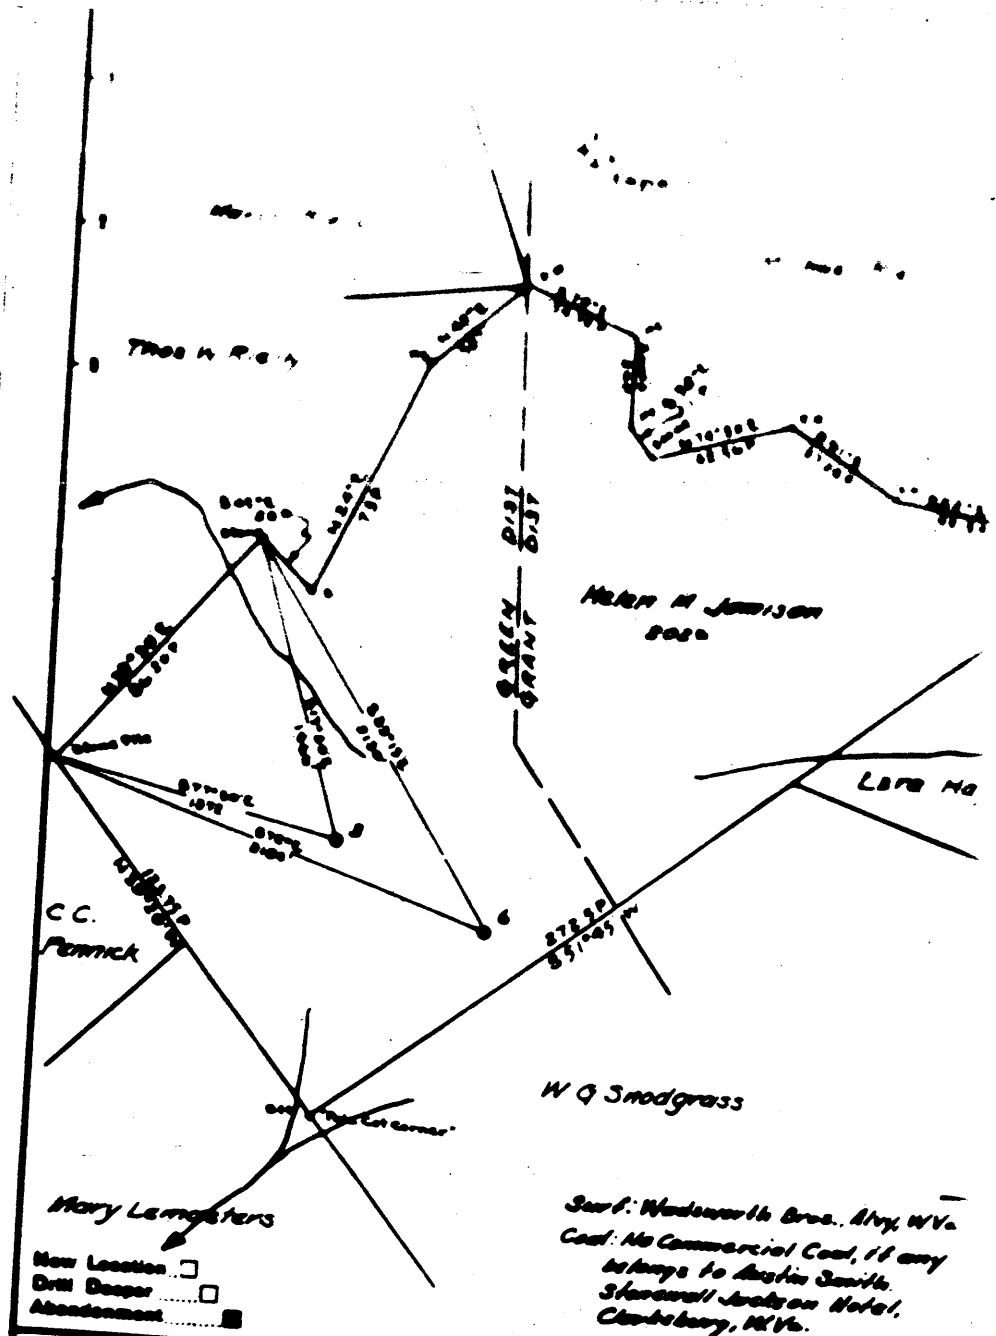

New Location
 Drill Deeper
 Abandonment

Company South Penn Natural Gas Co.
 Address Parkersburg, W. Va.
 Farm Helen M. Jamison
 Tract _____ Acres 2.02 Lease No. 15545
 Well (Farm) No. 346 Serial No. _____
 Elevation (Spill Level) (4170.60) (4170.60)

Surf: Meadows Fork Bros., Mt. Vernon, W.Va.
 Coal: No Commercial Coal, if any
 belongs to Austin Smith,
 Starwood Jackson Hotel,
 Clarksburg, W.Va.

Map N 18 N 3 N 2-3

STATE OF WEST VIRGINIA
 DEPARTMENT OF MINES
 OIL AND GAS DIVISION
 CHARLESTON
WELL LOCATION MA
 FILE NO. 1024-R-1
 W.V. 1000