
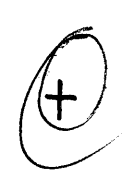


0 1 2 3 LATITUDE 39 ° 45'

1 2 3 LONGITUDE 80 ° 45'

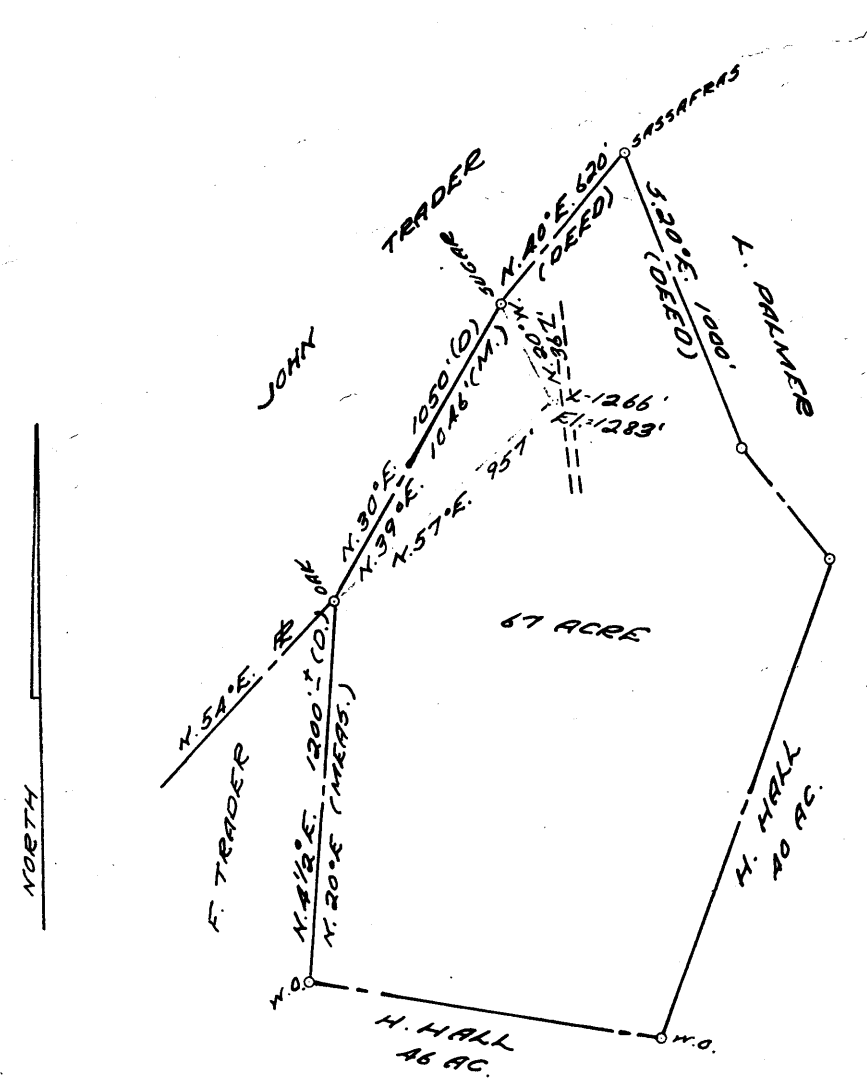

COAL OWNED BY _____
 NEW LOCATION
 DRILL DEEPER
 ABANDONMENT

FEB 18 1963

1.50
~~7.55 W~~
~~7.14~~
 4.35
 P. 24-15

COMPANY THE MANUFACTURERS LIGHT & HEAT
 ADDRESS 800 UNION TRUST BLDG., PSH. PA.
 FARM M. LEMON
 TRACT _____ ACRES 67 LEASE No. 3040
 WELL (FARM) No. 1 SERIAL No. 1266
 ELEVATION (SPIRIT LEVEL) 1283'
 QUADRANGLE NEW MARTINSVILLE
 COUNTY WETZEL DISTRICT PROCTOR
 ENGINEER Robert M. Neill
 ENGINEER'S REGISTRATION No. 361-E (D. Clark)
 FILE No. _____ DRAWING No. Y-25-668
 DATE 21 DEC. 62 SCALE 1" = 800'

STATE OF WEST VIRGINIA
 DEPARTMENT OF MINES
 OIL AND GAS DIVISION
 CHARLESTON
WELL LOCATION MAP
 FILE No. WET-1156-A

+ DENOTES LOCATION OF WELL ON UNITED STATES TOPOGRAPHIC MAPS, SCALE 1 TO 62,500. LATITUDE AND LONGITUDE LINES BEING REPRESENTED BY BORDER LINES AS SHOWN.
 - DENOTES ONE INCH SPACES ON BORDER LINE OF ORIGINAL TRACING.

NO. 156 IMPERIAL A. & B. SMITH CO., PGH., PA. PR 5831-1161
 M. L. Emons No. 1 (1266) — M. L. E. H. Co. — WET-1156-A