


39° 45'

Latitude

80° 45'

Longitude

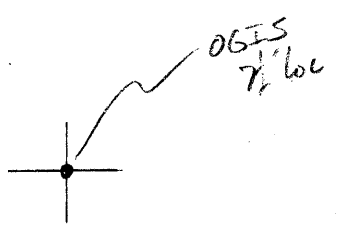

Topo Location

7.5' Loc. 1.95 S 15' Loc. _____
0.80 W (calc.) _____

Company Hope Natural Gas
 Farm J.M. Parsons #369
 15' Quad _____
 (sec.) _____
 7.5' Quad New Martinsville
 District Franklin
 plots in Marshall Co.
 Franklin Dist.

WELL LOCATION PLAT

County 103 Permit ~~7017~~
 70225
 also? 051 70121?

JASON M. PARSONS NO. 1 WELL.

70225
No. 20 on Map.

Proctor District, Wetzel County, W. Va.

ML&H Co. No. 1260 (Tri-State Gas Co. well) (Hope 369).

Elevation, 1368' L.

Completed, Sept. 20, 1902.

Gordon gas well.

Casing: 10", 1098'; 8", 1712'; 6-5/8", 2162'.

Plugged and abandoned 4-12-10.

	Top.	Bottom.
Pittsburgh Coal (not present)	960	
Dunkard Sand	1240	1300
Salt Sand	1610	
Big Linn	1943	2013
Big Injun	2013	2265
Red rock	2700	
Gordon (gas) Sand	2876	2890±
Total depth		2890