


39° 37' 30"

Latitude

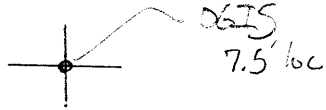

80° 45'

Longitude

Topo Location

7.5' Loc.	<u>0.23 S</u>	15' Loc.	<u>3.11 S</u>
	<u>1.52 W</u>	(calc.)	<u>1.52 W</u>

Company Silverhill Oil Co.

Farm L. F. Burley et al #3

15' Quad New Martinsville
(sec.)

7.5' Quad Porters Falls

District Magnolia

WELL LOCATION PLAT

County 103 Permit 73494

103-73494

L.F. Burley et al No. 3 Well (316-3)(382G)

Magnolia District, Wetzel County, W. Va.; on Derrick Run of Little Fishing Creek 1.4 miles north of Childs; completed February 26, 1927; authority, Silverhill Oil Company; elevation, 781' L.

	Top. Feet.	Bottom. Feet.
Water	55	40
Coal, <u>Waynesburg</u>	338	300
Coal, <u>Uniontown</u>	334	336
Coal, <u>Franktown, Sewickley</u>	504	506
Coal, <u>Pittsburgh (S.L.)</u>	593	595
Sand, <u>Minshall, Connellsville, hard</u>	607	650
Sand, <u>Drafton</u>	848	875
Sand, <u>Moundsville, Saltsburg, hard</u>	895	970
Sand, <u>Big Dunkard, Mahoning, gritty lime</u> (steel line)	1112	1136
Sand, <u>Big Dunkard, Mahoning (continued)</u> hard	1139	1190
Sand, <u>Burning Springs, Upper Freeport, hard</u>	1195	1212
Coal, <u>Lower Freeport</u>	1215	1218
Gas Sand, <u>Lower Freeport</u>	1274	1300
Sand, <u>Second Cow Run, Homewood, hard</u>	1358	1515
Sand, <u>Salt, Upper Connocquenessing, hard</u> (water, 1502-1505; 1 barrel per hour) ...	1506	1620
Sand, <u>Naxton, Brown</u>	1658	1677
<u>Little Linc, hard</u>	1688	1696
<u>Pencil Cave, soft</u>	1696	1699
<u>Big Linc, hard (steel line)</u>	1699	1743
Sand, <u>Big Injun</u>	1743	1990
Soft break	1752 - 1756'	
Gritty lime, close	1756 - 1762	
Hard sand	1762 - 1815	
Dark slate, break	1815 - 1819	
Oil show	1858 - 1860	
Sand, <u>Squaw, close</u>	2135	2212
Lime, hard, sandy	2230	2287
Sand, <u>Berea</u>	2340	2347
Sand, <u>Fifty-foot, hard</u>	2418	2422
Red rock	2430	2466
Sand, <u>Thirty-foot</u>	2536	2564
Reduced hole to 5 3/16"	2539' (S.L.)	
Nice show of gas	2543-2544'	
Show of oil and increased gas	2544-2548'	
Slate, black	2564	2583
Sand, <u>Gordon Stray</u>	2585	2600
No Gordon Sand		
Sand, <u>Fourth, shelly, hard</u>	2638	2653
Total depth		2671

Conductor, 15'; 10" csg., 214'; 8 1/2" csg., 1117' (S.L.);
 6 5/8" csg., 1712' (S.L.).

Bailed well at 9:30 A.M. February 28, after standing 2 days; had nice show of yellow oil; bailed out 2 bbl. - 30' sand oil.

Shot March 1, with 25 quarts in Thirty-foot Sand;

Little increase of oil or gas; well plugged and abandoned.