


Latitude 39° 05'

Longitude 81° 30'

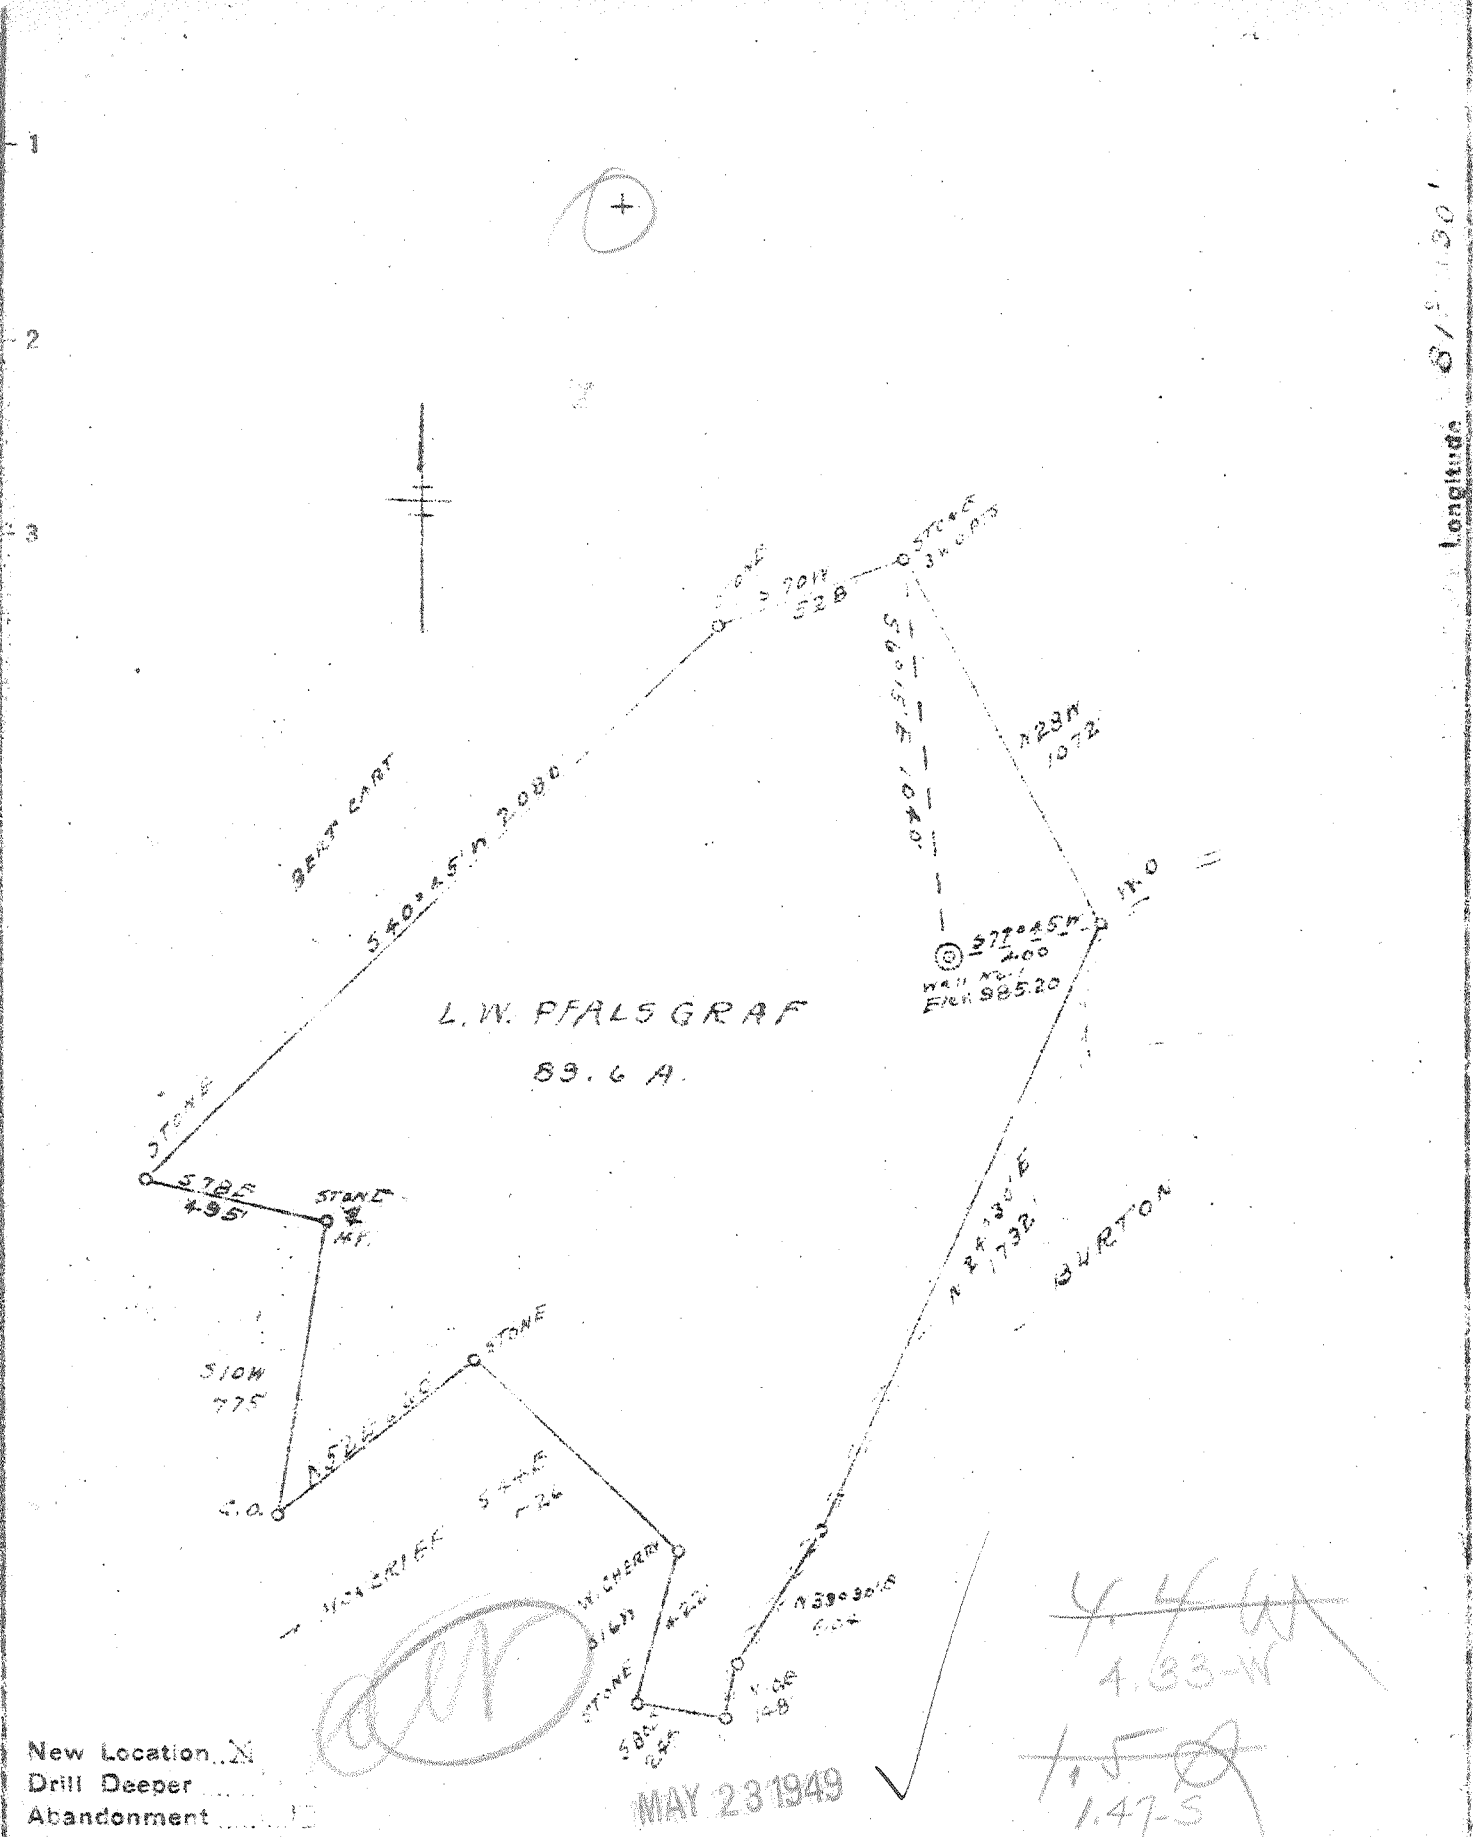

New Location
 Drill Deeper
 Abandonment

MAY 23 1949

~~4.46~~
~~4.33-W~~
~~1.5~~
~~1.47-S~~

Company LIMESTONE GAS CO.
 Address RIPLBY, W. VA.
 Farm L.W. PFALSGRAF
 Tract _____ Acres 89.6 Lease No. _____
 Well (Farm) No. 1 Serial No. _____
 Elevation (Spirit Level) 985.20
 Quadrangle BELLEVILLE
 County WOOD District STEELE
 Engineer P. F. [Signature]
 Engineer's Registration No. 804
 File No. _____ Drawing No. _____
 Date 4-25-49 Scale 1" = 500'

STATE OF WEST VIRGINIA
 DEPARTMENT OF MINES
 OIL AND GAS DIVISION
 CHARLESTON

WELL LOCATION MAP
 FILE NO. W00-283

+ Denotes location of well on United States Topographic Maps, scale 1 to 62,500, latitude and longitude lines being represented by border lines as shown.
 - Denotes one inch spaces on border line of original tracing.

L.W. PFALSGRAF No. 1 LIMESTONE GAS CO. - W00-283

1.5 S. 39° 05'
 4.4 W. 81° 30'
 7 NW (G-5)

WEST VIRGINIA DEPARTMENT OF MINES
 OIL & GAS DIVISION
 WELL RECORD

Permit No. Woo 288				Gas Well
Belleville Quad. - SE				CASING & TUBING
Company	Limestone Gas Co.			
Address	Ripley, W.Va.	16	16	16
Farm	L.W. Pfalzgraf A 90	10	800	
Location	Pond Creek	8 1/2	1200	
Well No.	One (1) Elev. 985.20'	7	2125	
District	Steele Wood County	5 3/16	4960	4960
Surface	L.W. Pfalzgraf, Rockport, W.Va.	2	5050	5050
Mineral	Limestone Gas Co., Ripley, W.Va.			
Commenced	May 19, 1949			
Completed	Aug. 31, 1949			
Date shot	Sept. 1 Depth 5044 to 5070 with 50 qts. glycerine			
Open flow	23/10ths M in 2"			
Volume	746,000 G.F.			
Rock Pressure	1600 lbs. 24 hrs.			
Fresh Water	835' 5 blrs. per hr.			
Salt Water	1465'			

Surface		0	10
Red Rock	S	10	50
Sand Shell Wh	H	50	65
Red Rock	S	65	125
Lime Shell Wh	H	125	175
Red Rock	S	175	250
Lime Shell Wh	H	250	300
Red Rock	S	300	400
Lime Shell Wh	H	400	425
Red Rock	S	425	480
White Slate Wh	S	480	500
Lime Shell Wh	H	500	530
Red Rock	S	530	570
Lime Shell Wh	H	570	615
Sand Wh	H	615	665
Red Rock	S	665	690
Gray Shell Gr	H	690	805
Sand Wh	H	805	850
Slate Wh	S	850	905
Sand Wh	H	905	945
Slate Wh	S	945	965
Red Rock	S	965	1000
Lime Shell Wh	H	1000	1020
Red Rock	S	1020	1060
Shell Wh	H	1060	1100
Slate Wh	S	1100	1150
Red Rock	S	1150	1195
White Slate Wh	S	1195	1310
Sand Wh	H	1310	1335
Slate Wh	S	1335	1465
Sand Wh	H	1465	1520
Slate Wh	S	1520	1690
Salt Sand Wh	H	1690	1750
Big Lime Wh	H	1750	1808
Sand Wh	H	1808	1820
Slate & Shells Wh	H&S	1820	1863
Sand Wh	H	1863	1965
Slate & Shells Wh	H&S	1965	2010
Sand Wh	H	2010	2025
Slate & Shells Wh	H&S	2025	3935
Brown Shale	Br S	3935	4230
White Slate Wh	S	4230	4685
Brown Shale	S	4685	4933
Cor. Lime Wh	H	4933	5044
Oriskany Sand Wh	H	5044	5070
Lime Wh	H	5070	5072
T.D.			5072
Gas 5047			

ADD
 5/15/2

485

Deep Well