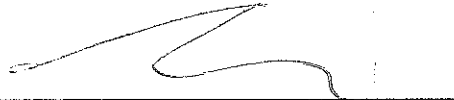


(+) DENOTES LOCATION OF WELL ON UNITED STATES TOPOGRAPHIC MAPS

WELL REFERENCES:
N01-14E, 325.60' TO NAIL IN 8" APPLE
N31-53W, 418.82' TO NAIL IN 36" SUGAR

FILE NUMBER: _____
DRAWING NUMBER: CGCPHL28DHSR.PCS
SCALE: 1" = 1000'
MINIMUM DEGREE OF ACCURACY: _____ CENTIMETER
PROVEN SOURCE OF ELEVATION: DGPS SURVEY
RTK CENTIMETER SYSTEM

I, THE UNDERSIGNED, HEREBY STATE THAT THIS PLAT IS CORRECT TO THE BEST OF MY KNOWLEDGE AND BELIEF AND SHOWS ALL THE INFORMATION REQUIRED BY LAW AND THE REGULATIONS ISSUED AND PRESCRIBED BY THE DEPARTMENT OF ENERGY.

(SIGNED) 
STEPHEN D. LOSH, P.S. #674

PROFESSIONAL LAND SURVEYOR
STEPHEN D. LOSH
NO. 674
STATE OF WEST VIRGINIA
PLACE SEAL HERE

STATE OF WEST VIRGINIA
DIVISION OF ENVIRONMENTAL PROTECTION
OFFICE OF OIL AND GAS
#10 McJUNKIN ROAD
NIRO, WV 25143-2506

LAND SURVEYING SERVICES
21 CEDAR LANE, BRIDGEPORT, WV 26330
PHONE: 304-842-2018 OR 842-5762

DATE: AUGUST 03, 2011
OPERATORS WELL NO.: PHL28DHS

WELL TYPE: OIL GAS LIQUID INJECTION WASTE DISPOSAL CBM
(IF "GAS") PRODUCTION STORAGE DEEP SHALLOW

API WELL NO. 47-001-03262H
STATE WV COUNTY BARBOUR PERMIT PHL28DHS

LOCATION: ELEVATION 1423' (GROUND) 1412' (AS BUILT) WATERSHED TAYLOR DRAIN
DISTRICT PLEASANT COUNTY BARBOUR

QUADRANGLE PHILIPPI LEASE NUMBER SEE ABOVE

SURFACE OWNER ROBERT L. MCBEE ACREAGE 71.41 (19-8.1)

OIL & GAS ROYALTY OWNER J. MCBEE, ET. AL. LEASE ACREAGE 1,011.98

PROPOSED WORK: DRILL CONVERT DRILL DEEPER REDRILL FRACTURE OR STIMULATE PLUG OFF OLD FORMATION
PERFORATE NEW FORMATION OTHER PHYSICAL CHANGE (SPECIFY) _____

PLUG & ABANDON CLEAN OUT & REPLUG


TARGET FORMATION MARCELLUS ESTIMATED DEPTH TVD = 7,650' TMD = 14,400'

WELL OPERATOR CNX GAS COMPANY LLC DESIGNATED AGENT KENT WRIGHT

ADDRESS P. O. BOX 1248 JANE LEW, WV 26378 ADDRESS P. O. BOX 1248 JANE LEW, WV 26378

COUNTY NAME PERMIT

02/17/2012

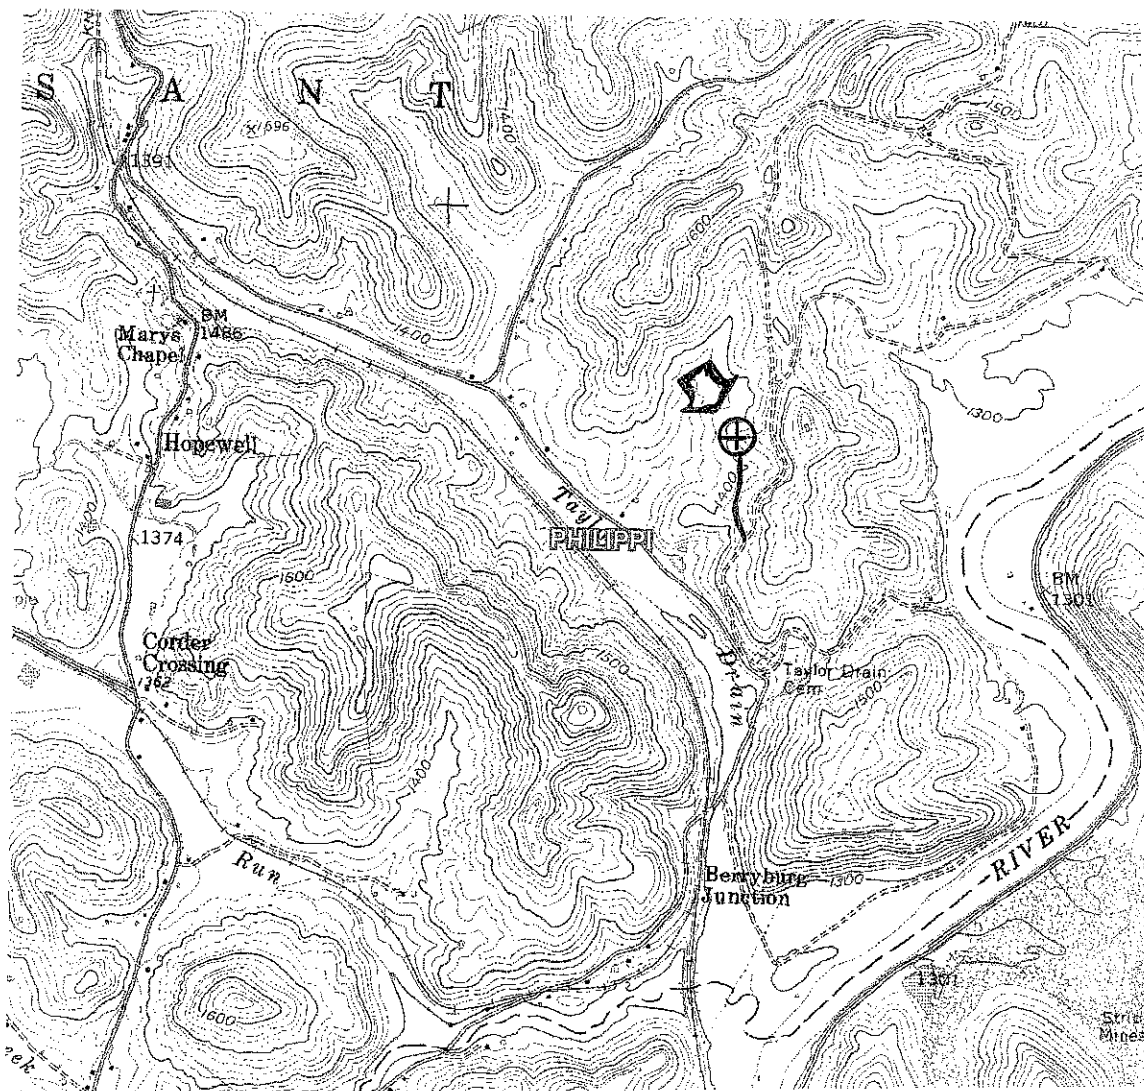

DRAWINGS TO ACCOMPANY FORM WW-9

CNX GAS COMPANY LLC

P. O. BOX 1248

JANE LEW, WV 26378

WATERSHED: TAYLOR DRAIN

DISTRICT: PLEASANT COUNTY: BARBOUR

QUADRANGLE: PHILIPPI WELL NO.: PHL28DHS

DATE: 08/02/11 PAGE of

LAND SURVEYING SERVICES
 21 CEDAR LANE
 BRIDGEPORT, WV 26330
 PHONE: 304-842-2018 OR 5762