


LATITUDE 40° 22' 30"

00° 35' 00" LONGITUDE

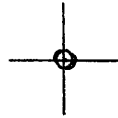

7'5 OGIS topo location

7.5' loc 2.263  
0.62 W

15' loc \_\_\_\_\_  
(calc.) \_\_\_\_\_

Company \_\_\_\_\_

Farm \_\_\_\_\_


Quad STEBENVILLE E 7 1/2'

County BROOKS

District CROSS CREEK

WELL LOCATION MAP

File No. 009 - 0007

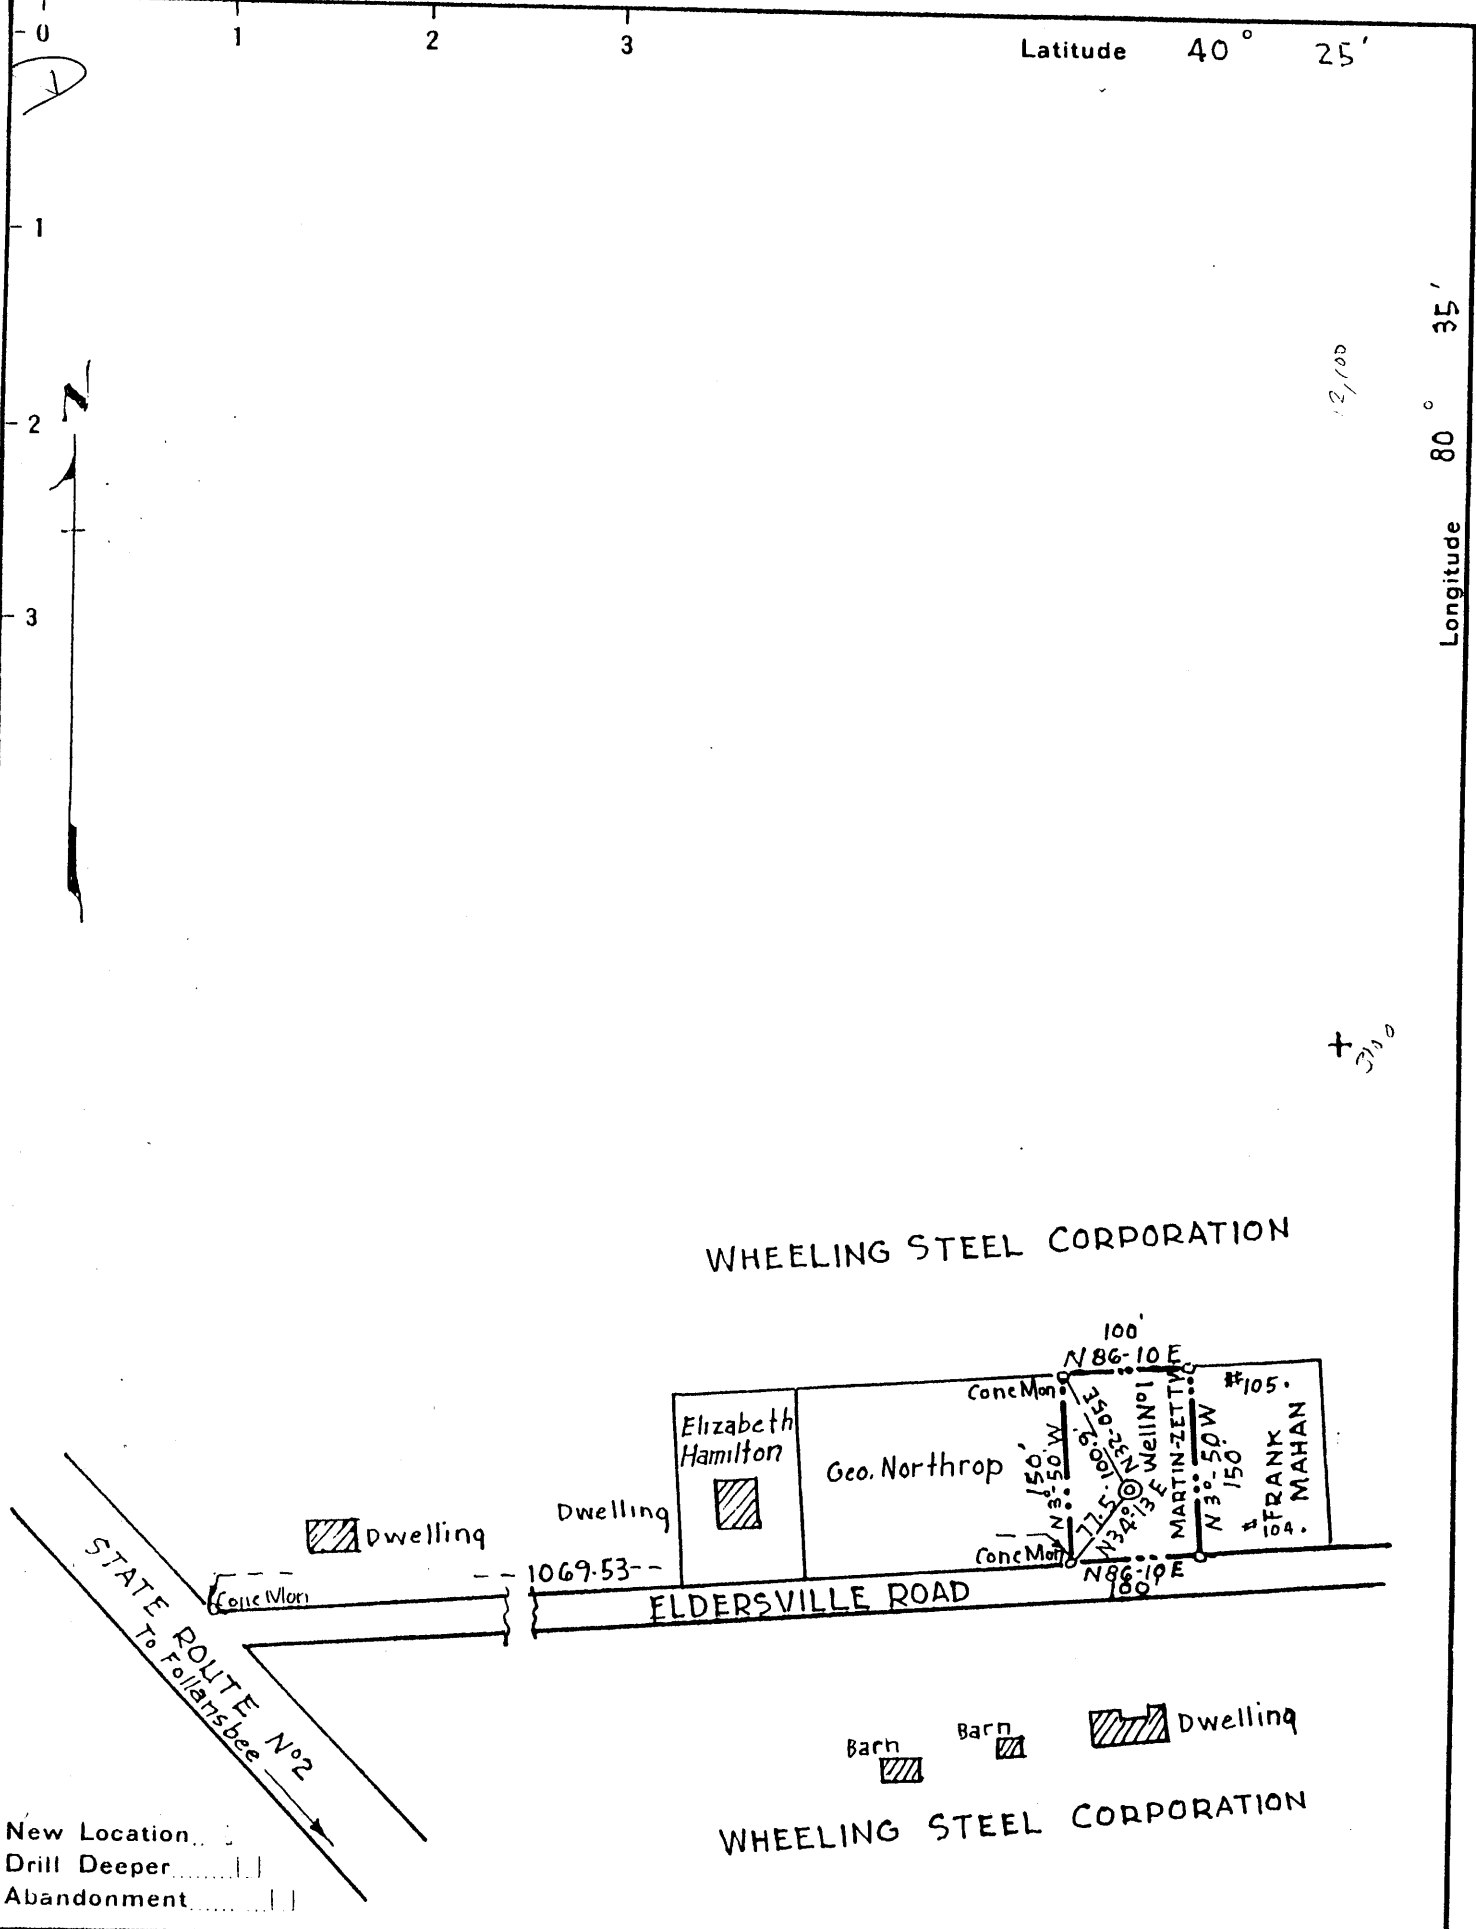

New Location...  
 Drill Deeper...  
 Abandonment...

J. W. HUGGUS

Company WHEELING STEEL CORP.

Address WHEELING, W. VA.

Farm Cecil Zetty

Tract Acres 0.34 Lease No. \_\_\_\_\_

Well (Farm) No. MARTIN-ZETTY Serial No. \_\_\_\_\_

Elevation (Spirit Level) 740.0

Quadrangle Steubenville

County Brooke District Cross Creek

Engineer Eugene M. Smith - G.C. Smith's Sons

Engineer's Registration No. 290

File No. \_\_\_\_\_ Drawing No. \_\_\_\_\_

Date Jan 9, 1942 Scale 1" = 150'

STATE OF WEST VIRGINIA  
 DEPARTMENT OF MINES  
 OIL AND GAS DIVISION  
 CHARLESTON

WELL LOCATION MAP  
 FILE NO. BRO-7

+ Denotes location of well on United States Topographic Maps, scale 1 to 62,500, latitude and longitude lines being represented by border lines as shown.

- Denotes one inch spaces on border line of original tracing.

m  
CECIL B. ZETTY NO. 1 WELL. PR-7 (?)

Cross Creek District, Brooke County, W. Va.  
By J. W. Hugus, Box 174, Follansbee, W. Va.  
On 0.34 acre,  $\frac{1}{2}$  mi. E. of Ohio River.  
Elevation, 740' L.

Surface owned by Cecil B. Zetty, Follansbee, W. Va., and minerals by  
Wheeling Steel Corp., Wheeling, W. Va.

No record of date of completion, etc.

No record of casing.

Oil well. Record to Dept. of Mines stamped Aug. 24, 1948.

Record to RCT from Mrs. Griffith April 18, 1949. Old File No. 52.

"This is an old well purchased by the writer in 1936 from Louis Martin and N. A. Martin. The contractor who drilled this well is now dead and the present whereabouts of the Martins is unknown.

"As there is no log nor other information at hand covering the drilling of the well, the work order proposed for its plugging was made up from information gained when well was under repairs and from comparison of its elevation with those of other near-by wells where detailed drilling records were available and elevations about the same.

J. W. Hugus."

TOTAL DEPTH - (339')