

### west virginia department of environmental protection

Office of Oil and Gas 601 57th Street SE Charleston, WV 25304 (304) 926-0450 (304) 926-0452 fax Earl Ray Tomblin, Governor Randy C. Huffman, Cabinet Secretary www.dep.wv.gov

January 15, 2016

### WELL WORK PERMIT Horizontal 6A Well

This permit, API Well Number: 47-900172, issued to SWN PRODUCTION COMPANY, LLC, is evidence of permission granted to perform the specified well work at the location described on the attached pages and located on the attached plat, subject to the provisions of Chapter 22 of the West Virginia Code of 1931, as amended, and all rules and regulations promulgated thereunder, and to all conditions and provisions outlined in the pages attached hereto. Notification shall be given by the operator to the Oil and Gas Inspector at least 24 hours prior to the construction of roads, locations, and/or pits for any permitted work. In addition, the well operator shall notify the same inspector 24 hours before any actual well work is commenced and prior to running and cementing casing. Spills or emergency discharges must be promptly reported by the operator to 1-800-642-3074 and to the Oil and Gas inspector.

Please be advised that form WR-35, Well Operators Report of Well Work is to be submitted to this office within 90 days completion of permitted well work, as should form WR-34 Discharge Monitoring Report within 30 days of discharge of pits, if applicable. Failure to abide by all statutory and regulatory provisions governing all duties and operations hereunder may result in suspension or revocation of this permit and, in addition, may result in civil and/or criminal penalties being imposed upon the operators.

In addition to the applicable requirements of this permit, and the statutes and rules governing oil and gas activity in WV, this permit may contain specific conditions which must be followed. Permit conditions are attached to this cover letter.

Per 35CSR-4-5.2.g this permit will expire in two (2) years from the issue date unless permitted well work is commenced. If there are any questions, please feel free to contact me at (304) 926-0499 ext. 1654.

James Martin

Chief

Operator's Well No: RUSSELL HERVEY BRK 210H

Farm Name: HERVEY, RUSSELL D.

API Well Number: 47-900172

Permit Type: Horizontal 6A Well

Date Issued: 01/15/2016

### PERMIT CONDITIONS 7 0 0 9 0 0 1 7 2

West Virginia Code § 22-6A-8(d) allows the Office of Oil and Gas to place specific conditions upon this permit. Permit conditions have the same effect as law. Failure to adhere to the specified permit conditions may result in enforcement action.

#### **CONDITIONS**

- 1. This proposed activity may require permit coverage from the United States Army Corps of Engineers (USACE). Through this permit, you are hereby being advised to consult with USACE regarding this proposed activity.
- 2. If the operator encounters an unanticipated void, or an anticipated void at an unanticipated depth, the operator shall notify the inspector within 24 hours. Modifications to the casing program may be necessary to comply with W. Va. Code § 22-6A-5a (12), which requires drilling to a minimum depth of thirty feet below the bottom of the void, and installing a minimum of twenty (20) feet of casing. Under no circumstance should the operator drill more than one hundred (100) feet below the bottom of the void or install less than twenty (20) feet of casing below the bottom of the void.
- 3. When compacting fills, each lift before compaction shall not be more than 12 inches in height, and the moisture content of the fill material shall be within limits as determined by the Standard Proctor Density test of the actual soils used in specific engineered fill, ASTM D698, Standard Test Method for Laboratory Compaction Characteristics of Soil Using Standard Effort, to achieve 95 % compaction of the optimum density. Each lift shall be tested for compaction, with a minimum of two tests per lift per acre of fill. All test results shall be maintained on site and available for review.
- 4. Operator shall install signage per § 22-6A-8g (6) (B) at all source water locations included in their approved water management plan within 24 hours of water management plan activation.
- 5. Oil and gas water supply wells will be registered with the Office of Oil and Gas and all such wells will be constructed and plugged in accordance with the standards of the Bureau for Public Health set forth in its Legislative rule entitled *Water Well Regulations*, 64 C.S.R. 19. Operator is to contact the Bureau of Public Health regarding permit requirements. In lieu of plugging, the operator may transfer the well to the surface owner upon agreement of the parties. All drinking water wells within fifteen hundred feet of the water supply well shall be flow tested by the operator upon request of the drinking well owner prior to operating the water supply well.
- 6. Pursuant to the requirements pertaining to the sampling of domestic water supply wells/springs the operator shall, no later than thirty (30) days after receipt of analytical data provide a written copy to the Chief and any of the users who may have requested such analyses.
- 7. If any explosion or other accident causing loss of life or serious personal injury occurs in or about a well or well work on a well, the well operator or its contractor shall give notice, stating the particulars of the explosion or accident, to the oil and gas inspector and the Chief, within 24 hours of said accident.
- 8. During the casing and cementing process, in the event cement does not return to the surface, the oil and gas inspector shall be notified within 24 hours.
- 9. The operator shall provide to the Office of Oil and Gas the dates of each of the following within 30 days of their occurrence: completion of construction of the well pad, commencement of drilling, cessation of drilling, completion of any other permitted well work, and completion of the well. Such notice shall be provided by sending an email to DEPOOGNotify@wv.gov.

API NO. 47-\_09 OPERATOR WELL NO. Russell Hervey BRK 210H
Well Pad Name: Russell Hervey BRK Pad

# STATE OF WEST VIRGINIA DEPARTMENT OF ENVIRONMENTAL PROTECTION, OFFICE OF OIL AND GAS WELL WORK PERMIT APPLICATION

1) Well Operator: SWN Pr	oduction Co., LLC	494512924	Brooke	1-Buffalo 621-Steubenville
		Operator ID	County	District Quadrangle
2) Operator's Well Number:	Russell Hervey BR	K 210H Well Pag	d Name: Rus	sell Hervey BRK Pad
3) Farm Name/Surface Own	er: Russell D. Herve	ey Public Roa	d Access: Pi	erce Run Road Genteel Ridge
4) Elevation, current ground:	: 116 <b>6</b> El	evation, proposed	post-construc	tion: 116 <b>6</b> '
5) Well Type (a) Gas	Oil	Unde	erground Stora	age
Other _				
V. Zy	Shallow x	Deep		
	Horizontal X			C. 850 10.28.1
6) Existing Pad: Yes or No		· · · · · · · · · · · · · · · · · · ·		
<ol> <li>Proposed Target Formation</li> <li>Target Formation - Marcellus, 7</li> </ol>				d Pressure(s): ckness- 44', Associated Pressure- 3526
8) Proposed Total Vertical D				
9) Formation at Total Vertical		3	47000	1 0 0
			0 0 8	00172
10) Proposed Total Measure	0.000	P) 48 10.8	x-15 5771	
11) Proposed Horizontal Leg	g Length: 2697.75		8 124	
12) Approximate Fresh Water	er Strata Depths:	277'		
13) Method to Determine Fro	esh Water Depths:	Offset wells		
14) Approximate Saltwater I	Depths: 1100'			
15) Approximate Coal Seam	Depths: 287'			
16) Approximate Depth to P	ossible Void (coal mi	ne, karst, other):	None that we	e are aware of.
17) Does Proposed well loca directly overlying or adjacen		ns Yes	N	(o x
(a) If Yes, provide Mine In	fo: Name:			
A salabata a salabata a	Depth:			
	Seam:			
	Owner:			Pg.
				Received Office of Olive or

Page 1 of 3

NOV 05 2015

API NO. 47- 09

OPERATOR WELL NO. Russell Hervey BRK 210H
Well Pad Name: Russell Hervey BRK Pad

18)

### CASING AND TUBING PROGRAM

TYPE	Size (in)	New or Used	Grade	Weight per ft. (lb/ft)	FOOTAGE: For Drilling (ft)	INTERVALS: Left in Well (ft)	CEMENT: Fill-up (Cu. Ft.)/CTS
Conductor	20"	New	H-40	94#	100'	100'	CTS
Fresh Water	13 3/8"	New	H-40	.54 <del>.5#</del> 48#	A 4B 377'	377'	355 sx/CTS
Coal	9 5/8"	New	J-55	40# 36#	A 48 2015'	2015'	776 sx/CTS
Intermediate	7"	New	J-55	20#	If Needed	If Needed	If Needed/As Needed
Production	5 1/2"	New	HCP-110	20#	15,182'	15,182'	Lead 569 sx tail 2060 sx/100' inside
Tubing	2 3/8'	New	P-110	4.7#	Approx. 5902'	Approx. 5902'	
Liners	1						

000175 (. 250

ТҮРЕ	Size (in)	Wellbore Diameter (in)	Wall 1 Thickness (in)	Burst Pressure (psi)	Max. Associated Surface Pressure (psi)	Cement Type	Cement Yield (cu. ft./k)
Conductor	20"	30"	0.25	2120	81	Class A	1.19/50% Excess
Fresh Water	13 3/8"	17.5"	0.380	2740	633	Class A	1.19/50% Excess
Coal	9 5/8"	12 1/4"	0.395	3950	1768	Class A	1.19/50% Excess
Intermediate	7"	8 3/4"	0.317	4360	3250	Class A	1.20/15% Excess
Production	5 1/2"	8 3/4"	0.361	12360	9500	Class A	1.20/15% Excess
Tubing	2 3/8"	4.778"	0.190				
Liners							

### **PACKERS**

Kind:	10K Arrowset AS1-X	
Sizes:	5 1/2"	
Depths Set:		

Received Office of Oil & Gas

NOV 05 2015

Page 2 of 3

W۷	/-6B
(10/	14)

API NO. 47- 09 OPERATOR WELL NO. Russell Hervey BRK 210H
Well Pad Name: Russell Hervey BRK Pad

19)	) Describe j	proposed	well w	ork, incl	uding the	drilling	and pl	lugging	back of	any	pilot l	hole:
-----	--------------	----------	--------	-----------	-----------	----------	--------	---------	---------	-----	---------	-------

Drill and stimulate any potential zones between and including the Benson to Marcellus. \*\*If we should encounter a void place basket above and below void area- balance cement to bottom of void and grout from basket to surface. Run casing not less than 20' below void nor more than 50'-70' below void. (\*If freshwater is encountered deeper than anticipated it must be protected, set casing 50'-70' below and cts.)

47 0 0 9 0 0 1 7 2

20) Describe fracturing/stimulating methods in detail, including anticipated max pressure and max rate:

Well will be perforated within the target formation and stimulated with a slurry of water, sand, and chemical additives at a high rate. This will be performed in stages with the plug and perf method along the wellbore until the entire lateral has been stimulated within the target formation. All stage plugs are then drilled out and the well is flowed back to surface. The well is produced through surface facilities consisting of high pressure production unites, vertical separation units, water and oil storage tanks. Max press and anticipated max rate- 9000 lbs @ 80 barrels a minute.

- 21) Total Area to be disturbed, including roads, stockpile area, pits, etc., (acres): 28.2
- 22) Area to be disturbed for well pad only, less access road (acres): 10.3
- 23) Describe centralizer placement for each casing string:

All casing strings will be ran with a centralizer at a minimum of 1 per every 3 joints of casing.

24) Describe all cement additives associated with each cement type:

See Attachment \*\*\*

25) Proposed borehole conditioning procedures:

All boreholes will be conditioned with circulation and rotation for a minimum of one bottoms up and continuing until operator is satisfied with borehole conditions.

Office of Oil & Gas

NOV **0 5** 2015

<sup>\*</sup>Note: Attach additional sheets as needed.

### **Schlumberger Cement Additives**

			ser cement Additives	-,
	Product Name	Product Use	Chemical Name	CAS Number
Surface	S001	accelerator	calcium chloride	10043-52-4
ntermediate	S001	accelerator	calcium chloride	10043-52-4
	D080	dispersant	sodium polynaphthalene sulfonate	9008-63-3
<u> </u>	D801	retarder	aromatic polymer derivative	propriatary
Kick Off Plug	D047	antifoam	polypropylene glycol	25322-69-4
	D167	fluid loss	aliphatic amide polymer	propriatary
	D154	extender	non-crystalline silica	7631-86-9
	D400	gas migration	boric acid	10043-35-3
			polypropylene glycol	25322-69-4
ad	D046	antifoam	fullers earth (attapulgite)	8031-18-3
Production-Lead			chrystalline silica	14808-60-7
Ę	D201	retarder	metal oxide	propriatary
ğ			sulphonated synthetic polymer	propriatary
Prc	D202	dispersant	formaldehyde (impurity)	propriatary
			polypropylene glycol	25322-69-4
	D046	antifoam	fullers earth (attapulgite)	8031-18-3
	D167	fluid loss	aliphatic amide polymer	propriatary
<b>.</b>			sodium polynaphthalene sulfonate	9008-63-3
Production-Tail	D065	dispersant	sodium sulfate	7757-82-6
ctio			chrystalline silica	14808-60-7
) pgn	D201	retarder	metal oxide	propriatary
Prc	D153	anti-settling	chrystalline silica	14808-60-7

4700900172

Received
Office of Oil & Gas
NOV 05 2015

API Number 47 -	09	•	
Operator's	Well No.	Russell Hervey BRK 210H	

### STATE OF WEST VIRGINIA DEPARTMENT OF ENVIRONMENTAL PROTECTION OFFICE OF OIL AND GAS

### FLUIDS/ CUTTINGS DISPOSAL & RECLAMATION PLAN

Operator Name SWN Production Co., LL	LC	OP Code 494512924	
Watershed (HUC 10) Buffalo Creek	Quadrangle	Stuebenville	
Elevation	County_Brooke	DistrictBuffalo	
Will a pit be used? Yes	000 bbls of water to complete the proposed		
If so, please describe anticipa	ated pit waste.	this time- cuttings will be taken to a permitted landfill.	
Will a synthetic liner be used		f so, what ml.?	
Proposed Disposal Method F			
Land Appl	ication nd Injection (UIC Permit Number_2D007;	2539/ 2D0413175/ 2D0610306/ 2D0610317	
Reuse (at A	API Number at next anticipated well, API# will be inc	cluded with the WR-34/DDMR &/or permit addendum.	
Off Site Di Other (Exp	isposal (Supply form WW-9 for disposal lo plain_ flow back fluids will be put in steel tanks a	ocation) and reused or taken to a permitted disposal facility.	
Will closed loop system be used? If s	so, describe:Yes		
Drilling medium anticipated for this v	well (vertical and horizontal)? Air, freshwa	ter, oil based, etc. Af drill to KOP, Fluid drill with SOBM from KOP to TD	
-If oil based, what type? Syr	nthetic, petroleum, etc.Synthetic Oil Base		
Additives to be used in drilling mediu	im? see attached sheets	47	
	e in pit, landfill, removed offsite, etc. landfill	4/0090	
-If left in pit and plan to solid	dify what medium will be used? (cement, I	ime, sawdust) 172	
Arden Landfill 100/2, Americ	can U2-12954, Country Wide 383	SWF-1025, Short Creek 1034/WV0109517/CID28726, Carbon Limestone 28726/CID28726 39U/CID3839U, PINE Grove 13688	
on August 1, 2005, by the Office of Corprovisions of the permit are enforced law or regulation can lead to enforced application form and all attachment obtaining the information, I believe	Dil and Gas of the West Virginia Departmentable by law. Violations of any term or content action.  aw that I have personally examined and a state thereto and that, based on my inquiry that the information is true, accurate, and	GENERAL WATER POLLUTION PERMIT at of Environmental Protection. I understand to addition of the general permit and/or other app arm familiar with the information submitted of those individuals immediately responsible d complete. I am aware that there are sign	that the blicable on this ble for
penalties for submitting false informa	tion, including the possibility of fine or imp	.100010	
Company Official Signature		Office of Oi	R Gas
Company Official (Typed Name) De	ee Southalf	NOV 0 5 2	2015
Company Official Title Regulatory S	Supervisor		
Subscribed and sworn before me this	21th day of October	Notary Public State  Notary Public State  BRITTANY  3302 Old El  Buckhannon  My commission expire	R WOODY
My commission expires	<b>W</b>	01/1	15/2016

Proposed Payagatation Tracti	2	8.2	
as determined by pH test	ment: Acres Disturbed 2	10.2	[
Lime 10-20	Tons/acre or to corre	ct to pH	
Fertilizer type			
Fertilizer amount 60		lbs/acre	
<sub>Mulch</sub> Hay/Stra	aw 2.5	_Tons/acre	
		Seed Mixtures	
Те	mporary	Permai	nent
Seed Type	lbs/acre	Seed Type	lbs/acre
White Grove	15	White Grove	15
Red Top	15	Red Top	15
Orchard Grass	20	Orchard Grass	20
provided)		land application (unless engineered plans inc	cluding this info have bee
Photocopied section of involv	ved 7.5' topographic sheet.		eluding this info have bee
provided)  Photocopied section of involve the	ved 7.5' topographic sheet.		eluding this info have bee
Drawing(s) of road, location, provided)  Photocopied section of involv  Plan Approved by:  Comments:	ved 7.5' topographic sheet.		
provided)  Photocopied section of involv  Plan Approved by:	ved 7.5' topographic sheet.	o· 2 & · 15-	0172
provided)  Photocopied section of involve the	ved 7.5' topographic sheet.	o· 2 & · 15-	
provided)  Photocopied section of involv  Plan Approved by:	ved 7.5' topographic sheet.	o· 2 & · 15-	)
provided)  Photocopied section of involv  Plan Approved by:	ved 7.5' topographic sheet.	o· 2 & · 15-	Pece Office of


### Marcellus Well Drilling Procedures And Site Safety Plan


SWN Production Co., LLC

47 - 051 Well name: Russell Hervey BRK 210H
Stuebenville East, Quad
Buffalo, District
Brooke County, West Virginia

4700900172 Submitted by: 10/27/2015 Danielle Southall Date: SWN Production Co., LLC Title Regulatory Supervisor Approved by: 10.51.15 Date: + Gra Inspertor Title: Approved by: Date: Title: SWN Production Co., LLC - Confidential

Received
Office of Oil & Gas
NOV 0.5 2015

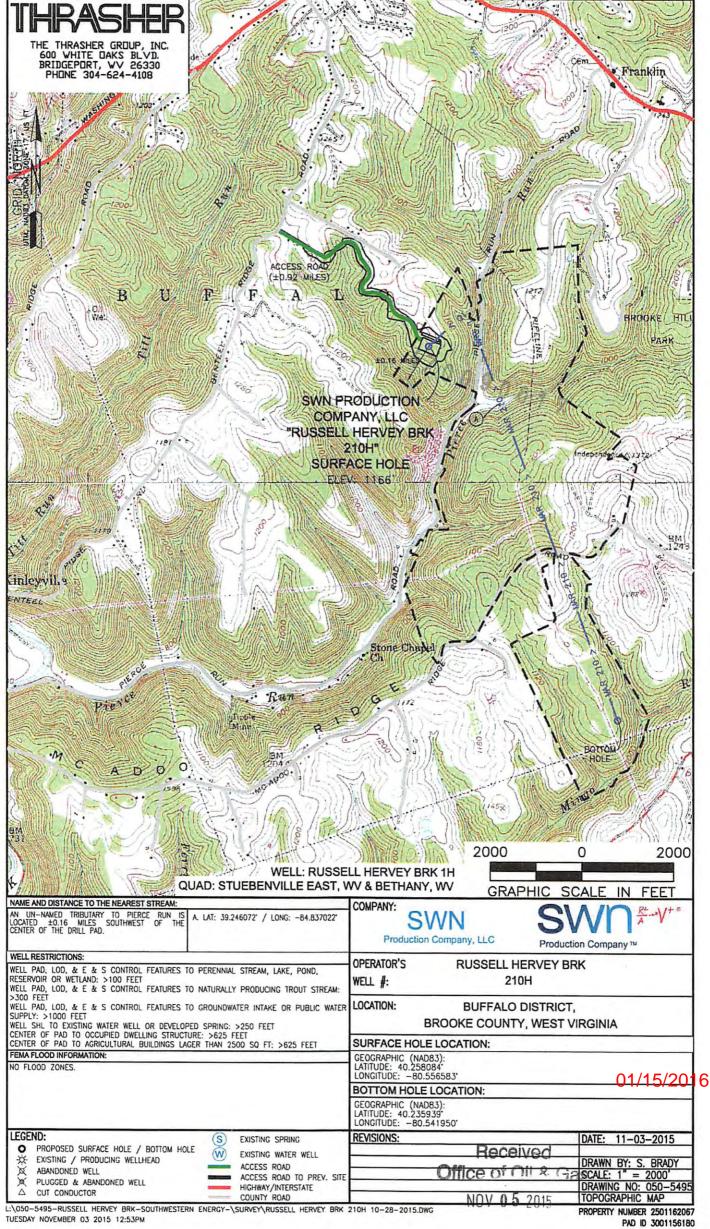

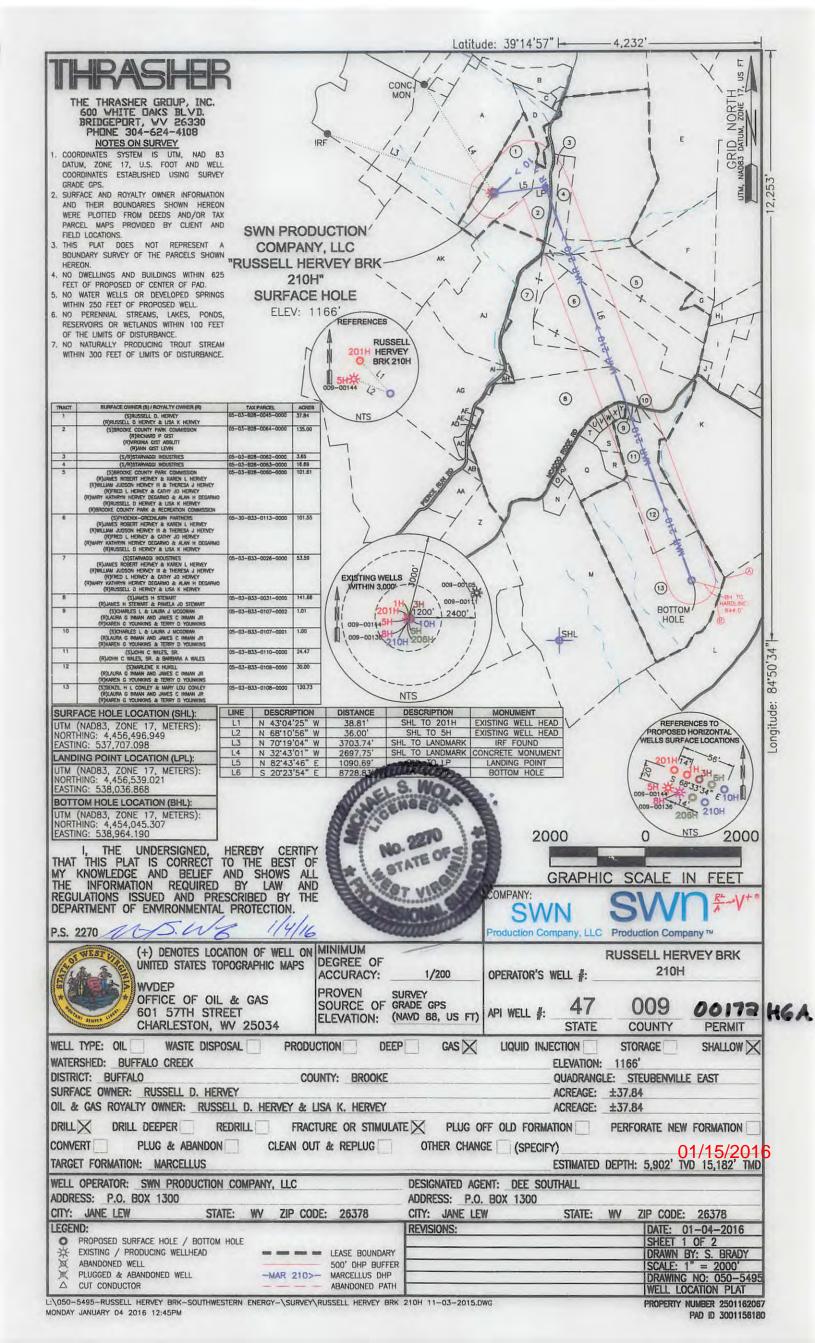



THE THRASHER GROUP, INC. 600 WHITE DAKS BLVD. BRIDGEPORT, WV 26330 PHONE 304-624-4108

TRACT	ADJOINER	PARCEL
Α	WILLIAM JUDSON HERVEY, III	05-03-B28-0045-0002
В	DONALD AND JANICE EATON	05-03-B28-0057-0000
С	BERNARD J. KNORR, III AND NICOLE C. KNORR	05-03-B28-0057-0002
D	BERNARD J. KNORR, III AND NICOLE C. KNORR	05-03-B28-0059-0000
E	BROOKE COUNTY COURT	05-03-B28-0065-0000
F	BROOKE COUNTY COURT	05-03-B28-0061-0000
G	BROOKE COUNTY PARK COMMISSION	05-03-B33-0117-0000
Н	KEITH R. & KATHY J SMITH	05-03-B34-0016-0001
1	KEITH R. & KATHY J SMITH	05-03-B33-0114-0000
J	BRIAN K. SMITH	05-03-B33-0114-0001
K	BARBARA A WALES	05-03-B34-0017-0000
L	MARK W. OWEN & VIRGINIA B, KREUTZ	05-03-B34-0049-0000
M	CHARLES R. CORBIN, JR., ET AL	05-03-B33-0102-0000
N	CHARLES R. CORBIN, JR.	05-03-B33-0103-0000
0 (	HARLES R. CORBIN, JR. & MARGARET L. CORBIN	05-03-B33-0104-0000
P	MARGARET E. CORBIN	05-03-B33-0105-0000
Q	HENRY E. DONLEY, IV & YVONNE CAWTHORNE	05-03-B33-0106-0000
R	SARA M. MAGLIETTA	05-03-B33-0111-0000
S	CARL J. MAGLIETTA, JR. & TINA D. MAGLIETTA	05-03-B33-0111-0001
T	JOHN T. & SALLY J. MILLER	05-03-B33-0112-0000
U	JAMIE D. BURNS	05-03-B33-0107-0006
V	JAMIE D BURNS	05-03-B33-0107-0005
W	DON KOSCEVIC, ET AL	05-03-B33-0107-0000
X	CHARLES L. & LAURA J MCGOWAN	05-03-B33-0107-0004
Y	CHARLES L. & LAURA J MCGOWAN	05-03-B33-0107-0003
Z	MELVIN & DORIS CULBERTSON	05-03-B33-0096-0000
AA	PHOENIX-GREENLAWN PARTNERS, LP	05-03-B33-0035-0000
AB	PHOENIX-GREENLAWN PARTNERS, LP	05-03-B33-0034-0000
AC	SHARON CUNNINGHAM	05-03-B33-0030-0000
AD	DONALD M. & JANICE F. EATON	05-03-B33-0033-0000
AE	SHARON CUNNINGHAM	05-03-B33-0033-0001
AF	SHARON CUNNINGHAM	05-03-B33-0032-0000
AG	PHOENIX-GREENLAWN PARTNERS, LP	05-03-B33-0029-0000
AH	THEODORE E. & MELISSA A. EATON	05-03-B33-0028-0000
Al	STELLA MERWICK	05-03-B33-0027-0000
AJ	STARVAGGI INDUSTRIES	05-03-B33-0025-0000
AK	MICHAEL WHITCO, ET AL	05-03-B28-0043-0000

REVISIONS:

O1/15/2016

COMPANY:

SWN

Production Company, LLG

Production Company

DATE: 01-04-2016

SHEET 2 OF 2

DRAWN BY: S. BRADY

SCALE: 1" = 2000'

DRAWING NO: 050-5495

WELL LOCATION PLAT

THE THRASHER GROUP, INC. 600 WHITE DAKS BLVD. BRIDGEPORT, WV 26330 PHONE 304-624-4108

TRACT	ADJOINER	PARCEL
Α	WILLIAM JUDSON HERVEY, III	05-03-B28-0045-0002
В	DONALD AND JANICE EATON	05-03-B28-0057-0000
C	BERNARD J. KNORR, III AND NICOLE C. KNORR	05-03-B28-0057-0002
D	BERNARD J. KNORR, III AND NICOLE C. KNORR	05-03-B28-0059-0000
E	BROOKE COUNTY COURT	05-03-B28-0065-0000
F	BROOKE COUNTY COURT	05-03-B28-0061-0000
G	BROOKE COUNTY PARK COMMISSION	05-03-B33-0117-0000
H	KEITH R. & KATHY J SMITH	05-03-B34-0016-0001
1	KEITH R. & KATHY J SMITH	05-03-B33-0114-0000
J	BRIAN K. SMITH	05-03-B33-0114-0001
K	BARBARA A WALES	05-03-B34-0017-0000
L	MARK W. OWEN & VIRGINIA B. KREUTZ	05-03-B34-0049-0000
М	CHARLES R. CORBIN, JR., ET AL	05-03-B33-0102-0000
N	CHARLES R. CORBIN, JR.	05-03-B33-0103-0000
0 (	HARLES R. CORBIN, JR. & MARGARET L. CORBIN	05-03-B33-0104-0000
P	MARGARET E. CORBIN	05-03-B33-0105-0000
Q	HENRY E. DONLEY, IV & YVONNE CAWTHORNE	05-03-B33-0106-0000
R	SARA M. MAGLIETTA	05-03-B33-0111-0000
S	CARL J. MAGLIETTA, JR. & TINA D. MAGLIETTA	05-03-B33-0111-0001
T	JOHN T. & SALLY J. MILLER	05-03-833-0112-0000
U	JAMIE D. BURNS	05-03-B33-0107-0006
V	JAMIE D BURNS	05-03-B33-0107-0005
W	DON KOSCEVIC, ET AL	05-03-B33-0107-0000
X	CHARLES L. & LAURA J MCGOWAN	05-03-B33-0107-0004
Y	CHARLES L. & LAURA J MCGOWAN	05-03-B33-0107-0003
Z	MELVIN & DORIS CULBERTSON	05-03-B33-0096-0000
AA	PHOENIX-GREENLAWN PARTNERS, LP	05-03-B33-0035-0000
AB	PHOENIX-GREENLAWN PARTNERS, LP	05-03-B33-0034-0000
AC	SHARON CUNNINGHAM	05-03-B33-0030-0000
AD	DONALD M. & JANICE F. EATON	05-03-B33-0033-0000
AE	SHARON CUNNINGHAM	05-03-B33-0033-0001
AF	SHARON CUNNINGHAM	05-03-B33-0032-0000
AG	PHOENIX-GREENLAWN PARTNERS, LP	05-03-B33-0029-0000
AH	THEODORE E. & MELISSA A. EATON	05-03-B33-0028-0000
Al	STELLA MERWICK	05-03-B33-0027-0000
AJ	STARVAGGI INDUSTRIES	05-03-B33-0025-0000
AK	MICHAEL WHITCO, ET AL	05-03-B28-0043-0000

Received Office of Oil & Gas NOV 0 5 2015

6 COMPANY:

REVISIONS:	DATE: 11-03-2015
	SHEET 2 OF 2
	DRAWN BY: S. BRADY
	SCALE: 1" = 2000'
	DRAWING NO: 050-5495
	WELL LOCATION PLAT

WW-6A1 (5/13)

### INFORMATION SUPPLIED UNDER WEST VIRGINIA CODE Chapter 22, Article 6A, Section 5(a)(5) IN LIEU OF FILING LEASE(S) AND OTHER CONTINUING CONTRACT(S)

Under the oath required to make the verification on page 1 of this Notice and Application, I depose and say that I am the person who signed the Notice and Application for the Applicant, and that —

- (1) the tract of land is the same tract described in this Application, partly or wholly depicted in the accompanying plat, and described in the Construction and Reclamation Plan;
- (2) the parties and recordation data (if recorded) for lease(s) or other continuing contract(s) by which the Applicant claims the right to extract, produce or market the oil or gas are as follows:

Lease Name or
Number Grantor, Lessor, etc. Grantee, Lessee, etc. Royalty Book/Page

Received
Office of Oil & Gas
NOV 0 5 2015

### Acknowledgement of Possible Permitting/Approval In Addition to the Office of Oil and Gas

The permit applicant for the proposed well work addressed in this application hereby acknowledges the possibility of the need for permits and/or approvals from local, state, or federal entities in addition to the DEP, Office of Oil and Gas, including but not limited to the following:

- WV Division of Water and Waste Management
- WV Division of Natural Resources WV Division of Highways
- U.S. Army Corps of Engineers
- U.S. Fish and Wildlife Service
- County Floodplain Coordinator

The applicant further acknowledges that any Office of Oil and Gas permit in no way overrides, replaces, or nullifies the need for other permits/approvals that may be necessary and further affirms that all needed permits/approvals should be acquired from the appropriate authority before the affected activity is initiated.

Well Operator:	SWN Production Company, LLC.	
By:	Jerry L. Bridgens, CPL	1/
Its:	Staff Landman	
	<del></del>	

Page 1 of \_\_\_\_

Havey 210H 2016

1)	2)		3)		4)	5)	6)
3-B28-45	3-B28-64		3-B28-62		3-B28-63	3-B28-p/o 60	3-B33-p/o 113
Russell D. Hervey	Brooke County Park Commission		Starvaggi Industries		Starvaggi Industries	Brooke County Park Commission	Phoenix-Greenlawn Partners
1-342823-000	1-324062-001 1-324062-002 1-324062-003		1-324527-000		1-324527-000	1-357894-001 1-357894-002 1-357894-003 1-357894-004 1-357894-005 1-329491-000	1-357894-001 1-357894-002 1-357894-003 1-357894-004 1-357894-005
Russell D. Hervey and Lisa K. Hervey  Chesaneake Annalachia IIIC	70	Fortuna Energy, Inc. Range Resources-Appalachia, LLC Chesapeake Appalachia, LLC	Starvaggi Industries, Inc. Fortuna Energy, Inc.	Range Resources-Applachia, LLC Chesapeake Appalachia, LLC	Starvaggi Industries, Inc. 470090 Fortuna Energy, Inc. Range Resources-Applachia, LLC Chesapeake Appalachia, LLC	James Robert Hervey and Karen L. Hervey William Judson Hervey III and Theresa J. Hervey Fred L. Hervey and Cathy Jo Hervey Mary Kathryn Hervey DeGarmo and Alan H. DeGarmo Russell D. Hervey and Lisa K. Hervey Brooke County Park and Recreation Commission Chesapeake Appalachia, LLC	James Robert Hervey and Karne L. Hervey William Judson Hervey III and Theresa J. Hervey Fred L. Hervey and Cathy Jo Hervey Mary Kathryn Hervey DeGarmo and Alan H. DeGarmo Russell D. Hervey and Lisa K. Hervey Chesapeake Appalachia, LLC
Chesapeake Appalachia, LLC SWN Production Company	Fortuna Energy, Inc. Fortuna Energy, Inc. Fortuna Energy, Inc.	Range Resources-Appalachia, LLC Chesapeake Appalachia, LLC SWN Production Company	Fortuna Energy, Inc. Range Resources-Appalachia, LLC	Chesapeake Appalachia, LLC SWN Production Company	Fortuna Energy, Inc. Range Resources-Appalachia, LLC Chesapeake Appalachia, LLC SWN Production Company	Chesapeake Appalachia, LLC SWN Production Company	Chesapeake Appalachia, LLC SWN Production Company
01/1 <mark>5</mark> 18.000%	12.500% 12.500% 12.500%		12.500%		12.500%	18.000% 18.000% 18.000% 18.000% 18.000% 18.000%	18.000% 18.000% 18.000% 18.000% 18.000%
17/89	10/61 10/67 10/69	10/239 10/552 30/480	9/532 10/226	10/541 30/480	9/532 10/226 10/541 30/480	20/191 20/186 20/522 20/527 20/527 20/532 13/43 30/480	20/191 20/186 20/522 20/527 20/527 20/532 30/480

			ADJOINING TRACTS		William Indeen Henry	3_B28_/5_2	2
20/10/		Switch Loadscale Combany	cilesapeane Appaiacilia, LEC				
30//80		SWAI Production Company	Characado Annalachia IIC				
30/480		Chesapeake Appalachia, LLC	Chevron USA, Inc.				
20/448		Chevron USA, Inc.	NPAR, LLC				
16/547		NPAR, LLC	Tri-Energy Holdings, LLC				
10/607		Tri-Energy Holdings, LLC	Karen G. Younkins and Terry D. Younkins	1-384446-000			
	18.000%	Tri-Energy Holdings, LLC	Laura G. Inman and James C. Inman, Jr.	1-384446-000	Denzil H. L. Conley and Mary Lou Conley	3-B33-108	13)
30/480		SWN Production Company	Chesapeake Appalachia, LLC				
30/480		Chesapeake Appalachia, LLC	Chevron USA, Inc.				
20/448		Chevron USA, Inc.	NPAR, LLC		NOV 0 5 2015		
16/547		NPAR, LLCV U	Tri-Energy Holdings, LLC		Office of Office day		
10/607		Tri-Energy Holdings, LLC	Karen G. Younkins and Terry D. Younkins	1-384446-000	Office Colors		
	18.000%	Tri-Energy Holdings, LLC	Laura G. Inman and James C. Inman, Jr.	1-384446-000	Marlene K. Hukilla	3-B33-109	12)
30/480		SWN Production Company	Chesapeake Appalachia, LLC				
28/664		Chesapeake Appalachia, LLC	Chevron USA, Inc.				
20/448		Chevron USA, Inc.	NPAR, LLC				
0% 10/601	18.000%	Tri-Energy Holdings, LLC	John C. Wales, Sr. and Barbara A. Wales	1-384445-000	John C. Wales, Sr.	3-B33-110	11)
30/480		SWN Production Company	Chesapeake Appalachia, LLC				
25/785		Chesapeake Appalachia, LLC	Range Resources-Appalachia, LLC				
0% 325/125	12.500%	Great Lakes Energy Partners, LLC	Karen G. Younkins and Terry D. Younkins	1382502-002			
0% 9/422	12.500%	Great Lakes Energy Partners, LLC	Laura G. Inman and James C. Inman, Jr.	1382502-001	Charles L. and Laura J. McGowan	3-B33-107.1	10)
30/480		SWN Production Company	Chesapeake Appalachia, LLC				
25/785		Chesapeake Appalachia, LLC	Range Resources-Appalachia, LLC				
0% 325/125	12.500%	Great Lakes Energy Partners, LLC	Karen G. Younkins and Terry D. Younkins	1382502-002			
0% 9/422	12.500%	Great Lakes Energy Partners, LLC	Laura G. Inman and James C. Inman, Jr.	1382502-001	Charles L. and Laura J. McGowan	3-B33-107.2	(6
30/480		SWN Production Company	Chesapeake Appalachia, LLC				
0% 10/431	14.000%	Chesapeake Appalachia, LLC	James H. Stewart and Pamela Jo Stewart	1-264325-000	James H. Stewart	3-B33-31	(8
30/480		SWN Production Company	Chesapeake Appalachia, LLC				
0% 20/532	18.000%	Chesapeake Appalachia, LLC	Russell D. Hervey and Lisa K. Hervey	1-357894-005			
0% 20/527	18.000%	Chesapeake Appalachia, LLC	Mary Kathryn Hervey DeGarmo and Alan H. DeGarmo	1-357894-004			
0% 20/522	O 18.000%	Chesapeake Appalachia, LLC	Fred L. Hervey and Cathy Jo Hervey	1-357894-003			
0% 20/186	18.000%	Chesapeake Appalachia, LLC	William Judson Hervey III and Theresa J. Hervey	1-357894-002			
0% 20/191		Chesapeake Appalachia, LLC	James Robert Hervey and Karen L. Hervey	1-357894-001	Starvaggi Industries	3-B33-p/o 26	7)

AI)	AH)	AG)	AF)	AE)	AD)	AC)	AB)	AA)	Z)	<b>3</b>	×	٤	3	S	크	S)	R)	9	P)	0)	N)	<u>∠</u>	L)	Σ)	(L	Ξ	Н)	G)	F)	E)	D)	C)	в)
3-833-28	3-833-29	3-833-32	3-B33-33.1	3-833-33	3-B33-30	3-B33-34	3-B33-35	3-B33-96	3-B33-102	3-B34-49	3-B34-17	3-B33-111	3-B33-111.1	3-B33-103	3-B33-104	3-B33-105	3-B33-106	3-833-112	3-B33-107.6	3-B33-107.5	3-B33-107	3-B33-107.4	3-B33-107.3	3-B33-110	3-B34-16.1	3-B33-114.1	3-833-114	3-B33-117	3-828-61	3-828-65	3-828-59	3-B28-57.02	3-B28-57
Theodore E. and Melissa A. Eaton	Phoenix-Greenlawn Partners, LP	Sharon A. Cunningham	Sharon A. Cunningham	Donald M. and Janice F. Eaton	Sharon Cunningham	Phoenix-Greenlawn Partners, LP	Phoenix-Greenlawn Partners, LP	Melvin and Doris Culbertson	Charles R. Corbin, Jr., et al	Mark W. Owen and Virginia B. Kreutz	Barbara A. Wales	Sara M. Maglietta	Carl J. Maglietta, Jr. and Tina D. Maglietta	Charles R. Corbin, Jr.	Charles R. Corbin, Jr. and Margaret L. Corbin	Margaret E. Corbin	Henry E. Donley, IV and Yvonne Cawthorne	John T. and Sally J. Miller	Jamie D. Burns	Jamie D. Burns	Don Koscevic, et al	Charles L. and Laura J. McGowan	Charles L. and Laura J. McGowan	Barbara A. Wales	Keith R. and Kathy J. Smith	Brian K. Smith	Keith R. and Kathy J. Smith	Brooke County Park Commission	Brooke County Court	<b>Brooke County Court</b>	Bernard J. Knorr, III and Nicole C. Knorr	Bernard J. Knorr, III and Nicole C. Knorr	Donald and Janice Eaton
																										C102 G D VON	CIIIDS OF Survey Survey	Office of Oil & Gas	Bacelved				
														4	7	C	<b>C</b>	Q	n	<u> </u>	4	7	9										
																																	5/2016

Received Office of Oil & Gas
------------------------------

«>nn900172

AL)	AK)	<u>A</u>	
3-B28-43	3-B33-25	3-B33-27	
3-43	3-25	3-27	
N	S		
Michael Whitco, et al	Starvaggi Industries	Stella	
Vhitco,	i Indust	Stella Merwick	
et al	ries	<del>-</del>	
		!	
01	/1	5/2	2016



Jane Lew, WV 26378 PHONE: (832) 796-1610

November 2, 2015

Ms. Laura Adkins WV DEP Office of Oil & Gas 601 57<sup>th</sup> St., SE Charleston, WV 25304

RE: SWN's proposed Russell Hervey BRK 10H & Russell Hervey BRK 210H in Brooke County, West Virginia, Drilling under Pierce Run Road and McAdoo Ridge Road.

Dear Ms. Adkins:

SWN Production Company, LLC ("SWN") is applying for a drilling permit for the above referenced well. The State of West Virginia has raised some concern as to SWN's right to drill under Pierce Run Road and McAdoo Ridge Road. Please be advised that SWN has leased all mineral owners under said route as it relates to the above-referenced well and unit.

Thank you.

Sincerely,

Jerry L. Bridgens, CPL

Staff Landman

SWN Production Company, LLC

PO Box 1300

Jane Lew, WV 26378

Received
Office of Oil & Gas

NOV 0 5 2015

4700900172

The Right People doing the Right Things, wisely Investing the cash flow from our underlying Assets, will create Value+ Date of Notice Certification:

## STATE OF WEST VIRGINIA DEPARTMENT OF ENVIRONMENTAL PROTECTION, OFFICE OF OIL AND GAS NOTICE CERTIFICATION

API No. 47- 09 -

				Operator's	Well No. Russ	sell Hervey BRK 210H
				Well Pad	Name: Russell	Hervey BRK Pad
	been given: ne provisions in West Virginia Coo tract of land as follows:	de § 22-6A, th	ne Operator has pro	vided the re	quired parties v	with the Notice Forms listed
State:	WV			Easting:	537707.098	
County:	Brooke		UTM NAD 83	Northing:	4456496.949	
District:	Buffalo		Public Road Acc		Pierce Run Road	<u> </u>
Quadrangle:	Stuebenville		Generally used f	farm name:	Russell Hervey	
Watershed:	Buffalo Creek					-
prescribed by it has provide information re of giving the requirements Virginia Code	West Virginia Code § 22-6A-7(b the secretary, shall be verified an ed the owners of the surface des equired by subsections (b) and (c) surface owner notice of entry to of subsection (b), section sixteen e § 22-6A-11(b), the applicant sha have been completed by the appli	nd shall contains scribed in sub the section sixte to survey pursuent of this artical the same of the survey of th	n the following inf divisions (1), (2) a en of this article; ( uant to subsection the were waived in	Formation: (1 and (4), subii) that the re (a), section writing by	4) A certification (b), se equirement was ten of this artification the surface of	ion from the operator that (inction ten of this article, the deemed satisfied as a resulticle six-a; or (iii) the notice wher; and Pursuant to Wes
that the Ope	West Virginia Code § 22-6A, the rator has properly served the requect ALL THAT APPLY	Operator has aired parties w	attached proof to	this Hotige	द्वेतरिहिट्यी <mark>ि</mark> जी	OOG OFFICE USE
☐ 1. NO1	TICE OF SEISMIC ACTIVITY		TICE NOT REQUI			☐ RECEIVED/ NOT REQUIRED
☐ 2. NO	TICE OF ENTRY FOR PLAT SU	RVEY or	NO PLAT SURV	EY WAS C	ONDUCTED	☐ RECEIVED
■ 3. NO	TICE OF INTENT TO DRILL	NOTICE	TICE NOT REQUI OF ENTRY FOR ONDUCTED or			☐ RECEIVED/ NOT REQUIRED
			ITTEN WAIVER LEASE ATTACH		CE OWN ROBER OF	eived Oil & Gas
■ 4. NO	ΓΙCE OF PLANNED OPERATIO	N			NOV	<b>5</b> 2 <b>015</b> CEIVED
■ 5. PUE	BLIC NOTICE					RECEIVED
■ 6. NO	TICE OF APPLICATION					RECEIVED

### Required Attachments:

The Operator shall attach to this Notice Certification Form all Notice Forms and Certifications of Notice that have been provided to the required parties and/or any associated written waivers. For the Public Notice, the operator shall attach a copy of the Class II Legal Advertisement with publication date verification or the associated Affidavit of Publication. The attached Notice Forms and Certifications of Notice shall serve as proof that the required parties have been noticed as required under West Virginia Code § 22-6A. Pursuant to West Virginia Code § 22-6A-11(b), the Certification of Notice to the person may be made by affidavit of personal service, the return receipt card or other postal receipt for certified mailing.

### Certification of Notice is hereby given:

THEREFORE, I \_\_\_\_\_\_\_\_, have read and understand the notice requirements within West Virginia Code § 22-6A. I certify that as required under West Virginia Code § 22-6A, I have served the attached copies of the Notice Forms, identified above, to the required parties through personal service, by registered mail or by any method of delivery that requires a receipt or signature confirmation. I certify under penalty of law that I have personally examined and am familiar with the information submitted in this Notice Certification and all attachments, and that based on my inquiry of those individuals immediately responsible for obtaining the information, I believe that the information is true, accurate and complete. I am aware that there are significant penalties for submitting false information, including the possibility of fine and imprisonment.

Well Operator: SWN Production Co., LLC

By: Dee Southall

Its: Regulatory Supervisor


Telephone: 304-884-1610

Address: P.O. Box 1300

Jane Lew, WV 26378

Facsimile: 304-471-2497

Email: Dee\_Southall@swn.com

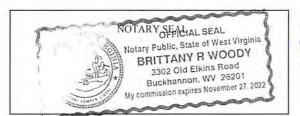

Subscribed and sworn before me this day of

Brittany & Moody

Notary Public

My Commission Expires\_

### Oil and Gas Privacy Notice:

The Office of Oil and Gas processes your personal information, such as name, address and telephone number, as part of our regulatory duties. Your personal information may be disclosed to other State agencies or third parties in the normal course of business or as needed to comply with statutory or regulatory requirements, including Freedom of Information Act requests. Our office will appropriately secure your personal information. If you have any questions about our use or your personal information, please contact DEP's Chief Privacy Officer at depprivacyofficer@wv.gov.

470090017

Received
Office of Oil & Gas
NOV 0 5 2015

WW-6A (9-13) API NO. 47- 99 OPERATOR WELL NO. Russell Hervey BRK 210H
Well Pad Name: Russell Hervey BRK Pad

### STATE OF WEST VIRGINIA DEPARTMENT OF ENVIRONMENTAL PROTECTION, OFFICE OF OIL AND GAS NOTICE OF APPLICATION

Not	ice Time Requiren	nent: notice shall be provi	ded no later tha	the filing date of permit app	lication.
Dat	e of Notice:	Date Permit Applica	tion Filed:		
	ice of:				
	127, 451				
✓	PERMIT FOR AN	NY 🔲 CERTIFI	CATE OF APP	ROVAL FOR THE	
	WELL WORK	CONSTI	RUCTION OF A	N IMPOUNDMENT OR PIT	
Del	ivery method purs	uant to West Virginia Co	ode § 22-6A-10	(b)	
	PERSONAL	✓ REGISTERED	☐ METHO	OD OF DELIVERY THAT RE	QUIRES A
-	SERVICE	MAIL		PT OR SIGNATURE CONFIR	
the soil a description of the soil a description open more well impensive provents substraction of the soil and the soil a	surface of the tract of and gas leasehold being cribed in the erosion rator or lessee, in the re coal seams; (4) The I work, if the surface oundment or pit as de a water well, spring wide water for consur- posed well work active section (b) of this sec- ords of the sheriff requision of this article to the R. § 35-8-5.7.a re-	n which the well is or is pro- ng developed by the propos- and sediment control plans a event the tract of land on ver- e owners of record of the su- tract is to be used for the pre- escribed in section nine of gor water supply source loc- inption by humans or domes- vity is to take place. (c)(1) I etion hold interests in the la- uired to be maintained purs- to the contrary, notice to a I quires, in part, that the open	sposed to be locally sed well work, if submitted pursual which the well prurface tract or tractional lacement, constructional strated within one stic animals; and if more than three onds, the applicant suant to section eiten holder is not rator shall also properties.	ted; (2) The owners of record of the surface tract is to be used for int to subsection (c), section seve oposed to be drilled is located [s ets overlying the oil and gas least action, enlargement, alteration, rony surface owner or water purve housand five hundred feet of the (6) The operator of any natural g tenants in common or other co- t may serve the documents requi- ight, article one, chapter eleven- notice to a landowner, unless the	red upon the person described in the a of this code. (2) Notwithstanding any lien holder is the landowner. W. Va. "WSSP") to the surface owner and any
Ø A	Application Notice	☑ WSSP Notice ☑ E&	S Plan Notice	☑ Well Plat Notice is hereb	y provided to:
☑ S	URFACE OWNER	(s)		☑ COAL OWNER OR LESSE	BE, 00900172
	ne: Russell D. Hervey			Name: Starvaggi Industries, INC	001/2
Add	ress: 200 Carol Street			Address: 401 Pennsylvania Ave	
_	sburg, WV 26070	,		Weirton, WV 26062	
	ne: Robert & Ellen Stanle		-	☐ COAL OPERATOR	
	iress: 201 Genteel Road	V	_	Name:	
	sburg, WV 26070		Suc Di	Address:	
		(s) (Road and/or Other Di			ATTEN MICH
Nan	ne:			SURFACE OWNER OF W	
Add	iress:		_	AND/OR WATER PURVEY	JK(s)
			_	Name: William Hervey	District Const
Nan	ne:		-	Address: 1030 Washington Pike	Received
Add	iress:		-	DODED A TOP OF ANY NAT	TURA TURA TERES
_ C	LIDEACE OWNED	(s) (Impoundments or Pits	<u>, x</u>		
_				Name:Address:	NOV 0 5 2015
Ada	lress.			1,544,600.	
, ruc	1.0031			*Please attach additional form	s if necessary

WW-6A (9-13) API NO. 47- 99 OPERATOR WELL NO. Russell Hervey BRK 210H
Well Pad Name: Russell Hervey BRK Pad

### STATE OF WEST VIRGINIA DEPARTMENT OF ENVIRONMENTAL PROTECTION, OFFICE OF OIL AND GAS NOTICE OF APPLICATION

Not	ice Time Requiren	nent: notice shall be provi	ded no later than the filing date of permit application.
Dat	e of Notice:	Date Permit Applica	tion Filed:
Not	ice of:		
<b>V</b>	PERMIT FOR AN		CATE OF APPROVAL FOR THE RUCTION OF AN IMPOUNDMENT OR PIT
Del	ivery method purs	uant to West Virginia Co	ode § 22-6A-10(b)
	PERSONAL		☐ METHOD OF DELIVERY THAT REQUIRES A
	SERVICE	MAIL	RECEIPT OR SIGNATURE CONFIRMATION
the soil a description open more well important proven proper substruction of the control of the	surface of the tract or and gas leasehold being tribed in the erosion at ator or lessee, in the e coal seams; (4) The work, if the surface oundment or pit as do a water well, spring yide water for consumptions water well work active extraction (b) of this seconds of the sheriff requision of this article to e. R. § 35-8-5.7.a recond	n which the well is or is pro- ng developed by the propos- and sediment control plan s- event the tract of land on w- e owners of record of the su- tract is to be used for the p- escribed in section nine of the gor water supply source loc- inption by humans or domes- vity is to take place. (c)(1) I stion hold interests in the lan- uired to be maintained purs- to the contrary, notice to a li- quires, in part, that the oper-	his article, and the well plat to each of the following persons: (1) The owners of record of posed to be located; (2) The owners of record of the surface tract or tracts overlying the red well work, if the surface tract is to be used for roads or other land disturbance as submitted pursuant to subsection (c), section seven of this article; (3) The coal owner, which the well proposed to be drilled is located [sic] is known to be underlain by one or urface tract or tracts overlying the oil and gas leasehold being developed by the proposed lacement, construction, enlargement, alteration, repair, removal or abandonment of any this article; (5) Any surface owner or water purveyor who is known to the applicant to atted within one thousand five hundred feet of the center of the well pad which is used to atte animals; and (6) The operator of any natural gas storage field within which the firmore than three tenants in common or other co-owners of interests described in mads, the applicant may serve the documents required upon the person described in the quant to section eight, article one, chapter eleven-a of this code. (2) Notwithstanding any ten holder is not notice to a landowner, unless the lien holder is the landowner, W. Va. ator shall also provide the Well Site Safety Plan ("WSSP") to the surface owner and any and water testing as provided in section 15 of this rule.
Ø A	Application Notice	☐ WSSP Notice ☐ E&	S Plan Notice  Well Plat Notice is hereby provided to:
Nan Add	URFACE OWNER( ne: Fredrick & Cathy Jo H lress: 100 Fernwood Dr burg, WV 26070		☑ COAL OWNER OR LESSEE Name: Address:
_	ne: William Hervey III	/	COAL OPERATOR
	ress: 1030 Washington		Name:
	burg, WV 26070		Address: Received
ПSI	URFACE OWNER	(s) (Road and/or Other Dis	SURFACE OWNER OF WATER WELL Gas
		(-) (	SURFACE OWNER OF WATER WELL Gas
	ress:		AND/OR WATER PURVEYOR(s)  Name: Michael Whitco & Patricia Graham  NOV 0 5 2015
Nan	ne:		Address: 105 Churchman Lane
Add	lress:		Wellsburg, WV 26070
			☐ OPERATOR OF ANY NATURAL GAS STORAGE FIELD
Nan	ne;	(s) (Impoundments or Pits	Address:
Add	Iress:		*Please attach additional forms if necessary

OPERATOR WELL NO. Russell Hervey BRK 210H

Well Pad Name: Russell Hervey BRK Pad

#### Notice is hereby given:

Pursuant to West Virginia Code § 22-6A-10(b), notice is hereby given that the undersigned well operator has applied for a permit for well work or for a certificate of approval for the construction of an impoundment or pit.

#### This Notice Shall Include:

Pursuant to W. Va. Code § 22-6A-10(b), this notice shall include: (1) copies of the application; (2) the erosion and sediment control plan required by section seven of this article; and (3) the well plat.

Pursuant to W. Va. Code § 22-6A-10(f), this notice shall include: (1) a statement of the time limits for filing written comments; (2) who may file written comments; (3) the name and address of the secretary for the purpose of filing the comments and obtaining additional information; and (4) a statement that the persons may request, at the time of submitting written comments, notice of the permit decision and a list of persons qualified to test water.

Pursuant to W. Va. Code R. § 35-8-5.7.a, the operator shall provide the Well Site Safety Plan to the surface owner and any water purveyor or surface owner subject to notice and water testing as provided in section 15 of this rule.

Pursuant to W. Va. Code R. § 35-8-15.2.c, this notice shall: (1) contain a statement of the surface owner's and water purveyor's right to request sampling and analysis; (2) advise the surface owner and water purveyor of the rebuttable presumption for contamination or deprivation of a fresh water source or supply; advise the surface owner and water purveyor that refusal to allow the operator to conduct a pre-drilling water well test constitutes a method to rebut the presumption of liability; (3) advise the surface owner and water purveyor of his or her independent right to sample and analyze any water supply at his or her own expense; advise the surface owner and water purveyor whether or not the operator will utilize an independent laboratory to analyze any sample; and (4) advise the surface owner and or water purveyor that he or she can obtain from the Chief a list of water testing laboratories in the subject area capable of and qualified to test water supplies in accordance with standard acceptable methods.

Additional information related to horizontal drilling may be obtained from the Secretary, at the WV Department of Environmental Protection headquarters, located at 601 57th Street, SE, Charleston, WV 25304 (304-926-0450) or by visiting www.dep.wv.gov/oiland-gas/pages/default.aspx.

Well Location Restrictions

Pursuant to W. Va. Code § 22-6A-12, Wells may not be drilled within two hundred fifty feet measured horizontally from any existing water well or developed spring used for human or domestic animal consumption. The center of well pads may not be located within six hundred twenty-five feet of an occupied dwelling structure, or a building two thousand five hundred square feet or larger used to house or shelter dairy cattle or poultry husbandry. This limitation is applicable to those wells, developed springs, dwellings or agricultural buildings that existed on the date a notice to the surface owner of planned entry for surveying or staking as provided in section ten of this article or a notice of intent to drill a horizontal well as provided in subsection (b), section sixteen of this article was provided, whichever occurs first, and to any dwelling under construction prior to that date. This limitation may be waived by written consent of the surface owner transmitted to the department and recorded in the real property records maintained by the clerk of the county commission for the county in which such property is located. Furthermore, the well operator may be granted a variance by the secretary from these distance restrictions upon submission of a plan which identifies the sufficient measures, facilities or practices to be employed during well site construction, drilling and operations. The variance, if granted, shall include terms and conditions the department requires to ensure the safety and protection of affected persons and property. The terms and conditions may include insurance, bonding and indemnification, as well as technical requirements. (b) No well pad may be prepared or well drilled within one hundred feet measured horizontally from any perennial stream, natural or artificial lake, pond or reservoir, or a wetland, or within three hundred feet of a naturally reproducing trout stream. No well pad may be located within one thousand feet of a surface or ground water intake of a public water supply. The distance from the public water supply as identified by the department shall be measured as follows: (1) For a surface water intake on a lake or reservoir, the distance shall be measured from the boundary of the lake or reservoir. (2) For a surface water intake on a flowing stream, the distance shall be measured from a semicircular radius extending upstream of the surface water intake. (3) For a groundwater source, the distance shall be measured from the wellhead or spring. The department may, in its discretion, waive these distance restrictions upon submission of a plan identifying sufficient measures, facilities or practices to be employed during well site construction, drilling and operations to protect the waters of the state. A waiver, if granted, shall impose any permit conditions as the secretary considers necessary. (c) Notwithstanding the foregoing provisions of this section, nothing contained in this section prevents an operator from conducting the activities permitted or authorized by a Clean Walk 2015 section 404 permit or other approval from the United States Army Corps of Engineers within any waters of the state or within the restricted areas referenced in this section. (d) The well location restrictions set forth in this section shall not apply to any well on a multiple well part if at least one of the wells was permitted prior to the effective date of this article. (e) The secretary shall, by December 31, 2012, report to the Legislature on the noise, light, dust and volatile organic compounds generated by the drilling of horizontal wells as they relate to the well location restrictions regarding occupied dwelling structures pursuant to this section. Upon a finding, if any, by the secretary that the well location restrictions regarding occupied dwelling structures are inadequate or otherwise require alteration to address the items

API NO. 47-09

OPERATOR WELL NO. Russell Hervey BRK 210H

Well Pad Name: Russell Hervey BRK Pad

examined in the study required by this subsection, the secretary shall have the authority to propose for promulgation legislative rules establishing guidelines and procedures regarding reasonable levels of noise, light, dust and volatile organic compounds relating to drilling horizontal wells, including reasonable means of mitigating such factors, if necessary.

### Water Well Testing:

Pursuant to West Virginia Code § 22-6A-10(d), notification shall be made, with respect to surface landowners identified in subsection (b) or water purveyors identified in subdivision (5), subsection (b) of this section, of the opportunity for testing their water well. The operator shall provide an analysis to such surface landowner or water purveyor at their request.

#### Water Testing Laboratories:

Pursuant to West Virginia Code § 22-6A-10(i), persons entitled to notice pursuant to subsection (b) of this section may contact the department to ascertain the names and locations of water testing laboratories in the subject area capable and qualified to test water supplies in accordance with standard accepted methods. In compiling that list of names the department shall consult with the state Bureau for Public Health and local health departments. A surface owner and water purveyor has an independent right to sample and analyze any water supply at his or her own expense. The laboratory utilized by the operator shall be approved by the agency as being certified and capable of performing sample analyses in accordance with this section.

### Rebuttable Presumption for Contamination or Deprivation of a Fresh Water Source or Supply:

W. Va. Code § 22-6A-18 requires that (b) unless rebutted by one of the defenses established in subsection (c) of this section, in any action for contamination or deprivation of a fresh water source or supply within one thousand five hundred feet of the center of the well pad for horizontal well, there is a rebuttable presumption that the drilling and the oil or gas well or either was the proximate cause of the contamination or deprivation of the fresh water source or supply. (c) In order to rebut the presumption of liability established in subsection (b) of this section, the operator must prove by a preponderance of the evidence one of the following defenses: (1) The pollution existed prior to the drilling or alteration activity as determined by a predrilling or prealteration water well test. (2) The landowner or water purveyor refused to allow the operator access to the property to conduct a predrilling or prealteration water well test. (3) The water supply is not within one thousand five hundred feet of the well. (4) The pollution occurred more than six months after completion of drilling or alteration activities. (5) The pollution occurred as the result of some cause other than the drilling or alteration activity. (d) Any operator electing to preserve its defenses under subdivision (1), subsection (c) of this section shall retain the services of an independent certified laboratory to conduct the predrilling or prealteration water well test. A copy of the results of the test shall be submitted to the department and the surface owner or water purveyor in a manner prescribed by the secretary. (e) Any operator shall replace the water supply of an owner of interest in real property who obtains all or part of that owner's supply of water for domestic, agricultural, industrial or other legitimate use from an underground or surface source with a comparable water supply where the secretary determines that the water supply has been affected by contamination, diminution or interruption proximately caused by the oil or gas operation, unless waived in writing by that owner. (f) The secretary may order the operator conducting the oil or gas operation to: (1) Provide an emergency drinking water supply within twenty-four hours; (2) Provide temporary water supply within seventy-two hours; (3) Within thirty days begin activities to establish a permanent water supply or submit a proposal to the secretary outlining the measures and timetables to be used in establishing a permanent supply. The total time in providing a permanent water supply may not exceed two years. If the operator demonstrates that providing a permanent replacement water supply cannot be completed within two years, the secretary may extend the time frame on case-by-case basis; and (4) Pay all reasonable costs incurred by the real property owner in securing a water supply. (g) A person as described in subsection (b) of this section aggricord under the provisions of subsections (b), (e) or (f) of this section may seek relief in court... (i) Notwithstanding the denial of the operator of responsibility for the damage to the real property owner's water supply or the status of any appeal on determination of liability for the damage to the real property owner's water supply, the operator may not discontinue providing the required water service until authorized to do so by the secretary or a court of competent jurisdiction.

#### Written Comment:

Pursuant to West Virginia Code § 22-6A-11(a), all persons described in subsection (b), section ten of this article may file written comments with the secretary as to the location or construction of the applicant's proposed well work within thirty days after the application is filed with the secretary. All persons described in West Virginia Code § 22-6A-10(b) may file written comments as to the location or construction of the applicant's proposed well work to the Secretary at:

Chief, Office of Oil and Gas
Department of Environmental Protection
601 57<sup>th</sup> St. SE
Charleston, WV 25304
(304) 926-0450

Office of Oil & Chare

Such persons may request, at the time of submitting written comments, notice of the permit decision and a list of persons qualified to test water. NOTE: YOU ARE NOT REQUIRED TO FILE ANY COMMENT.

WW-6A (8-13) API NO. 47- 09 OPERATOR WELL NO. RUSSEll Hervey BRK 210H
Well Pad Name: Russell Hervey BRK Pad

### Time Limits and Methods for Filing Comments.

The law requires these materials to be served on or before the date the operator files its Application. You have **THIRTY (30) DAYS** after the filing date to file your comments. Comments must be filed in person or received in the mail by the Chief's office by the time stated above. You may call the Chief's office to be sure of the date. Check with your postmaster to ensure adequate delivery time or to arrange special expedited handling. If you have been contacted by the well operator and you have signed a "voluntary statement of no objection" to the planned work described in these materials, then the permit may be issued at any time.

Pursuant to West Virginia Code § 22-6A-11(c)(2), Any objections of the affected coal operators and coal seam owners and lessees shall be addressed through the processes and procedures that exist under sections fifteen, seventeen and forty, article six of this chapter, as applicable and as incorporated into this article by section five of this article. The written comments filed by the parties entitled to notice under subdivisions (1), (2), (4), (5) and (6), subsection (b), section ten of this article shall be considered by the secretary in the permit issuance process, but the parties are not entitled to participate in the processes and proceedings that exist under sections fifteen, seventeen or forty, article six of this chapter, as applicable and as incorporated into this article by section five of this article.

### **Comment Requirements**

Your comments must be in writing and include your name, address and telephone number, the well operator's name and well number and the approximate location of the proposed well site including district and county from the application. You may add other documents, such as sketches, maps or photographs to support your comments.

Disclaimer: All comments received will be placed on our web site <a href="http://www.dep.wv.gov/oil-and-gas/Horizontal-Permits/Pages/default.aspx">http://www.dep.wv.gov/oil-and-gas/Horizontal-Permits/Pages/default.aspx</a> and the applicant will automatically be forwarded an email notice that such comments have been submitted. The applicant will be expected to provide a response to comments submitted by any surface owner, water purveyor or natural gas storage operator noticed within the application.

### **Permit Denial or Condition**

The Chief has the power to deny or condition a well work permit. Pursuant to West Virginia Code § 22-6A-8(d), the permit may not be issued or be conditioned, including conditions with respect to the location of the well and access roads prior to issuance if the director determines that:

- (1) The proposed well work will constitute a hazard to the safety of persons;
- (2) The plan for soil erosion and sediment control is not adequate or effective;
- (3) Damage would occur to publicly owned lands or resources; or
- (4) The proposed well work fails to protect fresh water sources or supplies.

A permit may also be denied under West Virginia Code § 22-6A-7(k), the secretary shall deny the issuance of a permit if the secretary determines that the applicant has committed a substantial violation of a previously issued permit for a horizontal well, including the applicable erosion and sediment control plan associated with the previously issued permit, or a substantial violation of one or more of the rules promulgated under this article, and in each instance has failed to abate or seek review of the violation within the time prescribed by the secretary pursuant to the provisions of subdivisions (1) and (2), subsection (a), section five of this article and the rules promulgated hereunder, which time may not be unreasonable.

Pursuant to West Virginia Code § 22-6A-10(g), any person entitled to submit written comments to the secretary pursuant to subsection (a), section eleven of this article, shall also be entitled to receive from the secretary a copy of the permit as issued or a copy of the order modifying or denying the permit if the person requests receipt of them as a part of the written comments submitted concerning the permit application. Such persons may request, at the time of submitting written comments, notice of the permit decision and a list of persons qualified to test water.

4700900172

Received Office of Oil & Gas

NOV 05 2015

API NO. 47-09 OPERATOR WELL NO. Russell Hervey BRK 210H
Well Pad Name: Russell Hervey BRK Pad

Notice is hereby given by:

Well Operator: SWN Production Co., LLC

Telephone: 304-884-1610 Email: Dee\_Southall@swn.com Address: P.O. Box 1300

Jane Lew, WV 26378

Facsimile: 304-471-2497

### Oil and Gas Privacy Notice:

The Office of Oil and Gas processes your personal information, such as name, address and telephone number, as part of our regulatory duties. Your personal information may be disclosed to other State agencies or third parties in the normal course of business or as needed to comply with statutory or regulatory requirements, including Freedom of Information Act requests. Our office will appropriately secure your personal information. If you have any questions about our use or your personal information, please contact DEP's Chief Privacy Officer at depprivacyofficer@wv.gov.

OFFICIAL SEAL

Notary Public, State of West Virginia

BRITTANY R WOODY

3302 Old Elkins Road

Buckhannon, WV 26201

My commission expires November 27, 2022

Subscribed and sworn before me this

day of U CHOUN 20

Notary Public

My Commission Expires

4700900172

Received Office of Oil & Gas NOV 0 5 2015

## STATE OF WEST VIRGINIA DEPARTMENT OF ENVIRONMENTAL PROTECTION, OFFICE OF OIL AND GAS NOTICE OF INTENT TO DRILL

Pursuant to W. Va. Code § 22-6A-16(b), the Notice of Intent to Drill is only required if the notice requirements of W. Va. Code § 22-6A-10(a) have NOT been met or if the Notice of Intent to Drill requirement has NOT been waived in writing by the surface owner.

Date of Notic	Requirement: Notice shall be provided at le ce: 10/21/2015 Date Permi	t Application Filed:	Serial application.
Delivery met	hod pursuant to West Virginia Code § 22-	6A-16(b)	
☐ HAND	■ CERTIFIED MAIL		
		PETED	
DELIVE	RETURN RECEIPT REQUI	ESTED	
receipt request drilling a hore of this subsect subsection ma	V. Va. Code § 22-6A-16(b), at least ten days parted or hand delivery, give the surface owner izontal well: <i>Provided</i> , That notice given pution as of the date the notice was provided to as be waived in writing by the surface owners le, facsimile number and electronic mail address.	notice of its intent to enter upon the rsuant to subsection (a), section ter the surface owner: <i>Provided, howe.</i> The notice, if required, shall inclu	e surface owner's land for the purpose of n of this article satisfies the requirements ever, That the notice requirements of this ide the name, address, telephone number,
	reby provided to the SURFACE OWN	ER(s):	
Name: Russell I		Name:	
Address: 200		Address:	
Wellsburg, WV 2	5070		
State:	West Virginia	1 1 1 M N A D 92	537,707.098
County: District: Quadrangle: Watershed:	Buffalo Steubenville East Buffalo Creek		4,456,496.949 Pierce Run Rd
District: Quadrangle: Watershed:  This Notice Pursuant to V facsimile nur related to hor	Buffalo Steubenville East	Public Road Access: Generally used farm name:  tice shall include the name, addrestrator and the operator's authorized ecretary, at the WV Department of	ess, telephone number, and if available, d representative. Additional information Environmental Protection headquarters,
District: Quadrangle: Watershed:  This Notice Pursuant to V facsimile nur related to hor located at 601	Steubenville East Buffalo Creek  Shall Include: West Virginia Code § 22-6A-16(b), this non other and electronic mail address of the openizontal drilling may be obtained from the Section 1.	Public Road Access: Generally used farm name:  tice shall include the name, addrestrator and the operator's authorized ecretary, at the WV Department of	ess, telephone number, and if available, d representative. Additional information Environmental Protection headquarters,
District: Quadrangle: Watershed: This Notice Pursuant to V facsimile nur related to hor located at 601 Notice is he	Steubenville East  Buffalo Creek  Shall Include: West Virginia Code § 22-6A-16(b), this non other and electronic mail address of the openizontal drilling may be obtained from the Science Street, SE, Charleston, WV 25304 (304)	Public Road Access: Generally used farm name:  tice shall include the name, addrestrator and the operator's authorized ecretary, at the WV Department of	ess, telephone number, and if available, d representative. Additional information Environmental Protection headquarters,
District: Quadrangle: Watershed:  This Notice Pursuant to V facsimile nur related to hor located at 601  Notice is he Well Operato	Buffalo Steubenville East Buffalo Creek  Shall Include: West Virginia Code § 22-6A-16(b), this no obser and electronic mail address of the openizontal drilling may be obtained from the Science Street, SE, Charleston, WV 25304 (304) reby given by:	Public Road Access: Generally used farm name:  tice shall include the name, addrestrator and the operator's authorized ecretary, at the WV Department of 4-926-0450) or by visiting www.der	ess, telephone number, and if available, d representative. Additional information Environmental Protection headquarters, p.wv.gov/oil-and-gas/pages/default.aspx.
District: Quadrangle: Watershed: This Notice Pursuant to V facsimile nur related to hor located at 601 Notice is he	Buffalo Steubenville East Buffalo Creek  Shall Include: West Virginia Code § 22-6A-16(b), this no obser and electronic mail address of the operizontal drilling may be obtained from the Science of State of Street, SE, Charleston, WV 25304 (304)  reby given by: r: SWN Production Company, LLC	Public Road Access: Generally used farm name:  tice shall include the name, addresterator and the operator's authorized ecretary, at the WV Department of 1-926-0450) or by visiting www.deg	ess, telephone number, and if available, d representative. Additional information Environmental Protection headquarters, p.wv.gov/oil-and-gas/pages/default.aspx.  Danielle Southall
District: Quadrangle: Watershed:  This Notice Pursuant to V facsimile nur related to hor located at 601  Notice is he Well Operato	Buffalo Steubenville East Buffalo Creek  Shall Include: West Virginia Code § 22-6A-16(b), this non other and electronic mail address of the openizontal drilling may be obtained from the Science of Street, SE, Charleston, WV 25304 (304)  reby given by:  T: SWN Production Company, LLC PO Box 1300, 179 Innovation Drive	Public Road Access: Generally used farm name:  tice shall include the name, addresterator and the operator's authorized ecretary, at the WV Department of 1-926-0450) or by visiting www.deg	ess, telephone number, and if available, d representative. Additional information Environmental Protection headquarters, p.wv.gov/oil-and-gas/pages/default.aspx.  Danielle Southall PO Box 1300, 179 Innovation Drive
District: Quadrangle: Watershed: This Notice Pursuant to V facsimile nur related to hor located at 601 Notice is he Well Operato Address:	Buffalo Steubenville East Buffalo Creek  Shall Include: West Virginia Code § 22-6A-16(b), this no observant delectronic mail address of the openizontal drilling may be obtained from the Science Street, SE, Charleston, WV 25304 (304)  reby given by:  T: SWN Production Company, LLC PO Box 1300, 179 Innovation Drive Jane Lew, WV 26378	Public Road Access: Generally used farm name:  tice shall include the name, addreserator and the operator's authorized ecretary, at the WV Department of 4-926-0450) or by visiting www.der  Authorized Representative: Address:	ess, telephone number, and if available, despresentative. Additional information Environmental Protection headquarters, b.wv.gov/oil-and-gas/pages/default.aspx.  Danielle Southall PO Box 1300, 179 Innovation Drive Jane Lew, WV 26378

#### Oil and Gas Privacy Notice:

The Office of Oil and Gas processes your personal information, such as name, address and telephone number, as part of our regulatory duties. Your personal information may be disclosed to other State agencies or third parties in the normal course of business or as needed to comply with statutory or regulatory requirements, including Freedom of Information Act requests. Our office will appropriately secure your personal information. If you have any questions about our use or your personal information, please contact DEP's Chief Privacy Officer at <a href="mailto:deprivacyofficer@wv.gov">deprivacyofficer@wv.gov</a>.

NOV 05 2015

# STATE OF WEST VIRGINIA DEPARTMENT OF ENVIRONMENTAL PROTECTION, OFFICE OF OIL AND GAS NOTICE OF PLANNED OPERATION

D. II		G. L. P. 22 (1. 1773)		
Delivery	method pursuant to West Virginia	Code § 22-6A-16(c)		
E CE	RTIFIED MAIL	☐ HAND		
	TURN RECEIPT REQUESTED	DELIVERY		
Durguent	to W. Vo. Codo § 22.64 16(a) no	later than the data for filing th	a narmit annlia	ation, an operator shall, by certified mail
return rec the plann required t drilling o damages (d) The no of notice.	eipt requested or hand delivery, give ed operation. The notice required I o be provided by subsection (b), sect f a horizontal well; and (3) A propo to the surface affected by oil and gas otices required by this section shall be	the surface owner whose land by this subsection shall includ- tion ten of this article to a surfa- osed surface use and compensa- operations to the extent the da- be given to the surface owner a	will be used for le: (1) A copy of acc owner whose ation agreement mages are composi-	the drilling of a horizontal well notice of this code section; (2) The information land will be used in conjunction with the containing an offer of compensation for ensable under article six-b of this chapter, ed in the records of the sheriff at the time
	hereby provided to the SURFACE dress listed in the records of the sheri			
	ssell D & Lisa K Hervey	√ Name:		6 >
Name: Ru	ssell D & Lisa K Helvey			
	200 Carol Rd	Address	:	0
Address: Wellsburg, V Notice is Pursuant	200 Carol Rd W 26070 hereby given:	Address ), notice is hereby given that th	e undersigned w	ell operator has developed a planned t of land as follows:
Address: Wellsburg, V Notice is Pursuant operation State: County: District:	200 Carol Rd WV 26070  hereby given: to West Virginia Code § 22-6A-16(c on the surface owner's land for the West Virginia Brooke Buffalo	Address ), notice is hereby given that th purpose of drilling a horizontal  UTM NAD 8: Public Road A	e undersigned w well on the trac Easting; Northing:	ell operator has developed a planned
Address: Wellsburg, V Notice is Pursuant operation State: County: District: Quadrang	200 Carol Rd WV 26070  hereby given: to West Virginia Code § 22-6A-16(c on the surface owner's land for the West Virginia Brooke Buffalo Steubenville East	Address ), notice is hereby given that th purpose of drilling a horizontal  UTM NAD 8:	e undersigned w well on the trac Easting; Northing:	ell operator has developed a planned t of land as follows: 537,707.098 4,456,496.949
Address: Wellsburg, V  Notice is Pursuant operation State: County: District: Quadrang Watershe	200 Carol Rd WV 26070  hereby given: to West Virginia Code § 22-6A-16(c on the surface owner's land for the West Virginia Brooke Buffalo Steubenville East d: Buffalo Creek	Address ), notice is hereby given that th purpose of drilling a horizontal  UTM NAD 8: Public Road A	e undersigned w well on the trac Easting; Northing:	ell operator has developed a planned t of land as follows: 537,707.098 4,456,496.949
Notice is Pursuant operation State: County: District: Quadrang Watershe  This Notice Pursuant to be prohorizontal surface at informatic headquart	hereby given: to West Virginia Code § 22-6A-16(c) on the surface owner's land for the West Virginia  Brooke Buffalo  Steubenville East d: Steubenville East d: Buffalo Creek  ice Shall Include: to West Virginia Code § 22-6A-16(c) vided by W. Va. Code § 22-6A-10(c) I well; and (3) A proposed surface useffected by oil and gas operations to on related to horizontal drilling may	Address  ), notice is hereby given that the purpose of drilling a horizontal UTM NAD 8.  Public Road A Generally use  c), this notice shall include: (1)  (b) to a surface owner whose see and compensation agreement the extent the damages are concept be obtained from the Secretary	e undersigned w l well on the trac Basting: Northing: Access: d farm name:  A copy of this colland will be used to containing an empensable understy, at the WV	ell operator has developed a planned t of land as follows: 537,707.098 4,456,496.949
Address: Wellsburg, V Notice is Pursuant operation State: County: District: Quadrang Watershe This Notice Pursuant to be prohorizonta surface at informatic headquart	hereby given:  to West Virginia Code § 22-6A-16(con the surface owner's land for the West Virginia  Brooke Buffalo Steubenville East d: Buffalo Creek  ice Shall Include: to West Virginia Code § 22-6A-16(covided by W. Va. Code § 22-6A-10(lowed by W. Va. C	Address  ), notice is hereby given that the purpose of drilling a horizontal UTM NAD 8.  Public Road A Generally use  c), this notice shall include: (1)  (b) to a surface owner whose see and compensation agreement the extent the damages are concept be obtained from the Secretary	e undersigned w l well on the trac Basting: Northing: Access: d farm name:  A copy of this colland will be used to containing an empensable understy, at the WV	ell operator has developed a planned t of land as follows:  537,707.098  4,456,496.949  Pierce Run Rd  ode section; (2) The information required sed in conjunction with the drilling of a offer of compensation for damages to their article six-b of this chapter. Additional Department of Environmental Protection or by visiting <a href="https://www.dep.wv.gov/oil-and-output land-output land-&lt;/td&gt;&lt;/tr&gt;&lt;tr&gt;&lt;td&gt;Address: Wellsburg, V Notice is Pursuant operation State: County: District: Quadrang Watershe This Noti Pursuant to be pro horizonta surface at informatic headquart gas/pages&lt;/td&gt;&lt;td&gt;hereby given:  to West Virginia Code § 22-6A-16(con the surface owner's land for the West Virginia  Brooke Buffalo Steubenville East d: Steubenville East d: Buffalo Creek  ice Shall Include: to West Virginia Code § 22-6A-16(covided by W. Va. Code § 22-6A-10(lovided by W. Va. Co&lt;/td&gt;&lt;td&gt;Address  ), notice is hereby given that the purpose of drilling a horizontal UTM NAD 8:  Public Road A Generally use  (b), this notice shall include: (1)  (b) to a surface owner whose see and compensation agreement the extent the damages are contained from the Secretary Charleston, WV 25304 (1)&lt;/td&gt;&lt;td&gt;e undersigned w l well on the trace 3 Easting: Northing: Access: d farm name:  A copy of this colland will be used too take to the containing and the man arry, at the WV 1304-926-0450) of the containing and the trace to the tr&lt;/td&gt;&lt;td&gt;ell operator has developed a planned t of land as follows:  537,707.098  4,456,496.949  Pierce Run Rd  ode section; (2) The information required sed in conjunction with the drilling of a offer of compensation for damages to their article six-b of this chapter. Additional Department of Environmental Protection or by visiting &lt;a href=" https:="" land-<="" land-output="" oil-and-output="" td="" www.dep.wv.gov=""></a>

duties. Your personal information may be disclosed to other State agencies or third parties in the normal course of business or as needed to comply with statutory or regulatory requirements, including Freedom of Information Act requests. Our office will appropriately secure your personal information. If you have any questions about our use or your personal information.

DEP's Chief Privacy Officer at depprivacyofficer@wv.gov.

NOV 05 2015

Office of Oil & Gas



### WEST VIRGINIA DEPARTMENT OF TRANSPORTATION

**Division of Highways** 

1900 Kanawha Boulevard East • Building Five • Room 110 Charleston, West Virginia 25305-0430 • (304) 558-3505

Paul A. Mattox, Jr., P. E. Secretary of Transportation/ Commissioner of Highways

Earl Ray Tomblin Governor

October 21, 2015

4700900172

James A. Martin, Chief Office of Oil and Gas Department of Environmental Protection 601 57<sup>th</sup> Street, SE Charleston, WV 25304

Subject: DOH Permit for the Russell Hervey Pad, Brooke County

Russell Hervey BRK 210H

Dear Mr. Martin,

The West Virginia Division of Highways has transferred Permit #06-2012-0308 for the subject site to Southwestern Energy for access to the State Road for the well site located off of Brooke County Route 27/4 SLS.

The operator has signed an OIL AND GAS ROAD MAINTENANCE BONDING AGREEMENT and provided the required Bond. This operator is currently in compliance with the DOH OIL AND GAS POLICY dated January 3, 2012.

Very Truly Yours,

Gary K. Clayton, P.E. Regional Maintenance Engineer

Central Office Oil & Gas Coordinatived

Office of Oil & Gas

NOV 05 2015

Cc: Dee Southhall

Southwestern Energy

CH, OM, D-6

File

Supplier Name	Product Name	Product Use	Chemical Name	CAS Number
			Ethanol	000064-17-5
NALCO ONESOURCE	EC6110A	Biocide	Glutaraldehyde (Pentanediol)	000111-30-8
			Quaternary Ammonium Compounds	N/A-063
	EC6629A	Biocide	No Hazardous Components	NONE
	WBK-133 OXIDIZER	Breaker	Ammonium Persulfate	007727-54-0
	WBK-134	Breaker	Ammonium Persulfate	007727-54-0
			Crystalline Silica (Quartz Sand, Silicon Dioxide)	014808-60-7
	WCS-631LC	â. a. la	Proprietary Non Hazardous Salt	N/A-229
		Clay Stabilizer	Water	007732-18-5
	WFR-55LA	Friction Reducer	No Hazardous Components	NONE
	WGA-15L	Gel	Petroleum Distillate Hydrotreated Light	064742-47-8
WEATHERFORD	7. 41		Potassium Carbonate	000584-08-7
	WPB-584-L	Buffer	Potassium Hydroxide	001310-58-3
	WXL-101LE	Corsslinker	No Hazardous Components	NONE
	WXL-101LM	Crosslinker	Petroleum Distillate Hydrotreated Light	064742-47-8
İ	WXL-105L	Crosslinker	Water	007732-18-5
			Ethylene Glycol	000107-21-1
			Boric Acid	010043-35-3
			Ethanolamine	000141-43-5
	B244 Green-Cide 25G	Biocide	Glutaraldehyde	111-30-8
SCHLUMBERGER	L071 Temporary Clay	Clay Stabilizer	Cholinium Chloride	67-48-1
	Stabilizer Breaker J218	Breaker	Diammonium Peroxidisulphate	7727-54-0
	EB-Clean* J475 Breaker		Diammonium Peroxidisulphate	7727-54-0
	Friction Reducer B315	Friction Reducer	Distillates (petroleum), Hydrotreated light Aliphatic Alcohol Glycol Ether	64742-47-8 Proprietary
			Ammonium Sulfate	7783-20-2

Received
Office of Oil & Gas
NOV 0 5 2015

Supplier Name	Product Name	Product Use	Chemical Name	CAS Number
SCHLUMBERGER	Water Gelling Agent J580	Gel	Carbohydrate Polymer	Proprietary
	Scale Inhibitor B317	Scale Inhibitor	Trisodium ortho phosphate Ethane-1, 2-diol	7601-54-9 107-21-1
	Borate Crosslinker J532	Crosslinker	Aliphatic polyol Sodium tetraborate decahydrate	Proprietary 1303 96-4
	Crosslinker J610		Aliphatic polyol Potassium hydroxide	Proprietary 1310 58-3

\$700900172

Received
Office of Oil & Gas
NOV 0 5 2015

Supplier Name	Product Name	Product Use	Chemical Name	CAS Number
	ALPHA 1427		Didecyl Dimethyl	007173-51-1
			Ammonium Chloride	000004 47 5
		Biocide	Ethanol	000064-17-5
			Glutaraldehyde	000111-30-8
			(Pentanediol)	
			Quaternary Ammonium	068424-85-1
			Compound	A MARKET
			Water	007732-18-5
	BF-7L	Buffer	Potassium Carbonate	000584-08-7
		Clay Stabilizer	Choline Chloride	000067-48-1
	ClayCare		Water	007732-18-5
BAKER HUGHES	Enzyme G-I	Breaker	No Hazardous Components	NONE
	ENZYME G-NE	Breaker	No Hazardous Components	NONE
	FRW-18	Friction Reducer	Petroleum Distillate Hydrotreated Light	064742-47-8
	GW-3LDF	Gel	Petroleum Distillate Blend	N/A-014
			Polysaccharide Blend	N/A-021
	SCALETROL 720	Scale Inhibitor	Diethylene Glycol	000111-46-6
			Ethylene Glycol	000107-21-1
	XLW-32	Crosslinker	Boric Acid	010043-35-3
			Methanol (Methyl Alcohol)	000067-56-
	APB01 (AMMONIUM PERSUFATE BREAKER)	Breaker	Ammonium Persulfate	007727-54-0
	B05 (LOW PH BUFFER)	Buffer	Acetic acid	000064-19-
	BXL03 Borate XL Delayed High Temp	Crosslinker	No Hazardous Components	NONE
FRAC TECH SERVICES	FRW-200	Friction Reducer	No Hazardous Components	NONE
3=	HVG01 (TURQUOISE-1 BULK)	Gelling Agent	Petroleum Distillate Hydrotreated Light	064742-47-
	KCLS-4	Clay Stabilizer	No Hazardous Components	NONE
	LTB-1	Breaker	Ammonium Persulfate	N/A

4700900172

Received
Office of Oil & Oas
NOV 0 5 2015

BROOKE COUNTY, WV HIGHWAY MAP



HIGHWAY MAP SCALE

SOUTHWESTERN ENERGY

ENTRANCE A **AS-BUILT PLANS FOR THE RUSSELL HERVEY BRK PAD "A"** 

**BUFFALO DISTRICT, BROOKE COUNTY, WV JULY 2015** 

WVDEP OOG **ACCEPTED AS-BUILT** 12 / 4 / 2015

AS-BUILT ACCESS ROAD BEGINNING NAD83 Latitude = N #0.264864°

NAD83 Latitude = W 80.568200° UTM 83-17 Northing = 14623476,598 ft. UTM 83-17 Easting = 1760874,300 ft.

- I PORTIONS OF THE ORIGINAL AS-BUILT SURVEY OF THIS SITE PROVIDED BY BOORD BENCHECK & ASSOCIATES, INC (BBA) TO CHESAPEAKE ENERGY IN JANUARY 2013 HAVE BEEN INCORPORATED INTO THESE PLANS. THE BHA AS-BUILT SURVEY WAS PROVIDED TO THRASHER BY SOUTHWESTERN ENERGY IN JUNE 2015 INCLUDING CONTOURS, PROPERTY LINES. ENVIRONMENTAL FEATURES, ROADS, BUILDINGS, TREE LINES, ETC.
- ENVIRONMENTAL FEATURES, ROADS, BELLDINGS, TREE LINES, ETC.
  EXISTING ROAD EDGES, WELL PAD EDGE, GAS PRODUCTION EQUIPMENT AND
  ABOVE GROUND PIPING, AND EROSION & SEDIMENT CONTROL FEATURES
  WERE VERIFIED AND AS-BUILT BY THRASHER JUNE 2015.

THE COORDINATE SYSTEM USED FOR THIS PROJECT IS UTM WITH NADB3 DATUM, ZONE 17, US FOOT; CENTRAL MERIDIAN SIDW.



SOUTHWESTERN ENERGY 179 Chesapeake Drive Jane Lew, WV 26378 (304) 884-1610

SHEET INDEX

DESCRIPTION TITLE SHEET EVACUATION ROUTE/PREVAILING WIND AS-BUILT OVERVIEW
AS-BUILT ACCESS ROAD PLAN
AS-BUILT WELL PAD PLAN
AS-BUILT WELL PAD PLAN
AS-BUILT ACCESS ROAD PROFILE

AS-BUILT ACCESS ROAD PROFILE AS-BUILT WELL PAD PROFILE RECLAMATION PLAN RECLAMATION GENERAL NOTES

RECEAMATION DETAILS.

RUSSELL HERVEY BRK PAD "A" WELLS

EXISTING WELL 5H: API# 47-009-00144 EXISTING WELL 8H: API# 47-009-00136





PROJECT LOCATION

VICINITY MAP SCALE



ONE CALL UTILITY SYSTEM CONTACT INFO



CONTRACTOR SHALL, MOTHLY THE ONE-CALL SYSTEM OF THE INTENDED ENCAVATION OR DEMOLITION NOT LESS THAN FOREY-SHEPT (48) HOURS, EXCLUDING SATURDAYS, SUNDAYS AND LEGIAL PEDERAL OR STATE HOLDAYS, NOR MORE THAN THE HOURS OF STATE HOLDAYS.

DESCRIPTION ADDRESSED AS-BUILT COMMENTS PER WYDEP OFFICE OF DIL & GAS: ADDED AS-BUILT ACCESS ROAD PROPILE, RECLAMATION FLAN, PE SEAL AND WELL & CELLAN INFORMATION. 12/03/15 1.4-15 JFW.

