


40°17'30"

**Latitude**

80°32'30"

**Longitude**

+-----+  
 |  
 | 203s  
 |-----+  
 | 207w  
 |

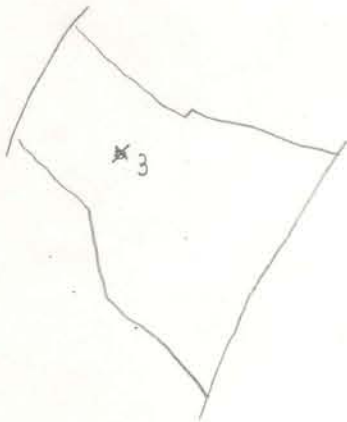

**Topo Location**

**7.5' Loc.** \_\_\_\_\_ **15' Loc.** \_\_\_\_\_  
 \_\_\_\_\_ (calc.) \_\_\_\_\_

**Company** Panther Run O+G Co

**Farm** J D Brady #3

**15' Quad** \_\_\_\_\_  
(sec.)

**7.5' Quad** Steubenville East

**District** Buffalo

**WELL LOCATION PLAT**

**County** 009 **Permit** 30006



Brook 6A

70020

J. D. BRADY NO. 3 WELL.

Not located.

X

Buffalo District, Brooke County, W. Va.  
Panther Run Oil & Gas Co.  
"Sucker-rod" Belt.

Drilled in May 22, 1907.

Production first 24 hrs. after shot, 40 bbls.

To top of cap, 1783'; total depth, 1795½'.

	Top.	Bottom.
Berea Sand	1783	1795½

~~70018~~

J.D. BRADY FARM

BROOKE COUNTY, W.VA.

70273  
now 70020

~~Well No.1. Commenced :-  
Completed : 2-9-1907~~

~~Top Berea Sand 1702  
Top Pay Sand 1706  
Total Depth 1815~~

~~Well No.2 Commenced:-  
Completed:- 4-1-1907~~

~~Top Berea Sand 1641  
Bottom 1656-10~~

Well No. 3. Commenced:-  
Completed:- 5-22-1907

Top Berea Sand 1783  
Top Pay 1787  
Bottom Pay 1792  
Total depth 1795 - 6

~~Well No.4. Commenced: -  
Completed:- 7-6-1907~~

~~Top Berea Sand 1884  
First Gas 1888  
Total depth 1898~~

~~Well No.5. Commenced: -  
Completed 9-29-1907~~

~~Top Berea Sand 1854  
Pay 1857  
Total Depth 1867~~