

40°17'30"

Latitude

+
|.71s
|1.83w

80°32'30"

Longitude

Topo Location

7.5' Loc. _____ 15' Loc. _____
_____ (calc.) _____

Company _____

Farm Ed. Jamison Hrs #1


15' Quad _____
(sec.)

7.5' Quad Stewbenville East

District Buffalo

WELL LOCATION PLAT

County 009 **Permit** 30008

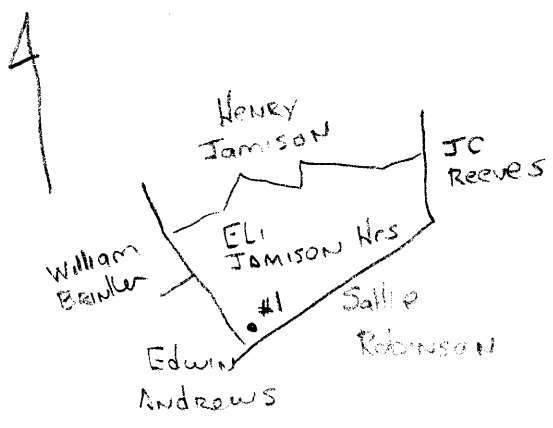

Brook 8-A