


40°17'30"

Latitude

80° 32' 30"

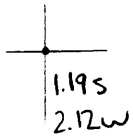

Longitude

Topo Location

7.5' Loc. _____ 15' Loc. _____
 _____ (calc.) _____

Company _____

Farm Wm Talbert #1


15' Quad _____
(sec.)

7.5' Quad Steubenville East

District Buffalo

WELL LOCATION PLAT

County 009 Permit 30010

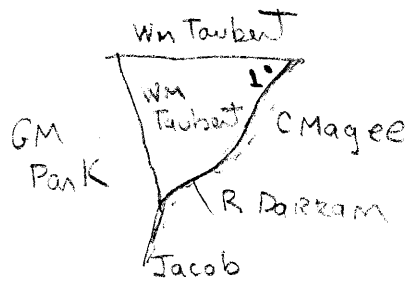

Brook 10-A