

40°20'00"

Latitude

80°35'00"

Longitude

2335
00w

Topo Location

7.5' Loc. _____ 15' Loc. _____
_____ (calc.) _____

Company Howard Taylor

Farm William Yoho #1

15' Quad _____
(sec.)

7.5' Quad Steinemille East

District Cross Creek


WELL LOCATION PLAT

County 009 **Permit** 30023

1 2 3

LATITUDE

LONGITUDE

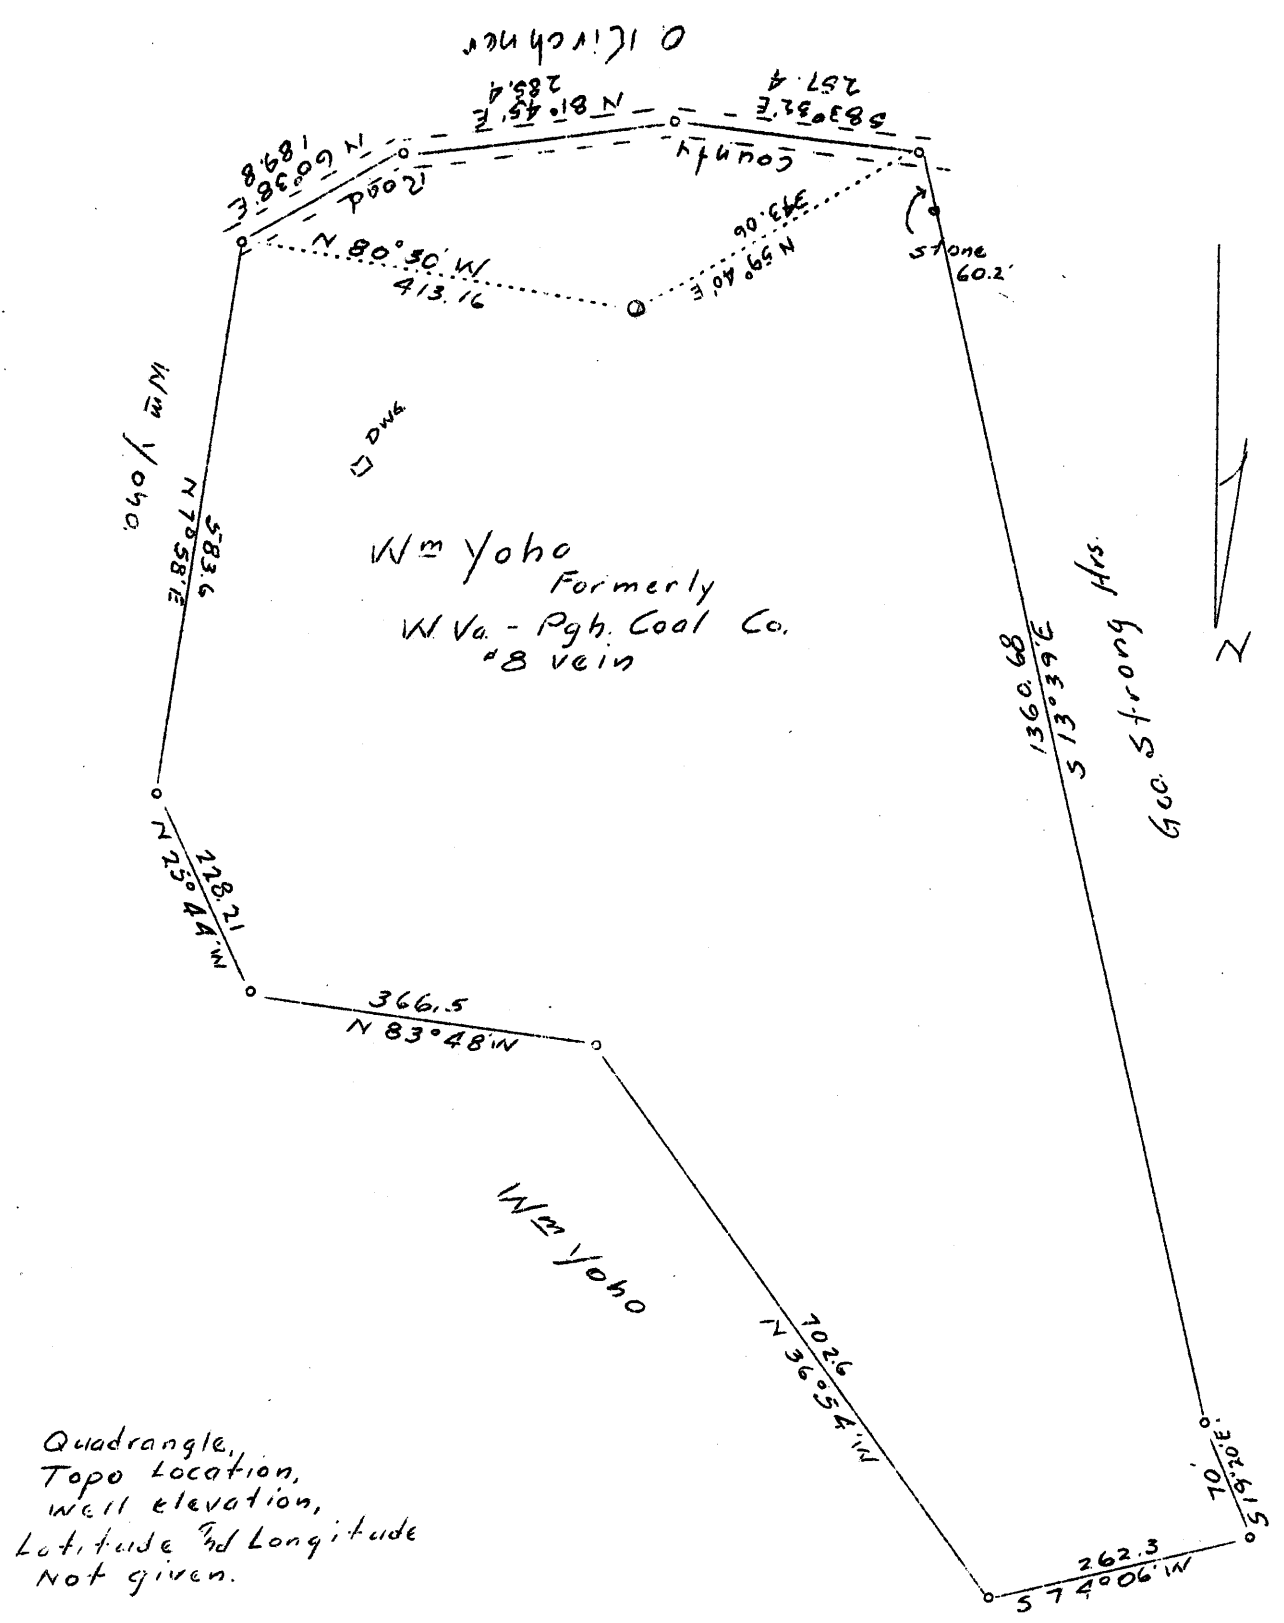

Company Howard C. Taylor

Address Wellsburg, W. Va.

Farm Wm. Yoho

Tract 26 1/2 Acres 26 1/2 Lease No. _____

Well (Farm) No. 1 Serial No. _____

Elevation (Spirit Level) _____

Quadrangle _____

County Brooke District Cross Cröck

Engineer J. D. Hahn

Engineer's Registration No. Applied

File No. _____ Drawing No. For

Date Nov. 25, 1936 Scale _____

STATE OF WEST VIRGINIA
Department of Mines
OIL AND GAS DIVISION
CHARLESTON

WELL LOCATION MAP

File No. BRO-234

+ Denotes location of well on U.S. Topographic Maps; scale 1 to 62,500 latitude and longitude lines being represented by border lines as shown

- Denotes one inch spaces on border line of original tracing.

Handwritten note: *Handwritten*