

New Location...
 Drill Deeper...
 Abandonment...

Company	<u>McKim Oil Co</u>
Address	<u>Hollidays Cove, W. Va.</u>
Farm	<u>Thomas McKim</u>
Tract	<u>Acres 41A-2R-22P</u> Lease No. _____
Wells (Farm) No.	<u>2-566</u> Serial No. _____
Elevation (Spirit Level)	<u>2-113</u>
Quadrangle	<u>Steubenville</u>
County	<u>Brooke</u> District <u>Cross Creek</u>
Engineer	<u>Walter W. Stegman</u>
Engineer's Registration No.	<u>394</u>
File No.	_____ Drawing No. _____
Date	<u>Aug 15, 1945</u> Scale <u>1 Inch = 300 Feet</u>

STATE OF WEST VIRGINIA
 DEPARTMENT OF MINES
 OIL AND GAS DIVISION
 CHARLESTON

WELL LOCATION MAP
 FILE NO. _____ #5

+ Denotes location of well on United States Topographic Maps, scale 1 to 62,500, latitude and longitude lines being represented by border lines as shown.
 - Denotes one inch spaces on border line of original tracing.

2.71 S
 0.60 W
 2.675
 0.60 W



STATE OF WEST VIRGINIA
DEPARTMENT OF MINES
OIL AND GAS DIVISION

42

WELL RECORD

Permit No. B20 48-A

Oil or Gas Well _____ (KIND)

Company <u>McKim Oil Company</u>	Casing and Tubing	Used in Drilling	Left in Well	Packers
Address <u>c/o A. G. Isiminger - Hollidays Cove, W. Va.</u>	Size			Kind of Packer
Farm <u>Thomas McKim</u> Acres _____	16			
Location (waters) _____	13			Size of _____
Well No. <u>2</u> Elev. _____	10			Depth set _____
District <u>Cross Creek</u> County <u>Brooke</u>	8 1/4		<u>962</u>	Perf. top _____
The surface of tract is owned in fee by _____	6 5/8			Perf. bottom _____
Address _____	5 3/16			Perf. top _____
Mineral rights are owned by <u>Hannie & Clara McKim</u>	3			Perf. bottom _____
Address _____	2			
Drilling commenced <u>1925</u>	Liners Used			
Drilling completed _____				
Date Shot _____ From _____ To _____				
With _____				
Open Flow _____ /10ths Water in _____ Inch				
_____ /10ths Merc. in _____ Inch				
Volume _____ Cu. Ft.				
Rock Pressure _____ lbs. _____ hrs.				
Oil _____ bbls., 1st 24 hrs.				
Fresh water _____ feet _____ feet				
Salt water _____ feet _____ feet				


CASING CEMENTED _____ SIZE _____ No. Ft. _____ Date _____

COAL WAS ENCOUNTERED AT 42 FEET _____ INCHES

_____ FEET _____ INCHES FEET _____ INCHES

_____ FEET _____ INCHES FEET _____ INCHES

Formation	Color	Hard or Soft	Top	Bottom	Oil, Gas or Water	Depth Found	Remarks
Berea Sand			1617	1633			
Coal			42				
This is all the record available							
RECORD REVISED FROM LOG OF WELL NO. 1863' of the Hope Natural Gas Company, Same District - Latitude 40 deg. 20' and longitude 80 deg. 35'.							
Coal			42	47			
Gas Sand			787	838			
Salt Sand			855	970			
Big Lime			970	1043			
Big Injun			1043	1273			
Water Sand			1526	1561			
Berea			1617	1633			

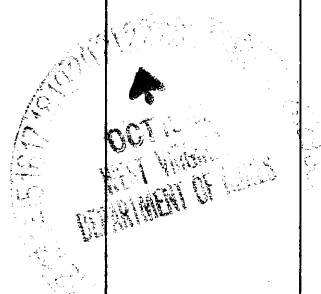

7M

THOMAS MCKIM NO. 2 WELL.

see plat 49A

Cross Creek District, Brooke County, W. Va.
 By McKim Oil Co., %A. G. Isiminger, Hollidays Cove, W. Va.
 Abandoned under permit Boo-48...-?
 On.....acres.
 Elevation.....' L.
 Minerals owned by Nannie and Clara McKim.
 Drilling commenced 1925.
 6⁵/₈" casing, 962'.
 Coal was encountered at 42'.
 Oil well. Log filed with Dept. of Mines Oct. 22, 1945.
 Record to RCT from Mrs. Griffith Nov. 6, 1945. Old File No. 42.

	Top.	Bottom.
Coal	42 -	..
Berea Sand	1617 -	1633

This is all the record available.

RECORD REVISED from log of well No. 1863 of
 the Hope Natural Gas Co., same district,
 Latitude 40° 20' and Longitude 80° 35':

Coal	42 -	47
Gas Sand	787 -	838
Salt Sand	855 -	970
Big Lime	970 -	1043
Big Injun Sand	1043 -	1273
Weir Sand	1526 -	1561
Berea Sand	1617 -	1633