

3.61 S
1.79 W

New Location
Drill Deeper
Abandonment X

Company J. D. OWENS
 Address BRILLIANT OHIO
 Farm HENRY L. HEINZEROTH
 Tract 1 Acres 145[±] Lease No. _____
 Well (Farm) No. 1 Serial No. _____
 Elevation (Spirit Level) 1147'
 Quadrangle WHEELING
 County BROOKE District BUFFALO
 Engineer WALTER W. STEGMAN
 Engineer's Registration No. 394
 File No. G.S. 6-1102 Drawing No. _____
 Date DEC. 15, 1946 Scale 1 inch = 500 Ft.


STATE OF WEST VIRGINIA
DEPARTMENT OF MINES
OIL AND GAS DIVISION
CHARLESTON

WELL LOCATION MAP
FILE NO. BRO-56-A

+ Denotes location of well on United States Topographic Maps, scale 1 to 62,500, latitude and longitude lines being represented by border lines as shown.
 - Denotes one inch spaces on border line of original tracing.

Latitude $40^{\circ} 15'$

Longitude $80^{\circ} 35'$

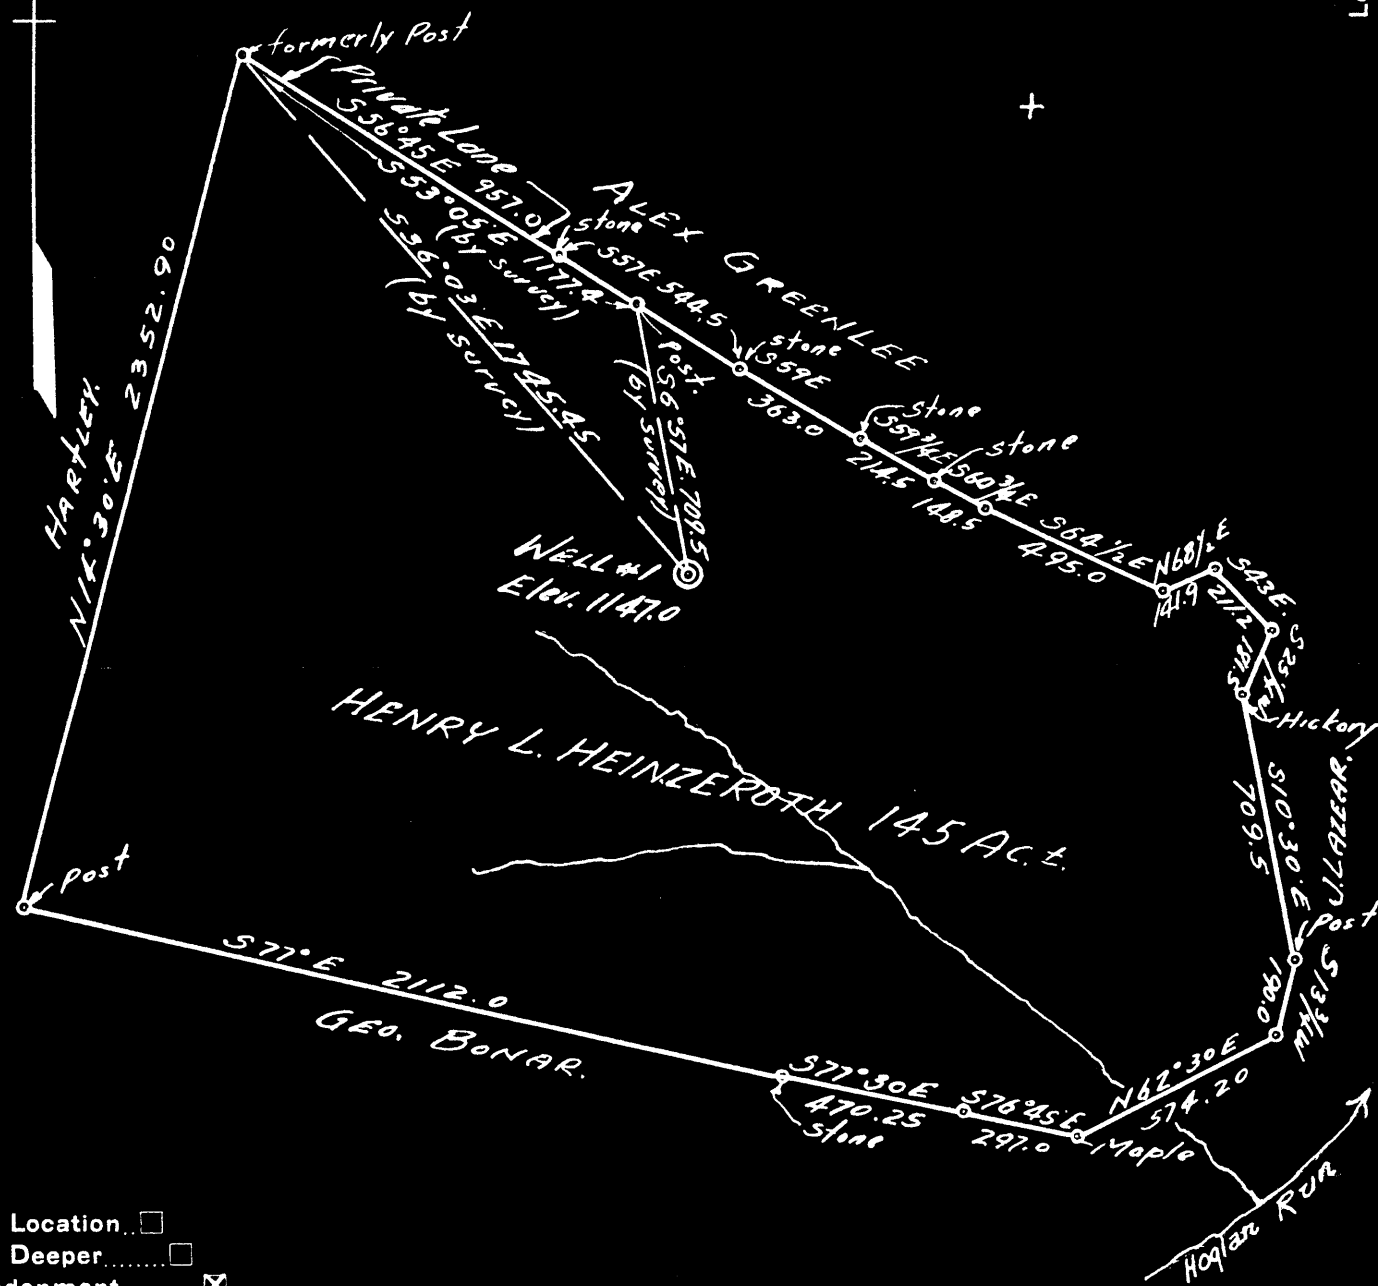

- New Location
- Drill Deeper
- Abandonment

Company J. D. OWENS.
 Address BRILLIANT OHIO.
 Farm HENRY L. HEINZEROTH
 Tract 1 Acres 145± Lease No. _____
 Well (Farm) No. 1 Serial No. _____
 Elevation (Spirit Level) 1147'
 Quadrangle WHEELING.
 County BROOKE District BUFFALO
 Engineer WALTER W. STEGMAN
 Engineer's Registration No. 394
 File No. G.S. 6-P102 Drawing No. _____
 Date DEC. 15, 1946 Scale 1 inch = 500 Ft.

STATE OF WEST VIRGINIA
 DEPARTMENT OF MINES
 OIL AND GAS DIVISION
 CHARLESTON

WELL LOCATION MAP
 FILE NO. BRO-56-A

+ Denotes location of well on United States Topographic Maps, scale 1 to 62,500, latitude and longitude lines being represented by border lines as shown.

- Denotes one inch spaces on border line of original tracing.