


Latitude

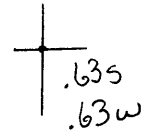

Longitude

**Topo Location**

**7.5' Loc.** \_\_\_\_\_ **15' Loc.** \_\_\_\_\_  
 \_\_\_\_\_ **(calc.)** \_\_\_\_\_

**Company** Arthur E. Kam

**Farm** JC Wells #6

**15' Quad** \_\_\_\_\_  
**(sec.)**


**7.5' Quad** Tiltonville

**District** Buffalo

**WELL LOCATION PLAT**

**County** 009 **Permit** 30063

M

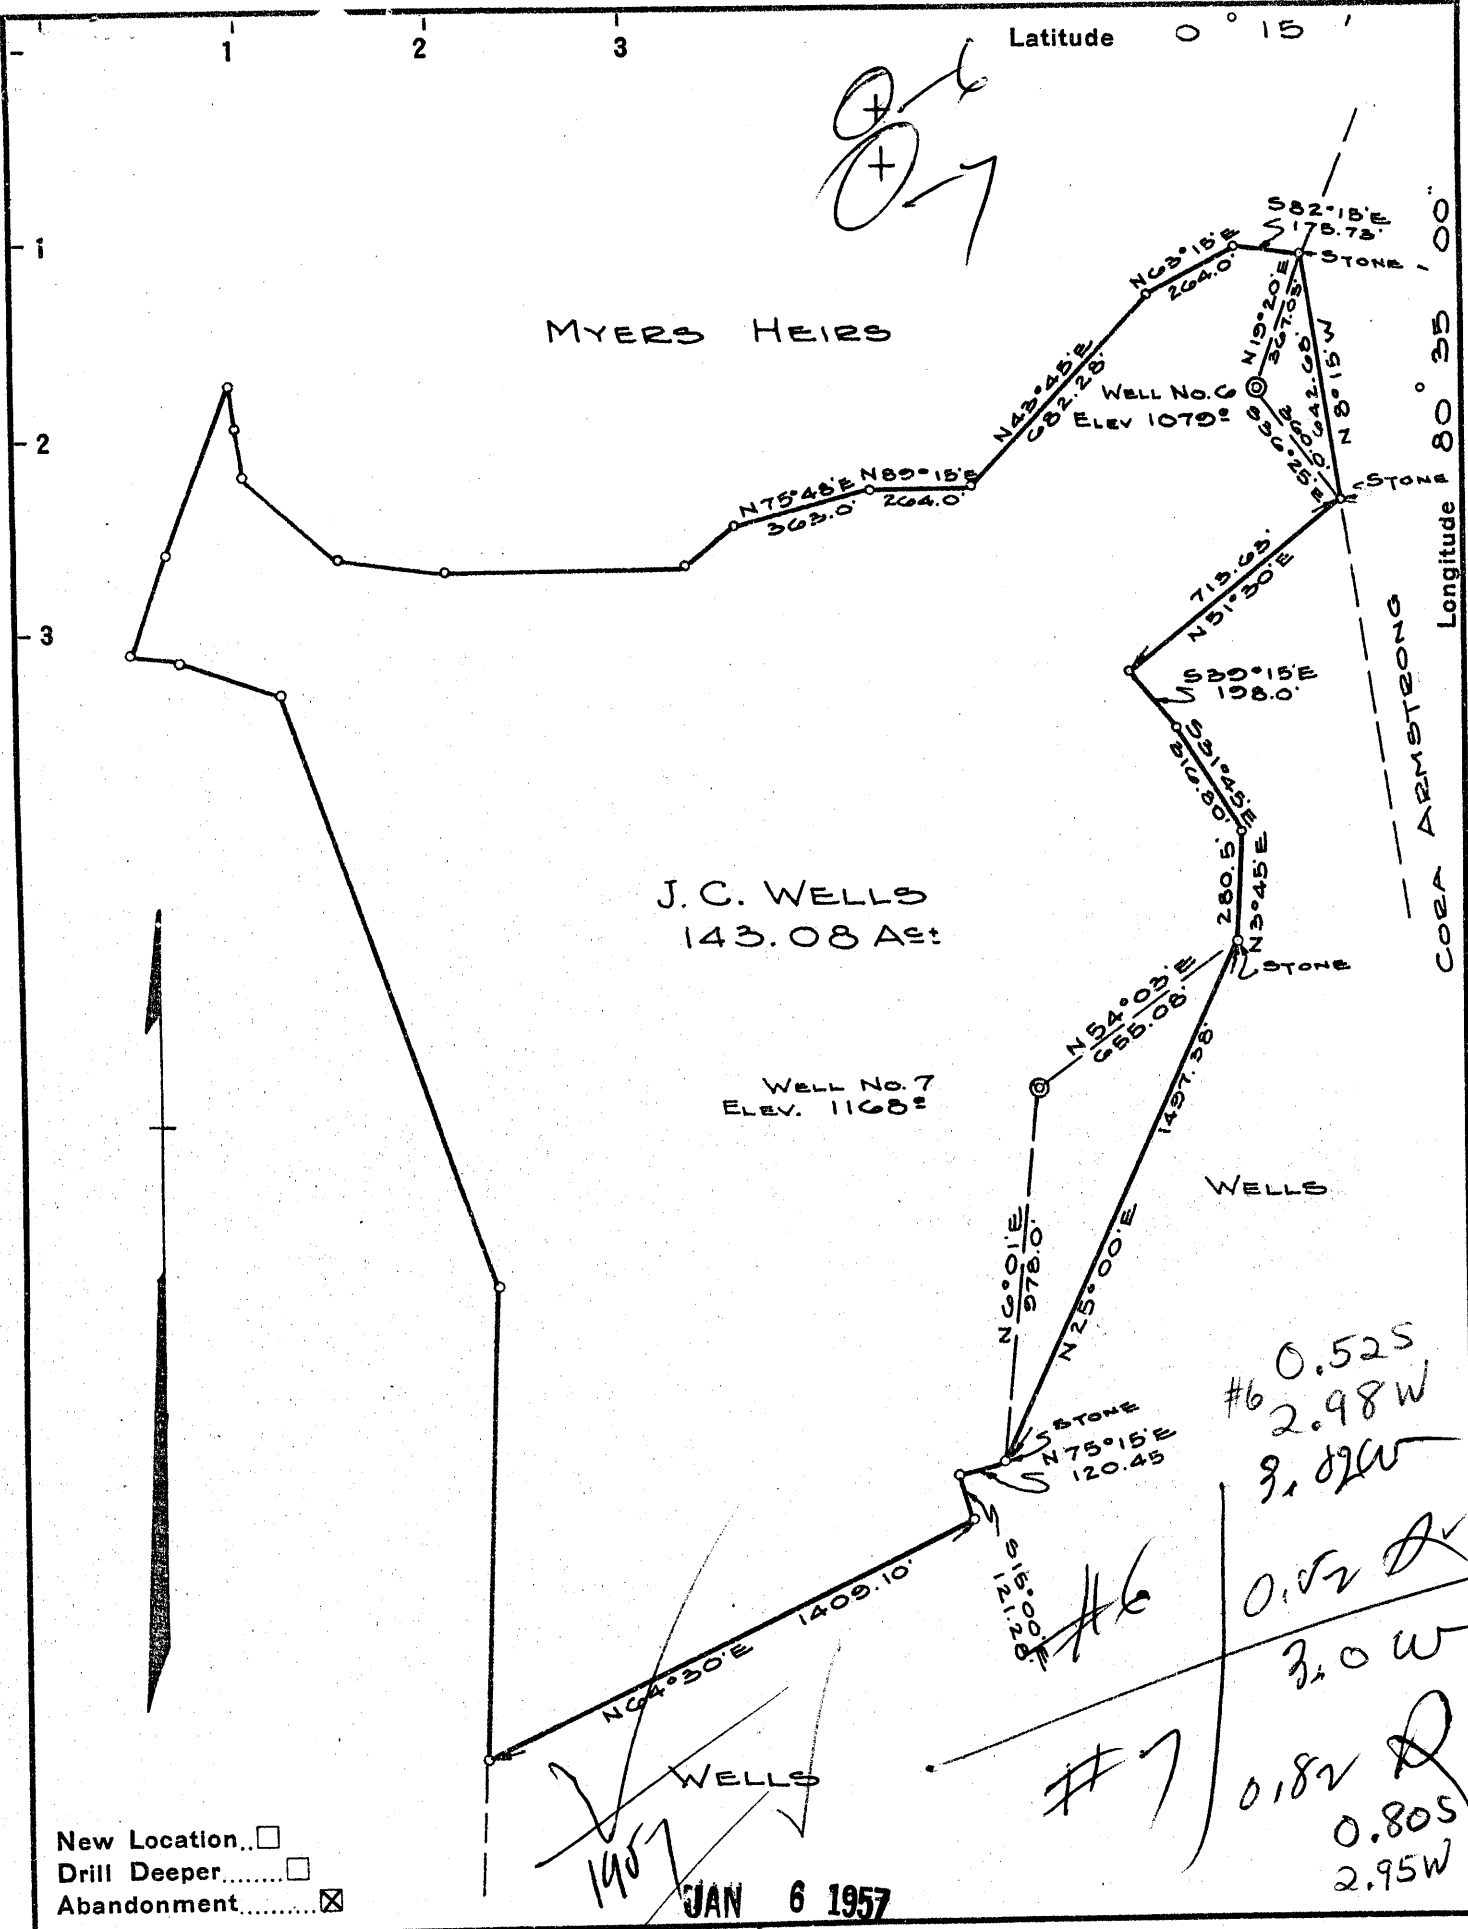

#6 0.52S  
2.98W  
9.82W

#7 0.52S  
3.0W  
0.82S  
2.95W

Company ARTHUR R. ELIKAN

Address 3 LINDEN AVE, WHEELING, W.VA

Farm J.C. WELLS

Tract \_\_\_\_\_ Acres 143.08 Lease No. 1

Well (Farm) No. 6 & 7 Serial No. \_\_\_\_\_

Elevation (Spirit Level) 1079 & 1168

Quadrangle WHEELING

County BROOKE District BUFFALO

Engineer N. JAMES SCHELLHASE

Engineer's Registration No. 1673

File No. \_\_\_\_\_ Drawing No. \_\_\_\_\_

Date 12-10-57 Scale 1 IN. = 500 FT.

STATE OF WEST VIRGINIA  
DEPARTMENT OF MINES  
OIL AND GAS DIVISION  
CHARLESTON

WELL LOCATION MAP  
FILE NO. BRO-63-A-#6  
BRO-64-A-#7

+ Denotes location of well on United States Topographic Maps, scale 1 to 62,500, latitude and longitude lines being represented by border lines as shown.

- Denotes one inch spaces on border line of original tracing.

J.C. WELLS Nos. 6 & 7 - ARTHUR R. ELIKAN - BRO-63-64-A

X

Buffalo District, Brooke County, W. Va.  
 Marshall Oil Co.  
 Beach Bottom pool, on hill, back from Ohio River.  
 Wells tract adjoins Cox Armstrong tract to west.

	Well No.		Berea Sand.
1. 2.47	1		1689
2. 2.48	2		1838
3. 2.49	3		1731
4. 2.50	4		1738 1/2
5. 2.51	5		1689
6. 2.52	6	now 63A	1689
7. 2.53	7	now 64A	1820