Longitude

_						
L		•	ı	٠	d	
_	•				•	•

2.335 .63W

~ Tope Location

7.5' Loc.______ 15' Loc._____ (calc.)

Company Brook-Mar Oil Corp


Farm Wheeling Stoop Corp#21

7.5' Quad Steutenvillo East

District Coss Gook

WELL LOCATION PLAT

County 009 Permit 30067

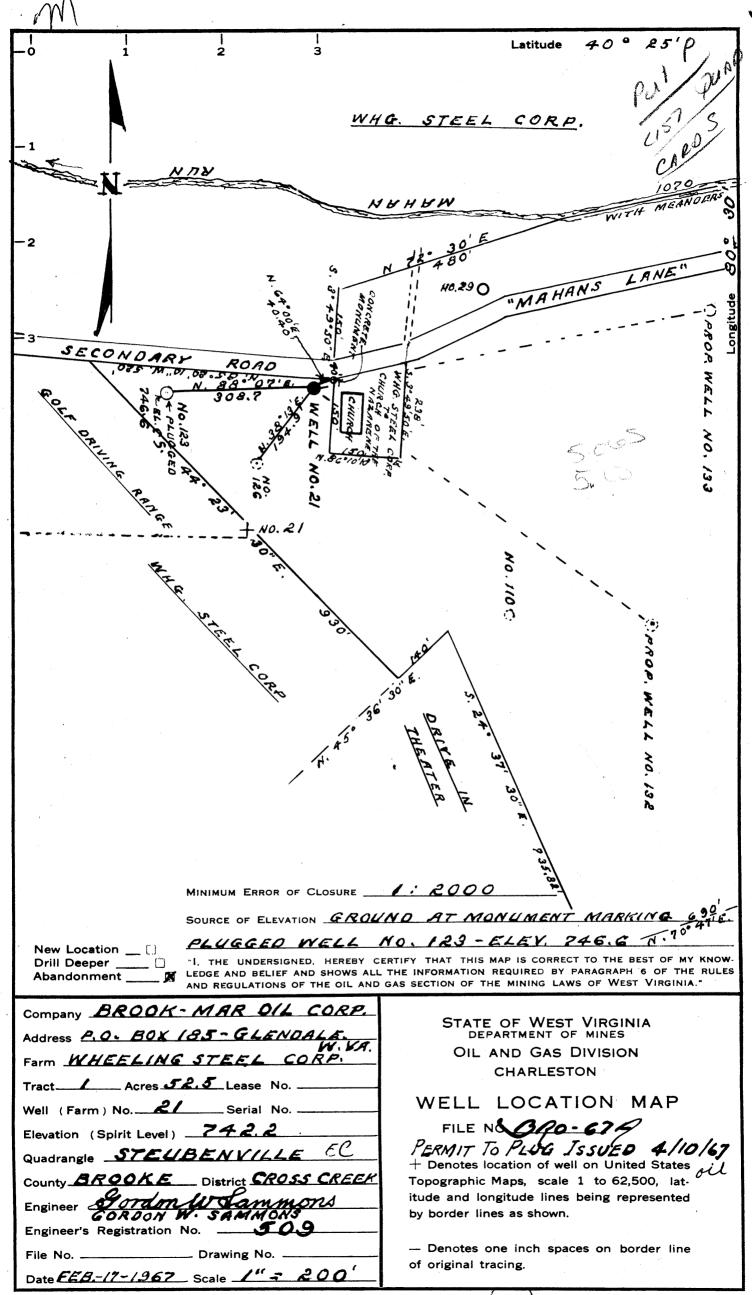

Stephens Blueprint and Supply Company - Parkersburg, W. Virginia 6-6

(011)